THOSE PORTIONS OF THIS DRAWING WHICH ARE COLORED CYAN INDICATE THAT THE COLORED ITEM IS SUBJECT TO AGING MANAGEMENT REVIEW

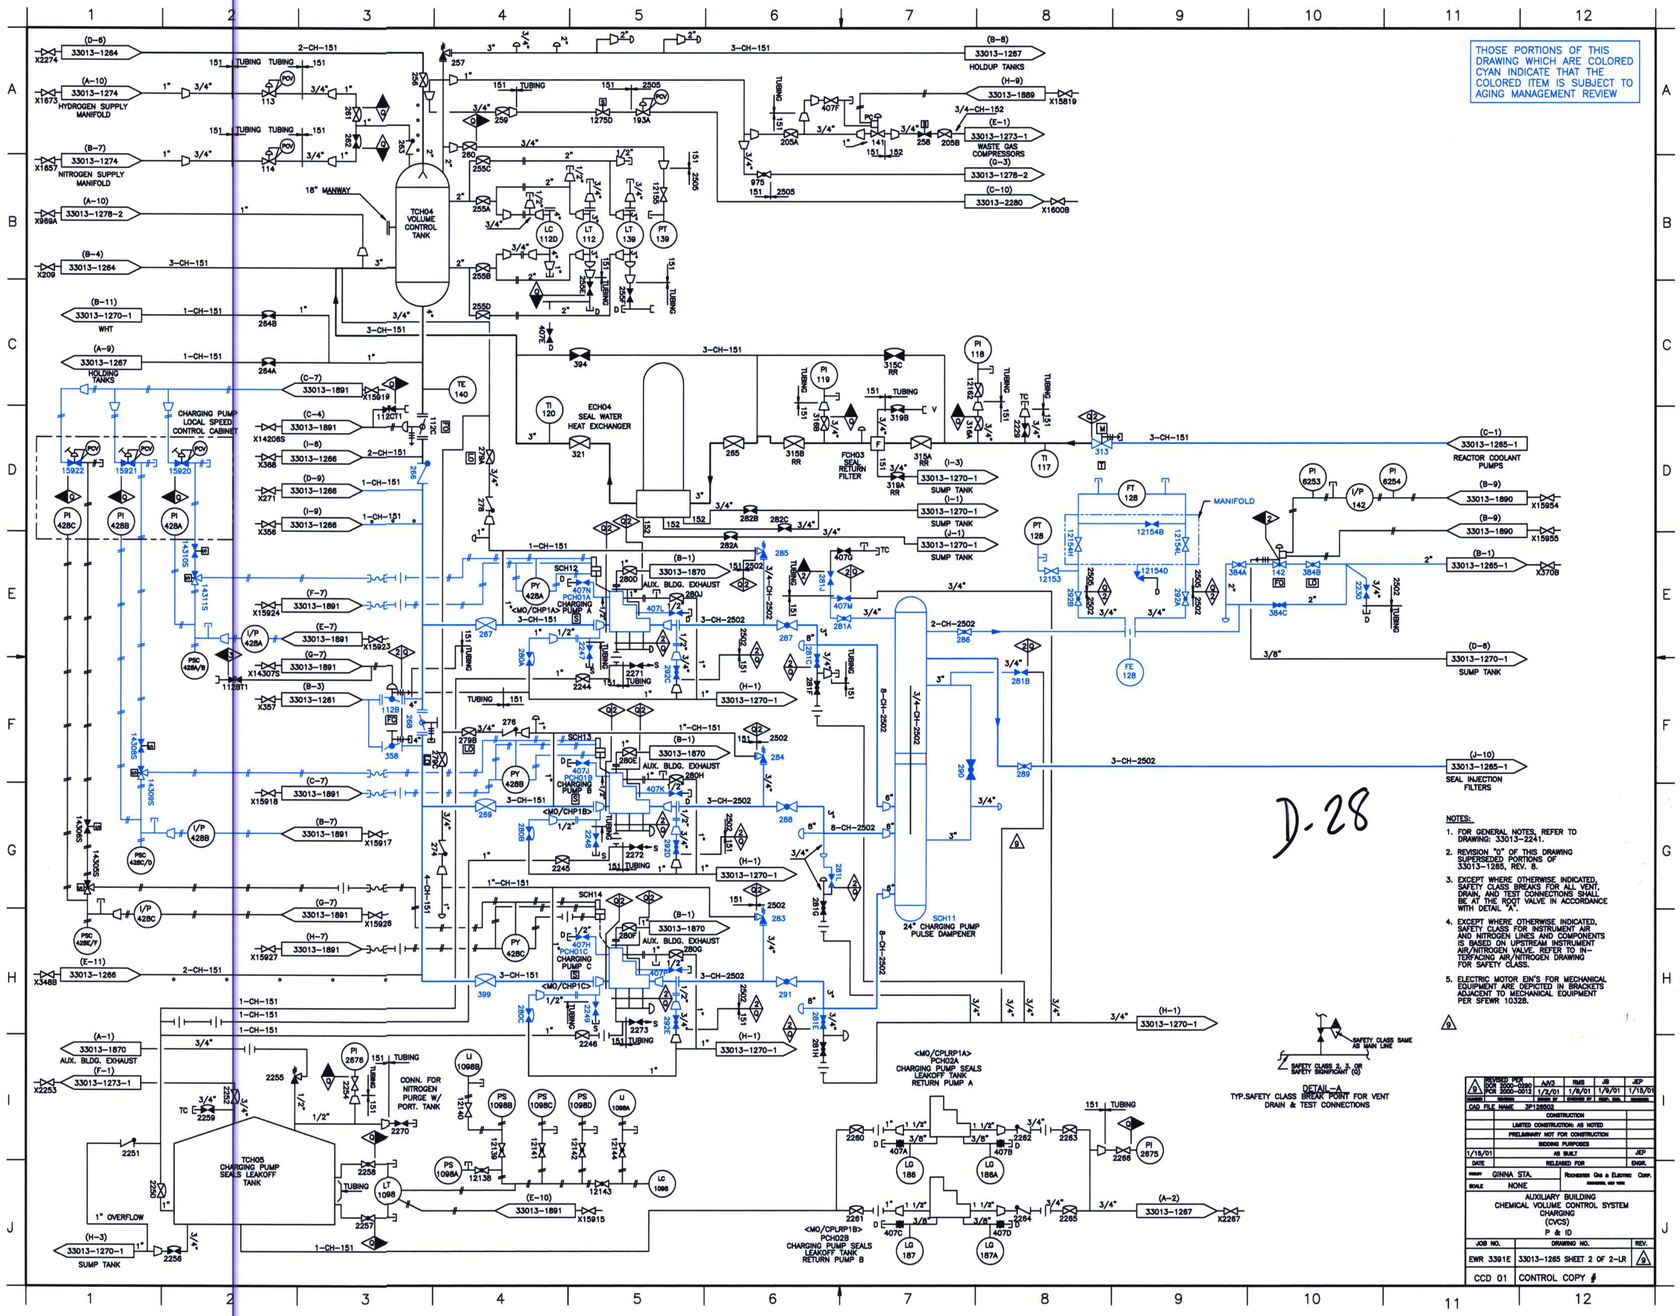

NOTES:

1. FOR GENERAL NOTES, REFER TO DRAWING: 33013-2241.
2. REVISION "0" OF THIS DRAWING SUPERSEDES PORTIONS OF 33013-1285, REV. 8.
3. EXCEPT WHERE OTHERWISE INDICATED, SAFETY CLASS BREAKS FOR ALL VENT, DRAIN, AND TEST CONNECTIONS SHALL BE AT THE ROOT VALVE IN ACCORDANCE WITH DETAIL "A".
4. EXCEPT WHERE OTHERWISE INDICATED, SAFETY CLASS FOR INSTRUMENT AIR AND NITROGEN LINES AND COMPONENTS IS BASED ON UPSTREAM INSTRUMENT AIR/NITROGEN VALVE. REFER TO INTERFACING AIR/NITROGEN DRAWING FOR SAFETY CLASS.
5. ELECTRIC MOTOR EIN'S FOR MECHANICAL EQUIPMENT ARE DEPICTED IN BRACKETS ADJACENT TO MECHANICAL EQUIPMENT PER SFEWR 10328.

2	REVISED PER PCR 2000-0290	A/G	RMS	JB	JEP
1	PCR 2000-0012	1/3/01	1/8/01	1/9/01	1/15/01
REVISION	DESCRIPTION	DRAWN BY	CHECKED BY	DATE	APPROVED BY

CAD FILE NAME: 3P128002

	CONSTRUCTION	
	LIMITED CONSTRUCTION: AS NOTED	
	PRELIMINARY NOT FOR CONSTRUCTION	
	BIDDING PURPOSES	
1/15/01	AS BUILT	JEP
DATE	RELEASED FOR	ENGR.

DRAWN: GINNA STA. — ROCHESTER GAS & ELECTRIC CORP. ROCHESTER, NEW YORK

SCALE: NONE

AUXILIARY BUILDING
CHEMICAL VOLUME CONTROL SYSTEM
CHARGING
(CVCS)
P & ID

JOB NO.	DRAWING NO.	REV.
EWR 3391E	33013-1265 SHEET 2 OF 2-LR	2
CCD 01	CONTROL COPY #	