THOSE PORTIONS OF THIS DRAWING WHICH ARE COLORED CYAN INDICATE THAT THE COLORED ITEM IS SUBJECT TO AGING MANAGEMENT REVIEW

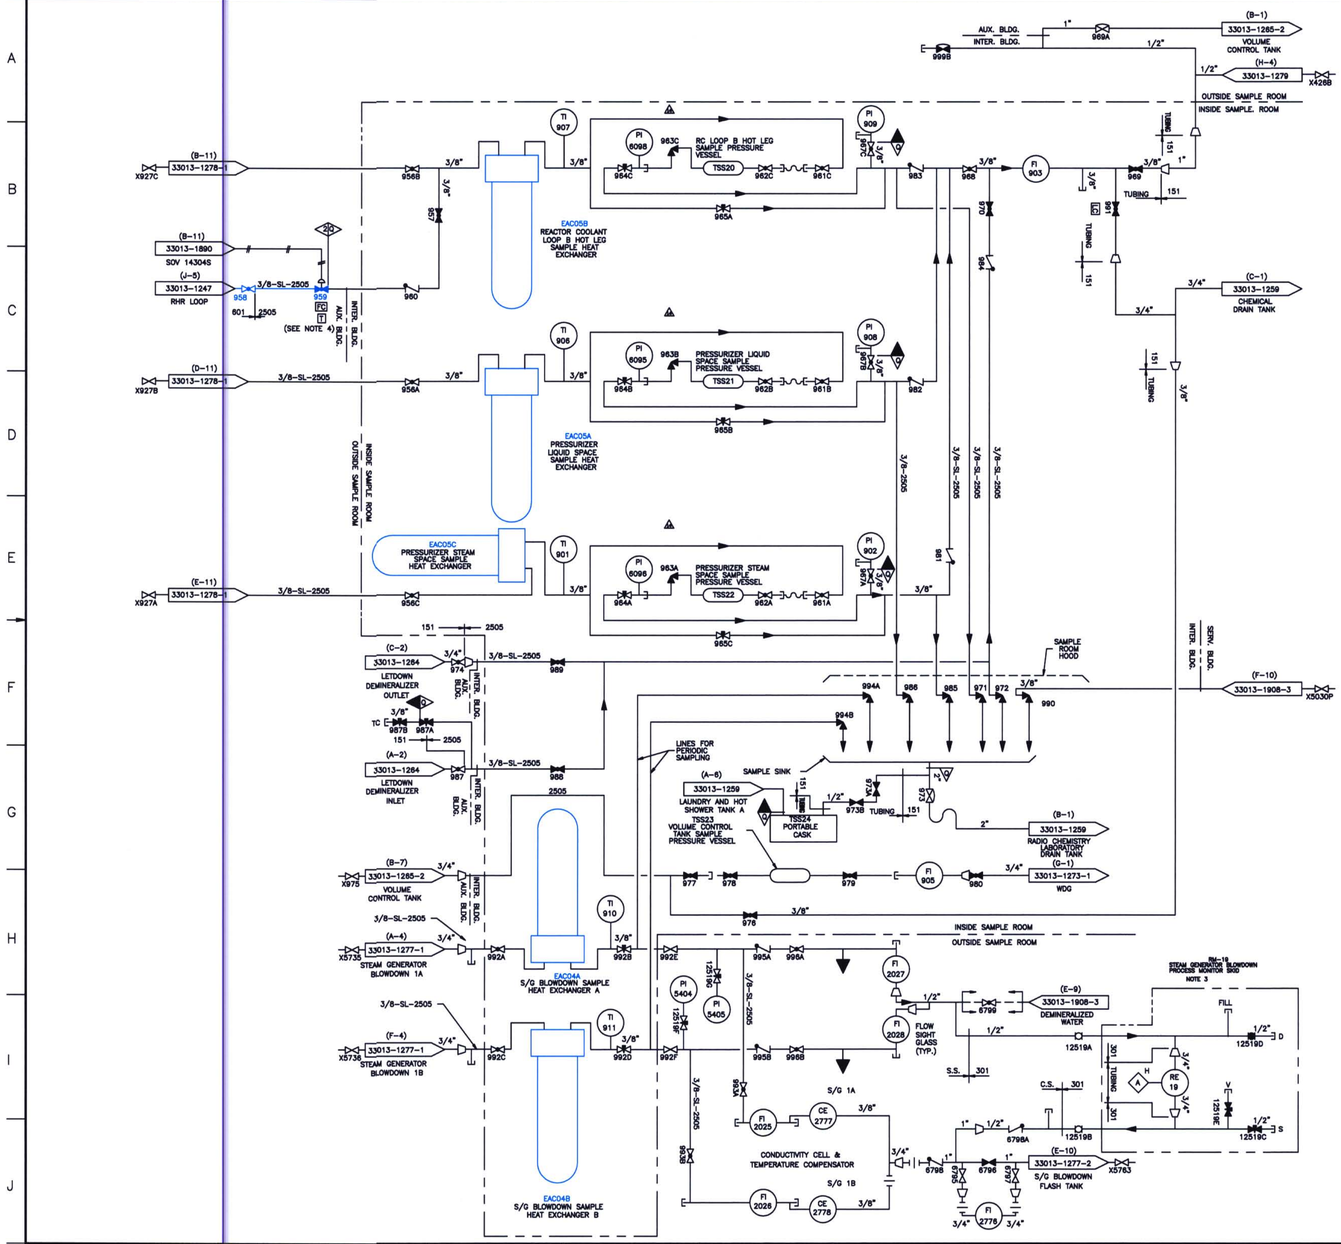


D-42

NOTES:

1. FOR GENERAL NOTES SEE DRAWING 33013-2241.
2. THIS DRAWING SUPERSEDES PORTIONS OF DRAWING 33013-1278 REV. 9.
3. RM-19 AND RE-19 COMBINE TO PERFORM A SAFETY SIGNIFICANT DETECTION FUNCTION.
4. AOV 959 IS NORMALLY DE-ENERGIZED (FUSES PULLED) AT POWER.

| REVISED PER DCR 96-0125 | DWD 8/10/96 | A*B 8/12/96 | A*B 8/12/96 | APB 8/13/96 |
|---|---|---|---|---|
| CAD FILE NAME JP127802 | | | | |

CONSTRUCTION
LIMITED CONSTRUCTION AS NOTED
PRELIMINARY NOT FOR CONSTRUCTION
BIDDING PURPOSES
AS BUILT

DATE | RELEASED FOR | ENGR.

DRAWN GINNA STA. | ROCHESTER GAS & ELECTRIC CORP.
SCALE NONE

NUCLEAR SAMPLING (SS) P&ID

| JOB NO. | DRAWING NO. | REV. |
|---|---|---|
| EWR 3391E | 33013-1278 SHEET 2 OF 2-LR | 4 |

CCD 01 | CONTROL COPY #