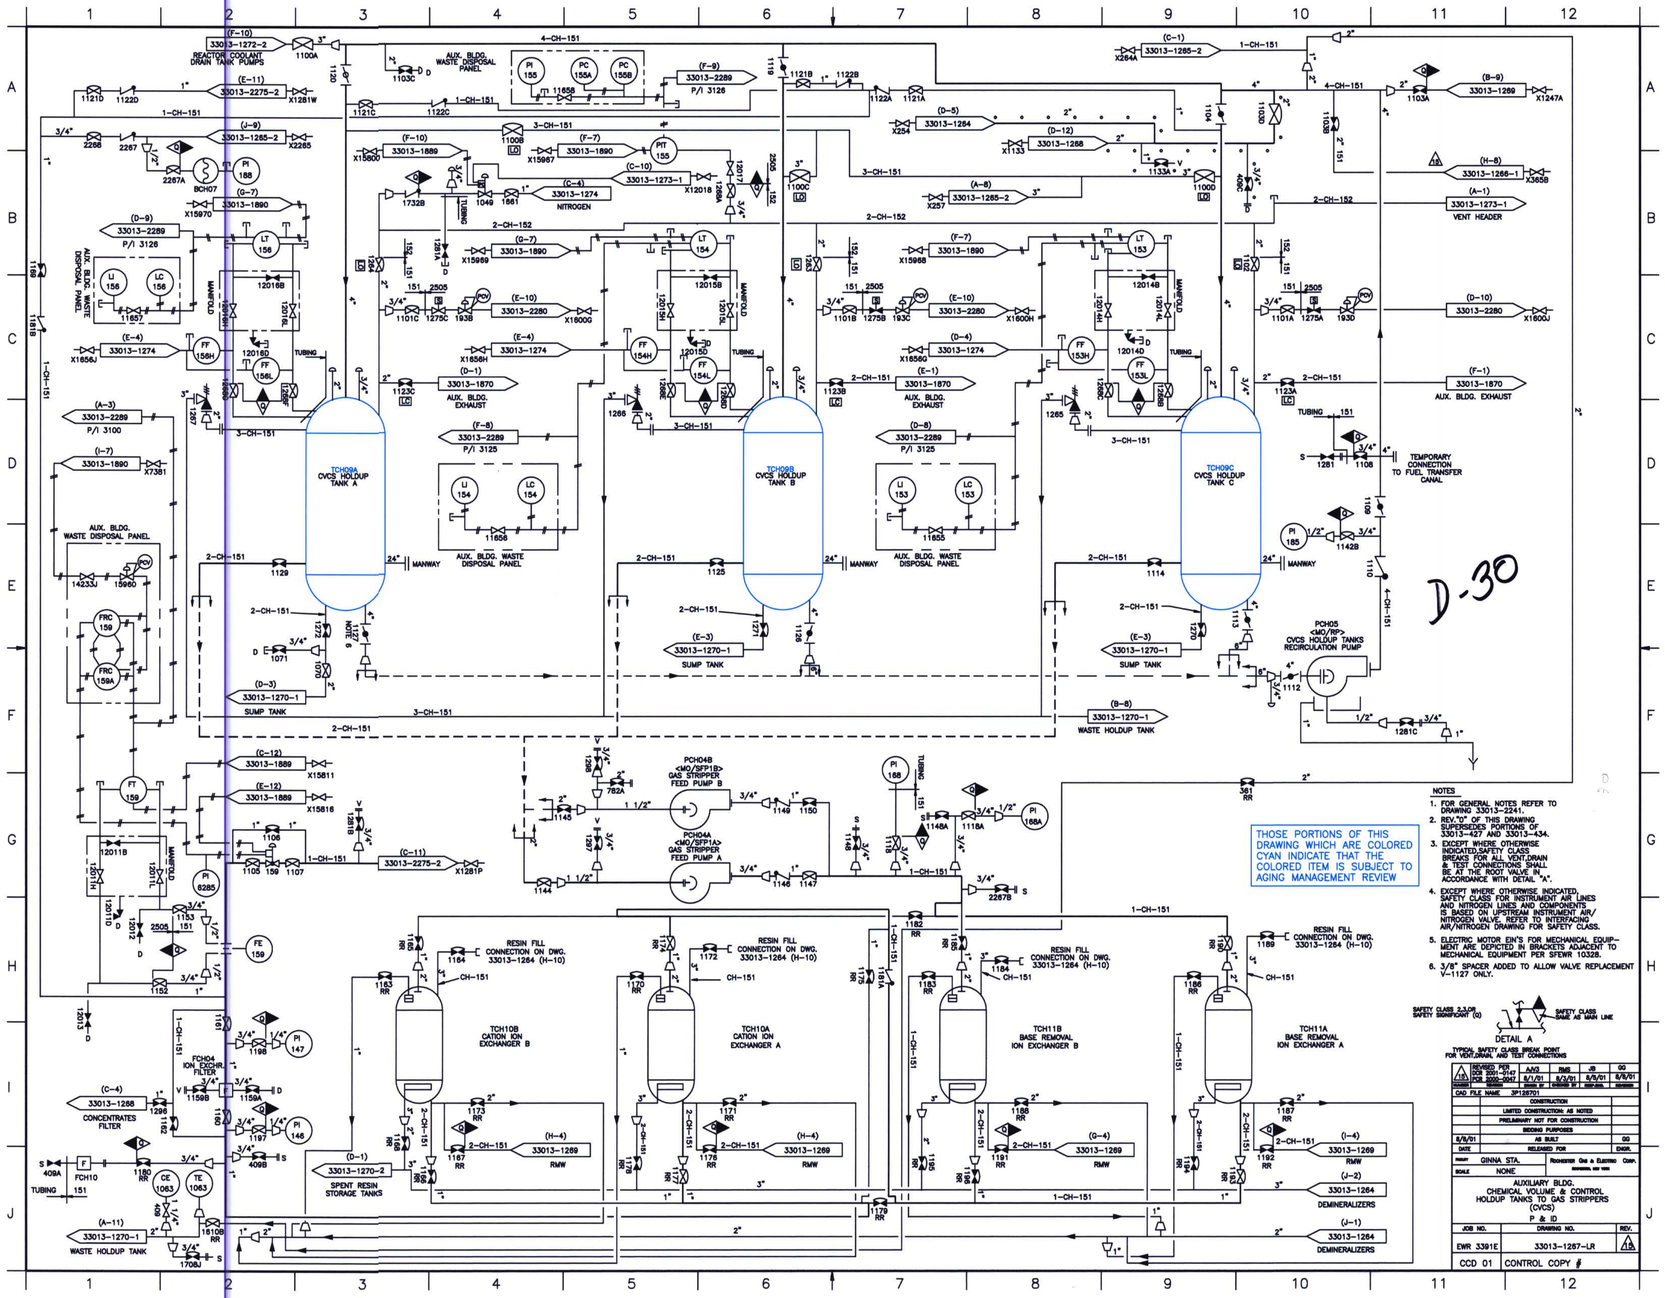
TCH09A CVCS HOLDUP TANK A
TCH09B CVCS HOLDUP TANK B
TCH09C CVCS HOLDUP TANK C
PCH05 <MO/RP> CVCS HOLDUP TANKS RECIRCULATION PUMP
PCH04B <MO/SFP1B> GAS STRIPPER FEED PUMP B
PCH04A <MO/SFP1A> GAS STRIPPER FEED PUMP A
TCH10B CATION ION EXCHANGER B
TCH10A CATION ION EXCHANGER A
TCH11B BASE REMOVAL ION EXCHANGER B
TCH11A BASE REMOVAL ION EXCHANGER A
FCH04 ION EXCHR. FILTER
REACTOR COOLANT DRAIN TANK PUMPS
AUX. BLDG. WASTE DISPOSAL PANEL
NITROGEN
VENT HEADER
AUX. BLDG. EXHAUST
TEMPORARY CONNECTION TO FUEL TRANSFER CANAL
SUMP TANK
WASTE HOLDUP TANK
CONCENTRATES FILTER
SPENT RESIN STORAGE TANKS
RESIN FILL CONNECTION ON DWG. 33013-1264 (H-10)
DEMINERALIZERS
D-30
THOSE PORTIONS OF THIS DRAWING WHICH ARE COLORED CYAN INDICATE THAT THE COLORED ITEM IS SUBJECT TO AGING MANAGEMENT REVIEW
NOTES
1. FOR GENERAL NOTES REFER TO DRAWING 33013-2241.
2. REV."D" OF THIS DRAWING SUPERSEDES PORTIONS OF 33013-427 AND 33013-434.
3. EXCEPT WHERE OTHERWISE INDICATED,SAFETY CLASS BREAKS FOR ALL VENT/DRAIN & TEST CONNECTIONS SHALL BE AT THE ROOT VALVE IN ACCORDANCE WITH DETAIL "A".
4. EXCEPT WHERE OTHERWISE INDICATED, SAFETY CLASS FOR INSTRUMENT AIR LINES AND NITROGEN LINES AND COMPONENTS IS BASED ON UPSTREAM INSTRUMENT AIR/ NITROGEN VALVE. REFER TO INTERFACING AIR/NITROGEN DRAWING FOR SAFETY CLASS.
5. ELECTRIC MOTOR EIN'S FOR MECHANICAL EQUIP- MENT ARE DEPICTED IN BRACKETS ADJACENT TO MECHANICAL EQUIPMENT PER SFEWR 10328.
6. 3/8" SPACER ADDED TO ALLOW VALVE REPLACEMENT V-1127 ONLY.
SAFETY CLASS 2,3,OR SAFETY SIGNIFICANT (G)
SAFETY CLASS SAME AS MAIN LINE
DETAIL A
TYPICAL SAFETY CLASS BREAK POINT FOR VENT,DRAIN, AND TEST CONNECTIONS
REVISED PER DCR 2001-0047 / DCR 2000-0047 — A/KG — BMB — JB — GG — 8/1/01 — 8/3/01 — 8/8/01 — 8/8/01
CAD FILE NAME: 3P13270I
CONSTRUCTION
LIMITED CONSTRUCTION, AS NOTED
PRELIMINARY NOT FOR CONSTRUCTION
BIDDING PURPOSES
8/8/01 — AS BUILT — GG
DATE — RELEASED FOR — ENGR.
DRAWN: GINNA STA.
ROCHESTER Gas & ELECTRIC CORP.
SCALE: NONE
AUXILIARY BLDG. CHEMICAL VOLUME & CONTROL HOLDUP TANKS TO GAS STRIPPERS (CVCS) P & ID
JOB NO. — DRAWING NO. — REV.
EWR 3391E — 33013-1287-LR
CCD 01 — CONTROL COPY #