THOSE PORTIONS OF THIS DRAWING WHICH ARE COLORED CYAN INDICATE THAT THE COLORED ITEM IS SUBJECT TO AGING MANAGEMENT REVIEW

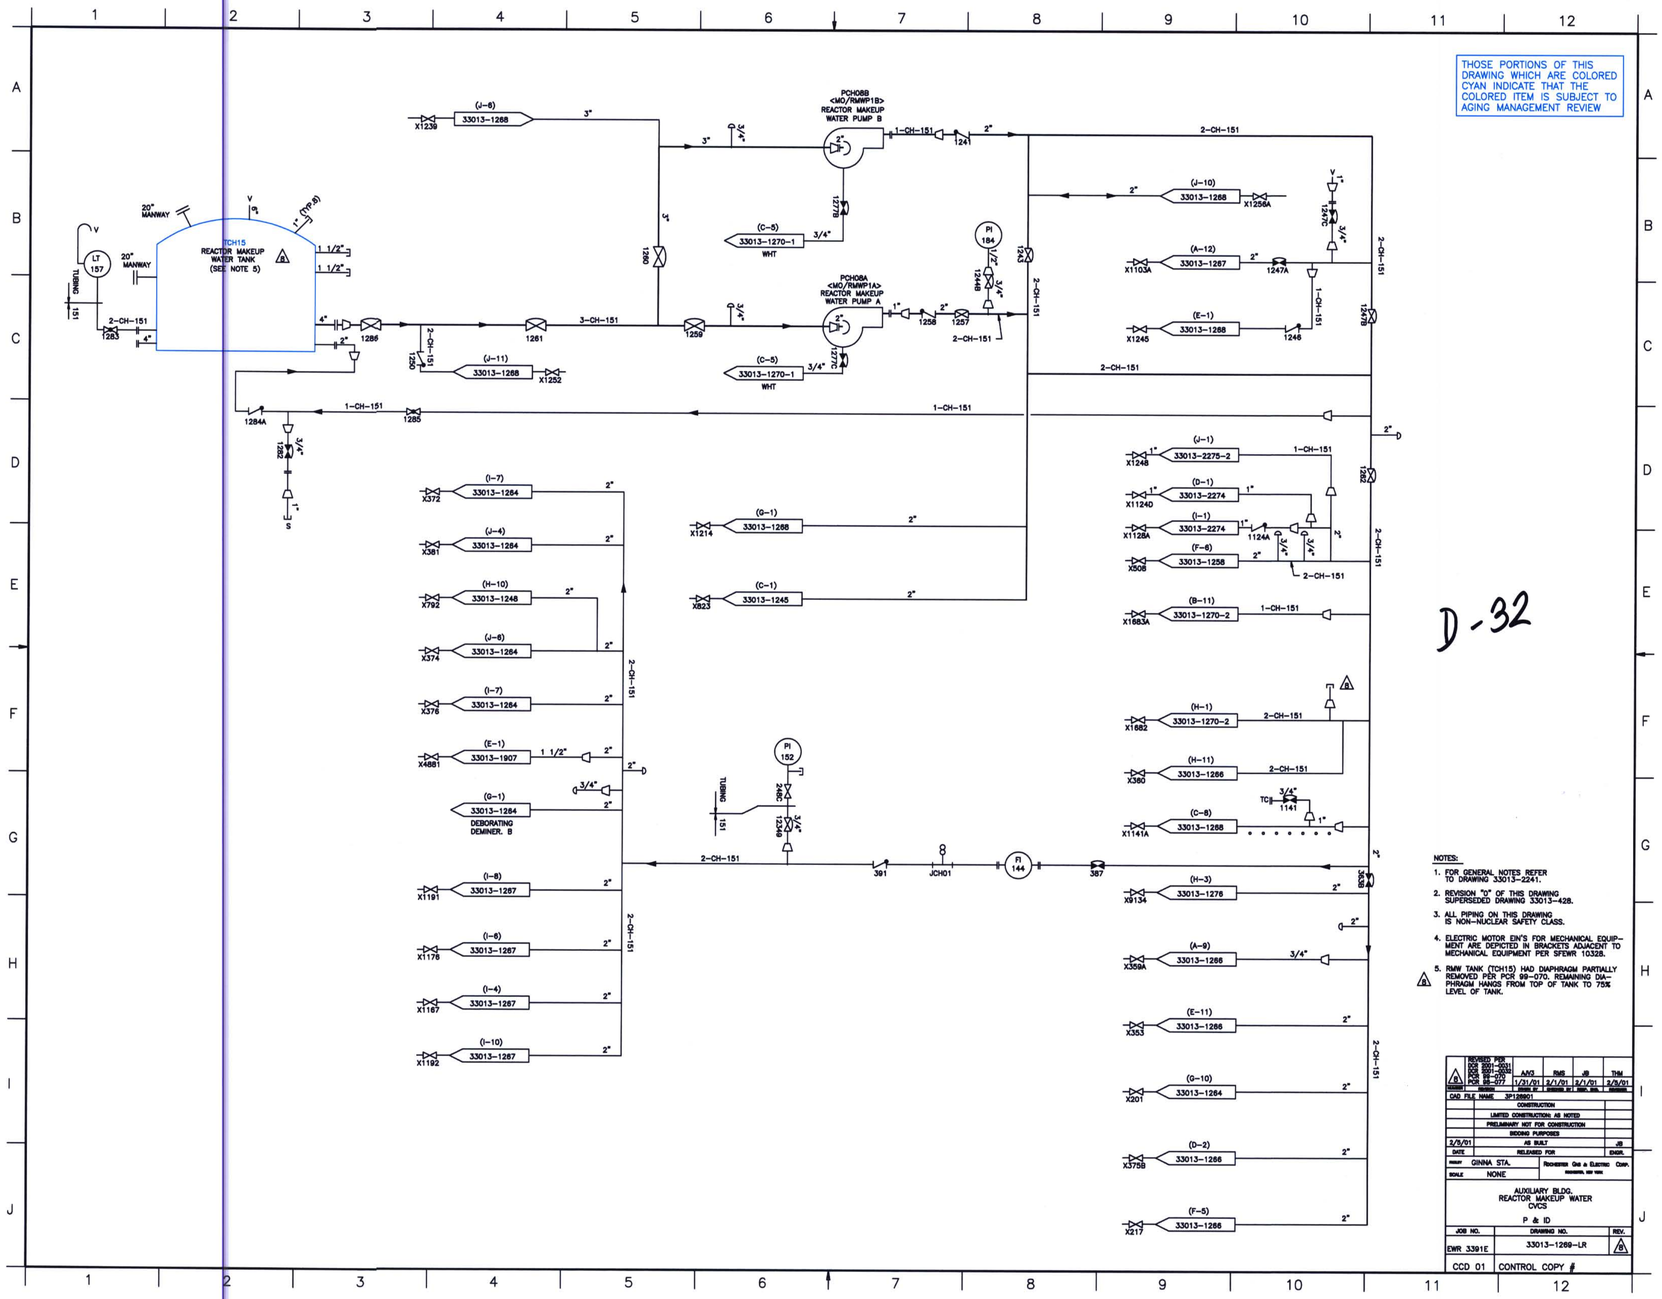

NOTES:

1. FOR GENERAL NOTES REFER TO DRAWING 33013-2241.
2. REVISION "D" OF THIS DRAWING SUPERSEDED DRAWING 33013-428.
3. ALL PIPING ON THIS DRAWING IS NON-NUCLEAR SAFETY CLASS.
4. ELECTRIC MOTOR EIN'S FOR MECHANICAL EQUIPMENT ARE DEPICTED IN BRACKETS ADJACENT TO MECHANICAL EQUIPMENT PER SFEWR 10328.
5. RMW TANK (TCH15) HAD DIAPHRAGM PARTIALLY REMOVED PER PCR 99-070. REMAINING DIAPHRAGM HANGS FROM TOP OF TANK TO 75% LEVEL OF TANK.

REVISED PER				
PCR 90-0031				
PCR 92-0033				
PCR 95-0070	AJG	RMS	JB	TJM
PCR 95-077	1/31/01	2/1/01	2/1/01	2/8/01
REVISED BY	DRAWN BY	DESIGN BY	DESIGN SUP	DESIGN ENG.

CAD FILE NAME 3P126901

CONSTRUCTION	
LIMITED CONSTRUCTION AS NOTED	
PRELIMINARY NOT FOR CONSTRUCTION	
BIDDING PURPOSES	
2/8/01	AS BUILT	JB
DATE	RELEASED FOR	ENGR.

PROJECT GINNA STA. — ROCHESTER GAS & ELECTRIC CORP. ROCHESTER, NEW YORK

SCALE NONE

AUXILIARY BLDG.
REACTOR MAKEUP WATER
CVCS
P & ID

JOB NO.	DRAWING NO.	REV.
EWR 3391E	33013-1269-LR	D

CCD 01 CONTROL COPY #