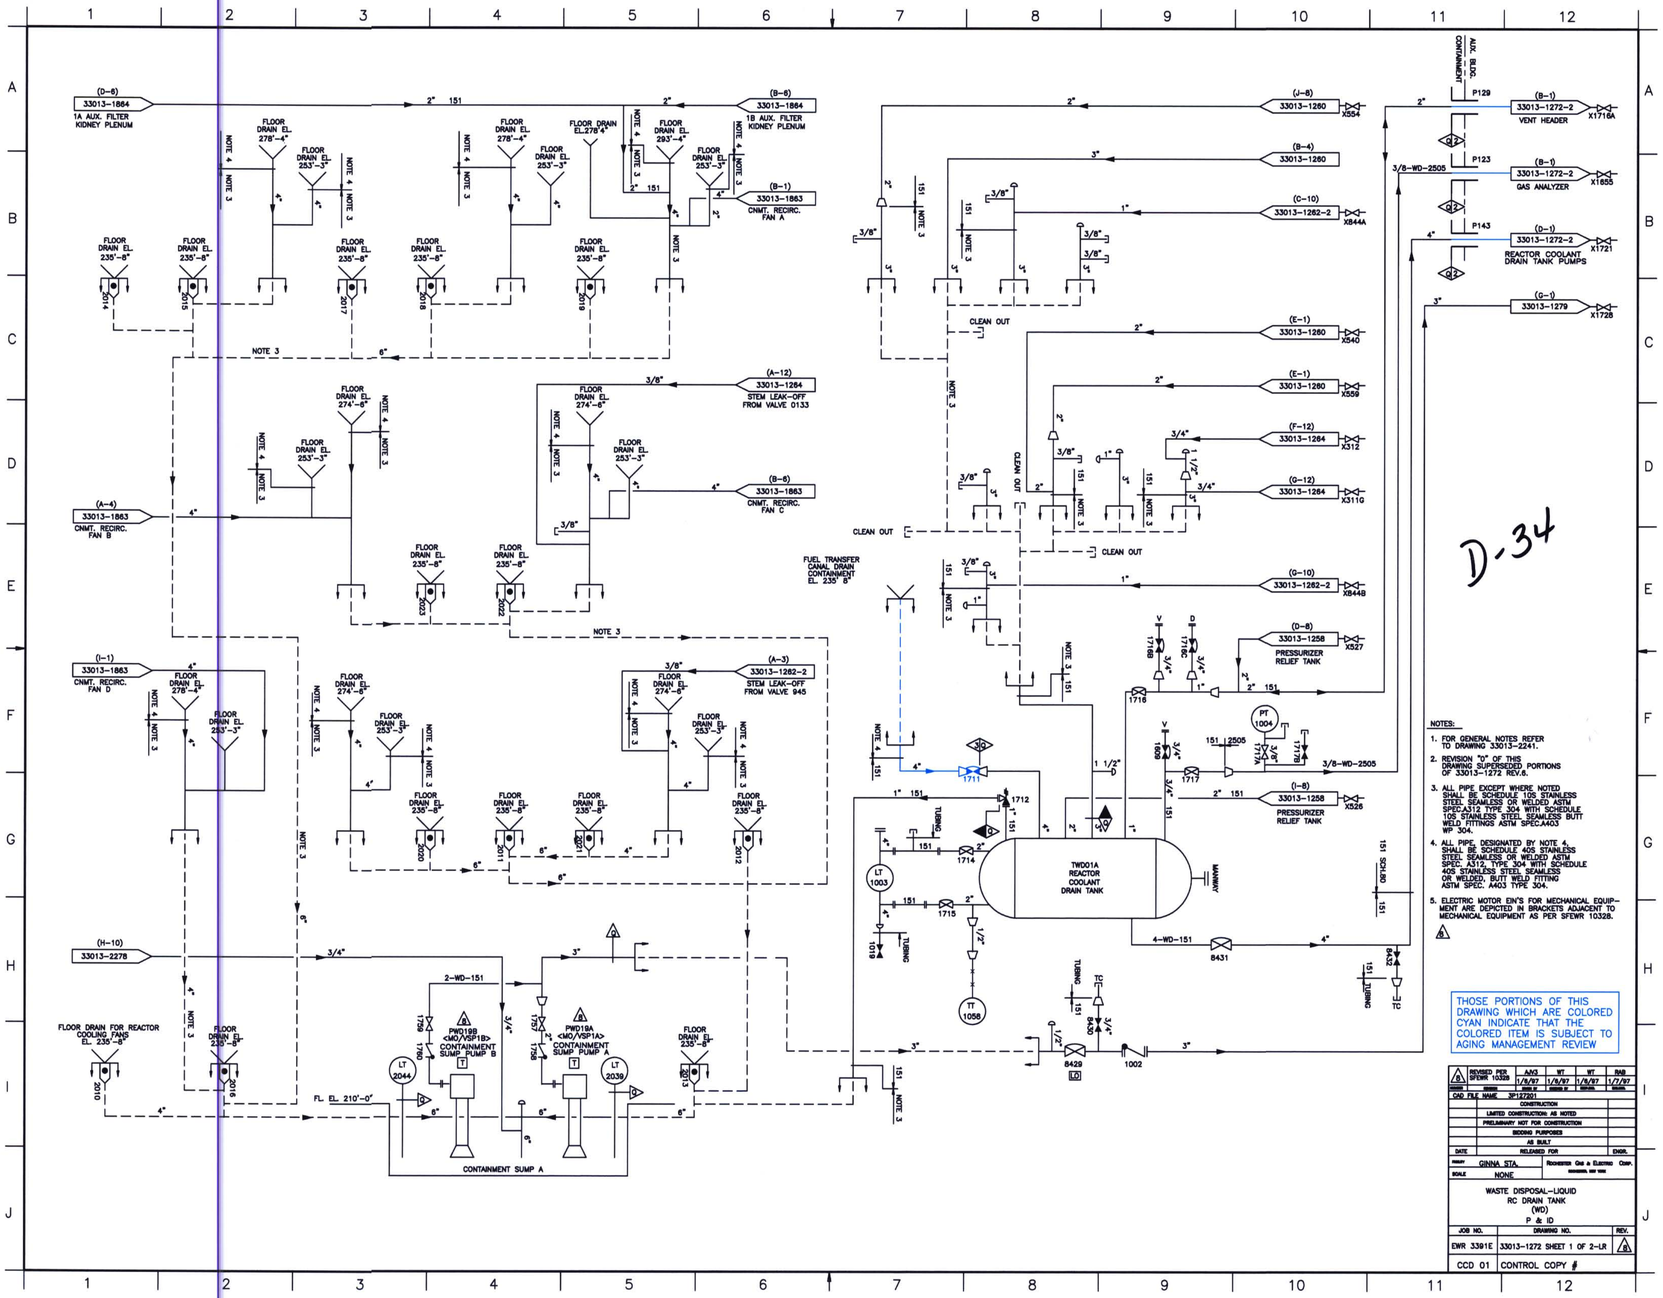
(D-8)
33013-1864
1A AUX. FILTER KIDNEY PLENUM
(B-8)
33013-1864
1B AUX. FILTER KIDNEY PLENUM
(B-1)
33013-1863
CNMT. RECIRC. FAN A
(A-12)
33013-1264
STEM LEAK-OFF FROM VALVE 0133
(B-6)
33013-1863
CNMT. RECIRC. FAN C
(A-4)
33013-1863
CNMT. RECIRC. FAN B
(I-1)
33013-1863
CNMT. RECIRC. FAN D
(A-3)
33013-1262-2
STEM LEAK-OFF FROM VALVE 945
(H-10)
33013-2278
FLOOR DRAIN FOR REACTOR COOLING FANS EL. 235'-8"
FLOOR DRAIN EL. 235'-8"
FLOOR DRAIN EL. 253'-3"
FLOOR DRAIN EL. 274'-6"
FLOOR DRAIN EL. 278'-4"
FLOOR DRAIN EL. 293'-4"
FLOOR DRAIN EL.278'-4"
NOTE 3
NOTE 4
FL. EL. 210'-0"
CONTAINMENT SUMP A
PW019B <MO/VSP1B> CONTAINMENT SUMP PUMP B
PW019A <MO/VSP1A> CONTAINMENT SUMP PUMP A
LT 2044
LT 2036
2-WD-151
(J-8)
33013-1260
X554
(B-4)
33013-1260
(C-10)
33013-1262-2
X844A
(E-1)
33013-1260
X540
X559
(F-12)
33013-1264
X312
(G-12)
33013-1264
X311G
(G-10)
33013-1262-2
X844B
(D-8)
33013-1258
PRESSURIZER RELIEF TANK
X527
(I-8)
33013-1258
PRESSURIZER RELIEF TANK
X526
CLEAN OUT
FUEL TRANSFER CANAL DRAIN CONTAINMENT EL. 235' 8"
TWD01A REACTOR COOLANT DRAIN TANK
MANWAY
LT 1003
TT 1058
PT 1004
3/8-WD-2505
4-WD-151
AUX. BLDG. CONTAINMENT
P129
P123
P143
(B-1)
33013-1272-2
VENT HEADER
X1716A
GAS ANALYZER
X1655
(D-1)
REACTOR COOLANT DRAIN TANK PUMPS
X1721
(G-1)
33013-1279
X1726
D-34
NOTES:
1. FOR GENERAL NOTES REFER TO DRAWING 33013-2241.
2. REVISION "0" OF THIS DRAWING SUPERSEDED PORTIONS OF 33013-1272 REV.6.
3. ALL PIPE EXCEPT WHERE NOTED SHALL BE SCHEDULE 10S STAINLESS STEEL SEAMLESS OR WELDED ASTM SPEC.A312 TYPE 304 WITH SCHEDULE 10S STAINLESS STEEL SEAMLESS BUTT WELD FITTINGS ASTM SPEC.A403 WP 304.
4. ALL PIPE, DESIGNATED BY NOTE 4, SHALL BE SCHEDULE 40S STAINLESS STEEL SEAMLESS OR WELDED ASTM SPEC. A312, TYPE 304 WITH SCHEDULE 40S STAINLESS STEEL SEAMLESS OR WELDED, BUTT WELD FITTING ASTM SPEC. A403 TYPE 304.
5. ELECTRIC MOTOR EIN'S FOR MECHANICAL EQUIPMENT ARE DEPICTED IN BRACKETS ADJACENT TO MECHANICAL EQUIPMENT AS PER SFEWR 10328.
THOSE PORTIONS OF THIS DRAWING WHICH ARE COLORED CYAN INDICATE THAT THE COLORED ITEM IS SUBJECT TO AGING MANAGEMENT REVIEW
REVISED PER SFEWR 10328
A403
WT
WT
RAB
CAD FILE NAME 3P13272D1
CONSTRUCTION
LIMITED CONSTRUCTION AS NOTED
PRELIMINARY NOT FOR CONSTRUCTION
BIDDING PURPOSES
AS BUILT
DATE
RELEASED FOR
ENGR.
GINNA STA.
ROCHESTER GAS & ELECTRIC CORP.
NONE
WASTE DISPOSAL-LIQUID
RC DRAIN TANK
(WD)
P & ID
JOB NO.
DRAWING NO.
REV.
EWR 3391E
33013-1272 SHEET 1 OF 2-LR
CCD 01
CONTROL COPY