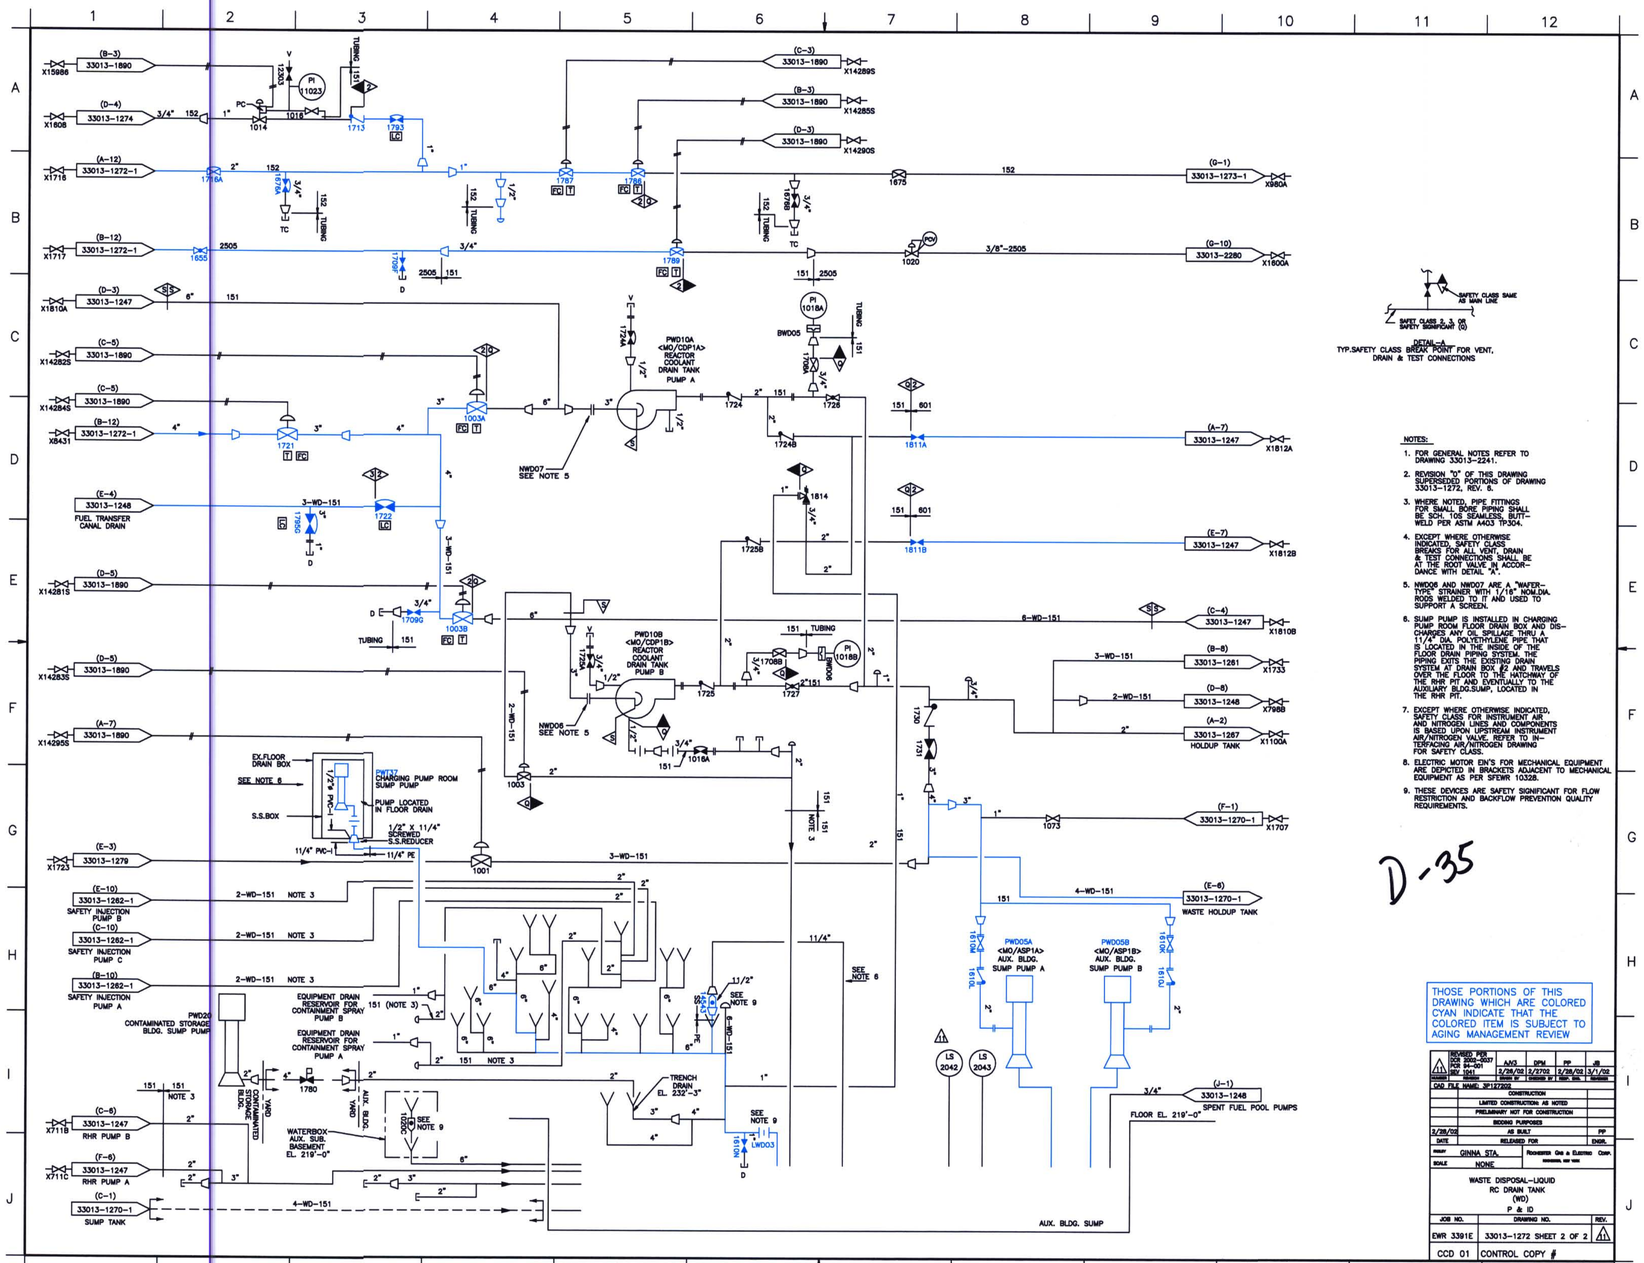

NOTES:

1. FOR GENERAL NOTES REFER TO DRAWING 33013-2241.
2. REVISION "G" OF THIS DRAWING SUPERSEDED PORTIONS OF DRAWING 33013-1272, REV. 8.
3. WHERE NOTED, PIPE FITTINGS FOR SMALL BORE PIPING SHALL BE SCH. 160 SEAMLESS BUTT-WELD PER ASTM A403 TP304.
4. EXCEPT WHERE OTHERWISE INDICATED, SAFETY CLASS BREAKS FOR ALL VENT, DRAIN & TEST CONNECTIONS SHALL BE AT THE ROOT VALVE IN ACCORDANCE WITH DETAIL "A".
5. NWD06 AND NWD07 ARE A "WAFER-TYPE" STRAINER WITH 1/16" NOM.DIA. RODS WELDED TO IT AND USED TO SUPPORT A SCREEN.
6. SUMP PUMP IS INSTALLED IN CHARGING PUMP ROOM FLOOR DRAIN BOX AND DISCHARGES ANY OIL SPILLAGE THRU A 11/4" DIA. POLYETHYLENE PIPE THAT IS LOCATED IN THE INSIDE OF THE FLOOR DRAIN PIPING SYSTEM. THE PIPING EXITS THE EXISTING DRAIN SYSTEM AT DRAIN BOX #2 AND TRAVELS OVER THE FLOOR TO THE HATCHWAY OF THE RHR PIT AND EVENTUALLY TO THE AUXILIARY BLDG.SUMP, LOCATED IN THE RHR PIT.
7. EXCEPT WHERE OTHERWISE INDICATED, SAFETY CLASS FOR INSTRUMENT AIR AND NITROGEN LINES AND COMPONENTS IS BASED UPON UPSTREAM INSTRUMENT AIR/NITROGEN VALVE. REFER TO INTERFACING AIR/NITROGEN DRAWING FOR SAFETY CLASS.
8. ELECTRIC MOTOR EIN'S FOR MECHANICAL EQUIPMENT ARE DEPICTED IN BRACKETS ADJACENT TO MECHANICAL EQUIPMENT AS PER SFDWR 10328.
9. THESE DEVICES ARE SAFETY SIGNIFICANT FOR FLOW RESTRICTION AND BACKFLOW PREVENTION QUALITY REQUIREMENTS.

D-35

THOSE PORTIONS OF THIS DRAWING WHICH ARE COLORED CYAN INDICATE THAT THE COLORED ITEM IS SUBJECT TO AGING MANAGEMENT REVIEW

REVISED PER CR 2002-0537 PER 50.59	AJC	SPM	PP	
REV. 1041	2/26/02	2/27/02	2/28/02	3/1/02
CHANGE NUMBER	DRAWN BY	CHECKED BY	REV. SUP.	ENGINEER

CKD. FILE NAME: 2F1272G2

CONSTRUCTION	
LIMITED CONSTRUCTION AS NOTED	
PRELIMINARY NOT FOR CONSTRUCTION	
BIDDING PURPOSES	
AS BUILT	PP
RELEASED FOR	ENGR.

COMPANY: GINNA STA. — ROCHESTER GAS & ELECTRIC CORP. ROCHESTER, NEW YORK

SCALE: NONE

WASTE DISPOSAL-LIQUID
RC DRAIN TANK
(WD)
P & ID

JOB NO.	DRAWING NO.	REV.
EWR 3391E	33013-1272 SHEET 2 OF 2	

CCD 01 | CONTROL COPY #