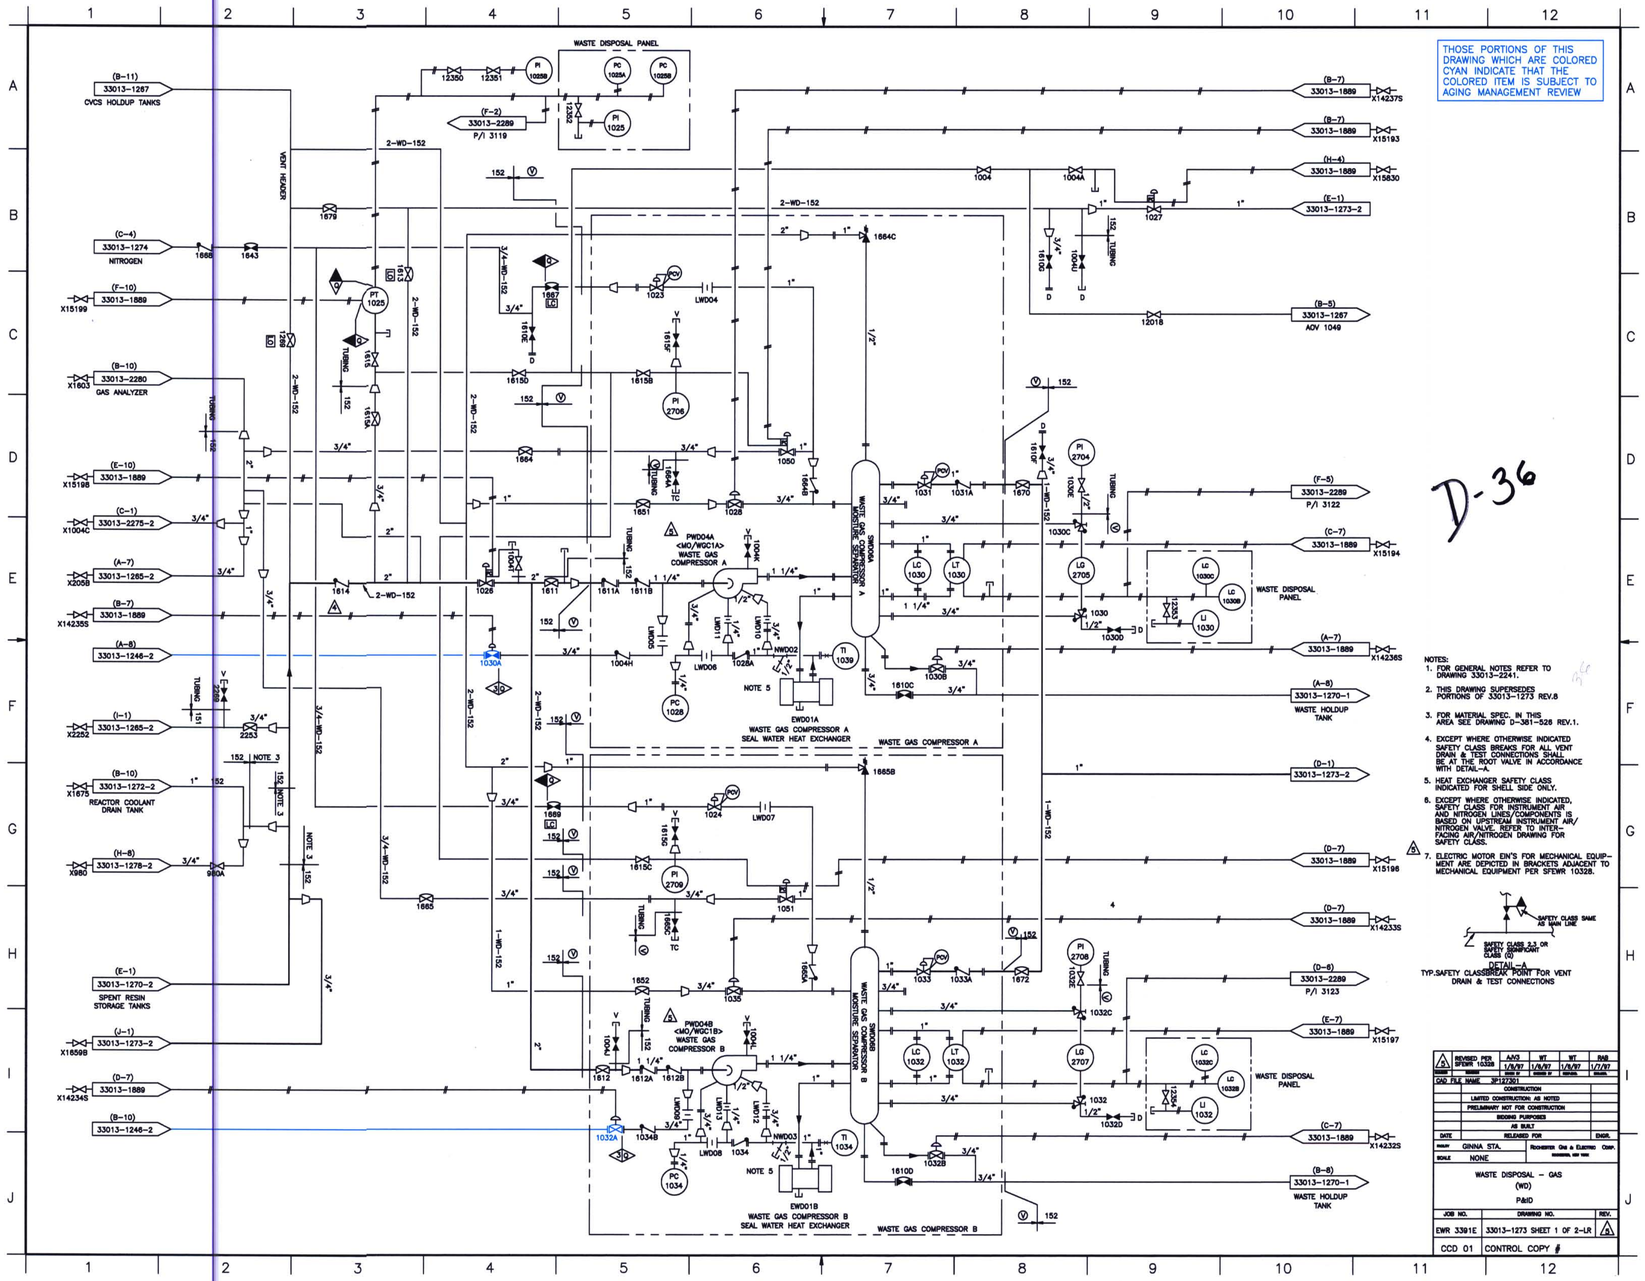

THOSE PORTIONS OF THIS DRAWING WHICH ARE COLORED CYAN INDICATE THAT THE COLORED ITEM IS SUBJECT TO AGING MANAGEMENT REVIEW

D-36

NOTES:

1. FOR GENERAL NOTES REFER TO DRAWING 33013-2241.
2. THIS DRAWING SUPERSEDES PORTIONS OF 33013-1273 REV.8
3. FOR MATERIAL SPEC. IN THIS AREA SEE DRAWING D-361-526 REV.1.
4. EXCEPT WHERE OTHERWISE INDICATED SAFETY CLASS BREAKS FOR ALL VENT DRAIN & TEST CONNECTIONS SHALL BE AT THE ROOT VALVE IN ACCORDANCE WITH DETAIL-A.
5. HEAT EXCHANGER SAFETY CLASS INDICATED FOR SHELL SIDE ONLY.
6. EXCEPT WHERE OTHERWISE INDICATED, SAFETY CLASS FOR INSTRUMENT AIR AND NITROGEN LINES/COMPONENTS IS BASED ON UPSTREAM INSTRUMENT AIR/NITROGEN VALVE. REFER TO INTERFACING AIR/NITROGEN DRAWING FOR SAFETY CLASS.
7. ELECTRIC MOTOR EIN'S FOR MECHANICAL EQUIPMENT ARE DEPICTED IN BRACKETS ADJACENT TO MECHANICAL EQUIPMENT PER SFEWR 10328.

SAFETY CLASS SAME AS MAIN LINE

SAFETY CLASS 2,3 OR SAFETY SUBMPOINT CLASS (Q)

DETAIL-A

TYP.SAFETY CLASSBREAK POINT FOR VENT DRAIN & TEST CONNECTIONS

5	REVISED PER SFEWR 10328	AA/3 1/8/97	WT 1/8/97	WT 1/8/97	RAB 1/7/97
CAD FILE NAME	3P127301				
	CONSTRUCTION				
	LIMITED CONSTRUCTION AS NOTED				
	PRELIMINARY NOT FOR CONSTRUCTION				
	BIDDING PURPOSES				
	AS BUILT				
DATE	RELEASED FOR				ENGR.
DRAWN	GINNA STA.	RICHESTER GAS & ELECTRIC CORP.			
SCALE	NONE				

WASTE DISPOSAL - GAS (WD) P&ID

JOB NO.	DRAWING NO.	REV.
EWR 3391E	33013-1273 SHEET 1 OF 2-LR	5
CCD 01	CONTROL COPY #	