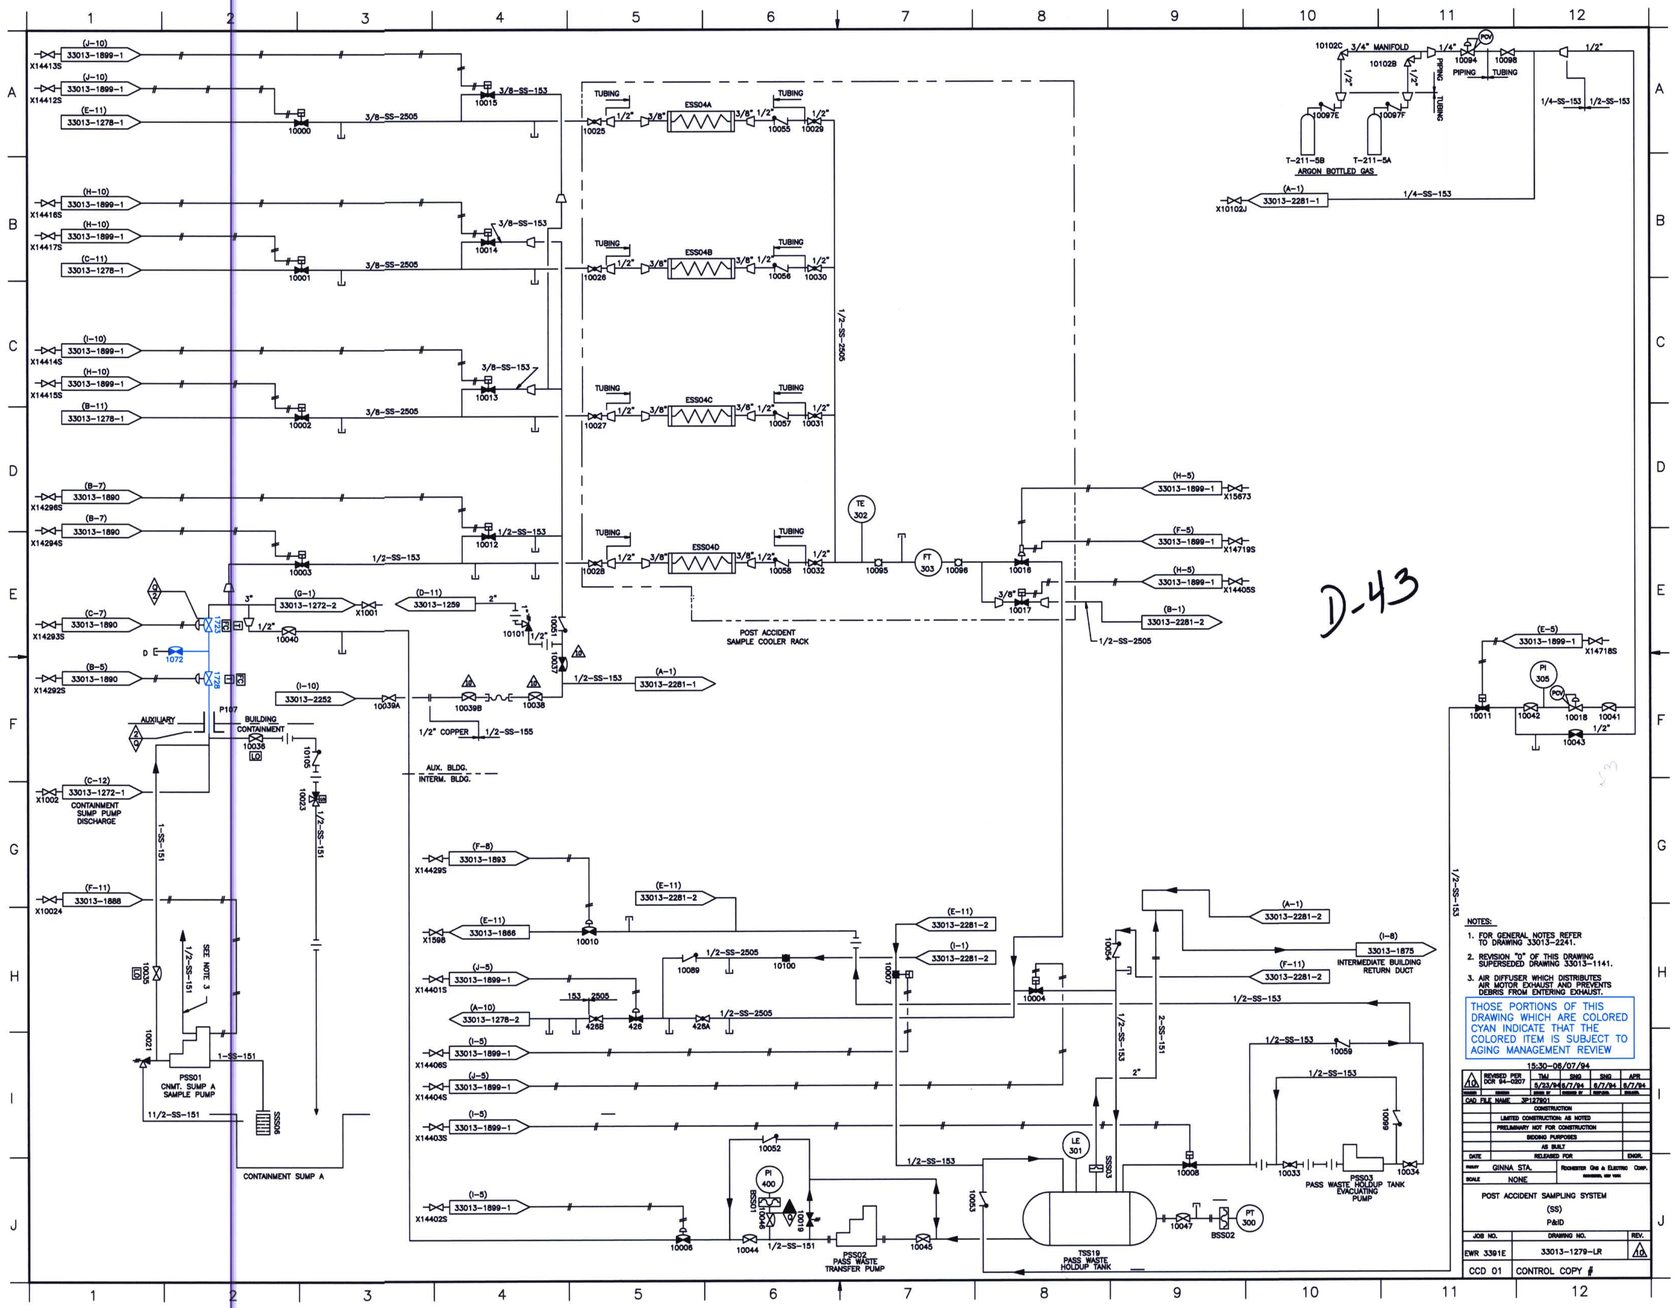

D-43
POST ACCIDENT SAMPLE COOLER RACK
ESS04A
ESS04B
ESS04C
ESS04D
TUBING
3/8-SS-153
3/8-SS-2505
1/2-SS-153
1/2-SS-2505
1/2" COPPER
1/2-SS-155
AUXILIARY
BUILDING CONTAINMENT
AUX. BLDG.
INTERM. BLDG.
CONTAINMENT SUMP PUMP DISCHARGE
CONTAINMENT SUMP A
PSS01 CNMT. SUMP A SAMPLE PUMP
SEE NOTE 3
PSS02 PASS WASTE TRANSFER PUMP
TSS19 PASS WASTE HOLDUP TANK
PSS03 PASS WASTE HOLDUP TANK EVACUATING PUMP
INTERMEDIATE BUILDING RETURN DUCT
ARGON BOTTLED GAS
3/4" MANIFOLD
PIPING
TUBING
NOTES:
1. FOR GENERAL NOTES REFER TO DRAWING 33013-2241.
2. REVISION "0" OF THIS DRAWING SUPERSEDED DRAWING 33013-1141.
3. AIR DIFFUSER WHICH DISTRIBUTES AIR MOTOR EXHAUST AND PREVENTS DEBRIS FROM ENTERING EXHAUST.
THOSE PORTIONS OF THIS DRAWING WHICH ARE COLORED CYAN INDICATE THAT THE COLORED ITEM IS SUBJECT TO AGING MANAGEMENT REVIEW
15:30-06/07/94
REVISED PER DCR 94-0207
CAD FILE NAME 3P127601
CONSTRUCTION
LIMITED CONSTRUCTION AS NOTED
PRELIMINARY NOT FOR CONSTRUCTION
BIDDING PURPOSES
AS BUILT
RELEASED FOR
GINNA STA.
NONE
POST ACCIDENT SAMPLING SYSTEM
(SS)
P&ID
EWR 3391E
33013-1279-LR
CCD 01
CONTROL COPY #