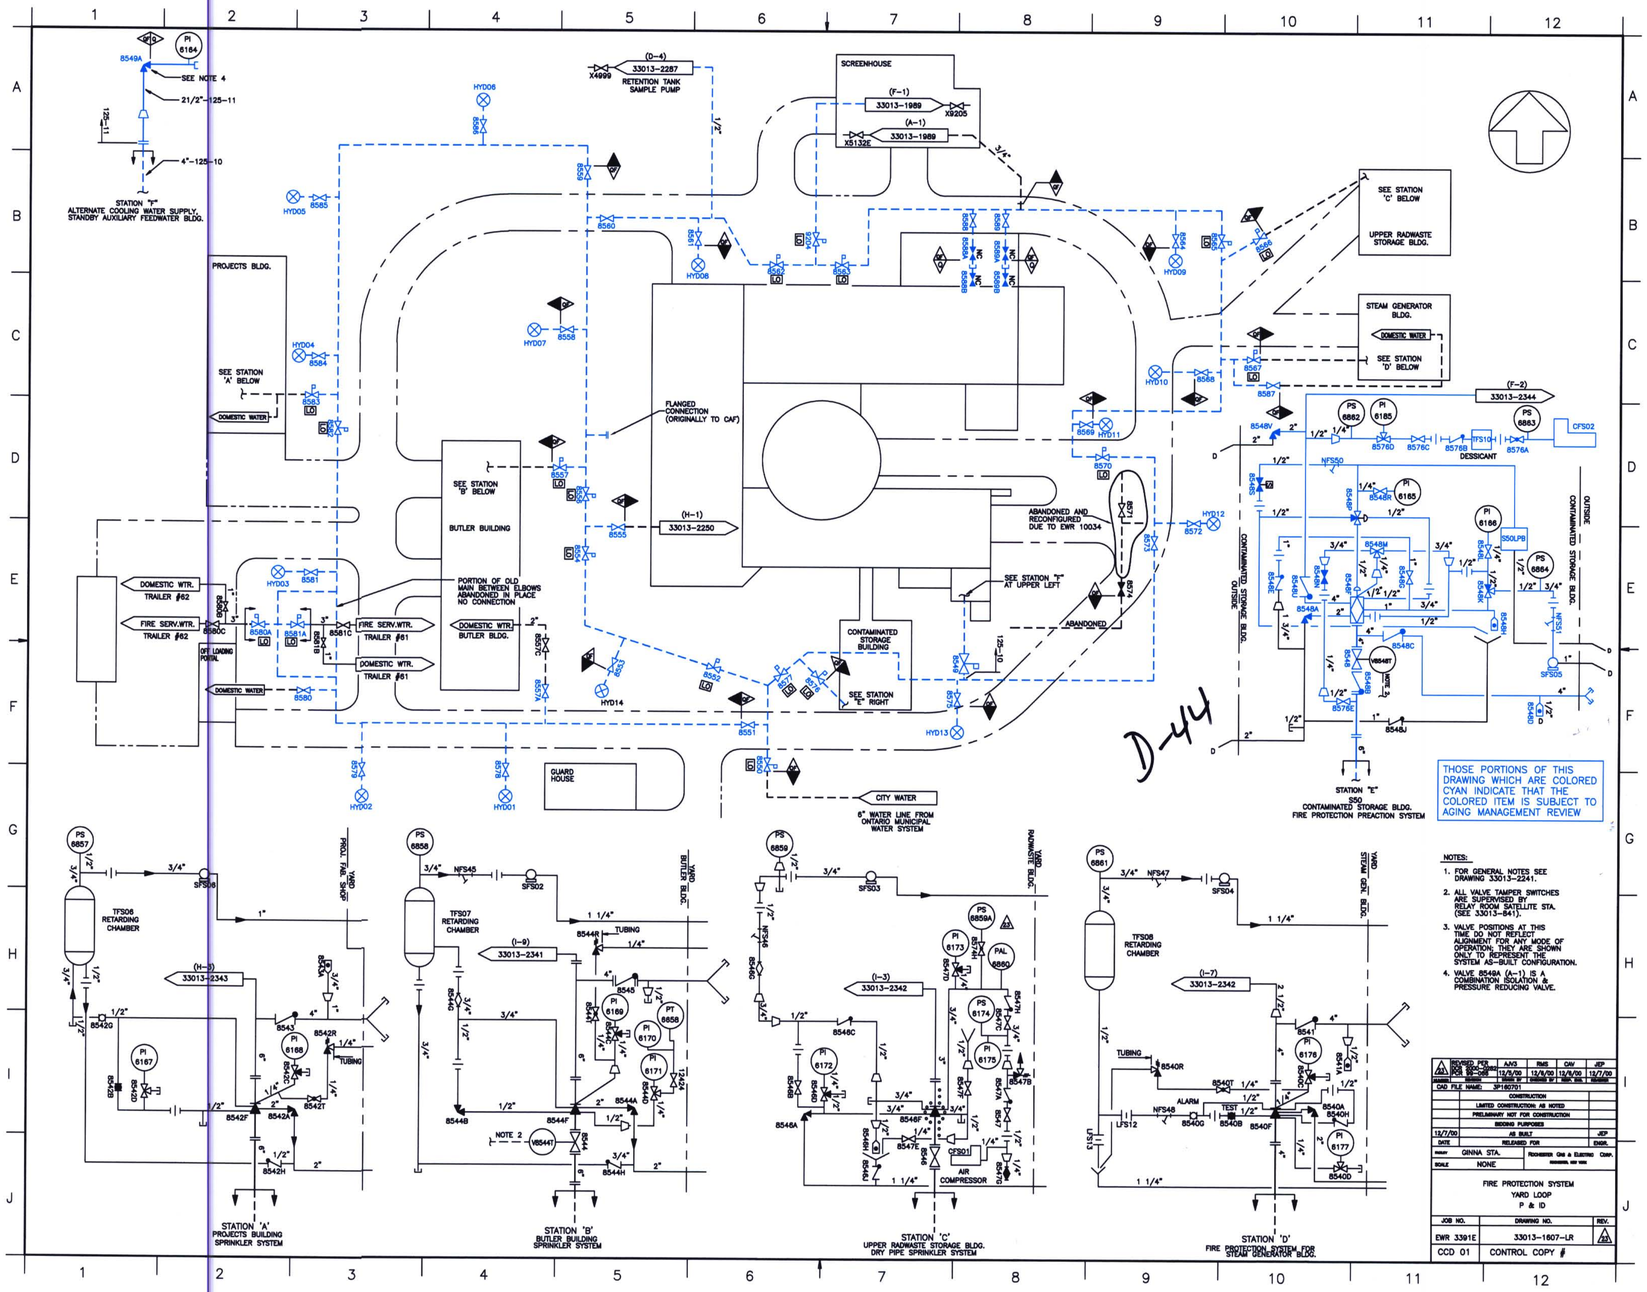
STATION "F"
ALTERNATE COOLING WATER SUPPLY, STANDBY AUXILIARY FEEDWATER BLDG.
SEE NOTE 4
21/2"-125-11
4"-125-10
PI 6164
8549A
(D-4)
33013-2287
RETENTION TANK SAMPLE PUMP
X4999
SCREENHOUSE
(F-1)
33013-1989
X9205
(A-1)
33013-1989
X5132E
PROJECTS BLDG.
SEE STATION 'A' BELOW
DOMESTIC WATER
SEE STATION 'B' BELOW
BUTLER BUILDING
PORTION OF OLD MAIN BETWEEN ELBOWS ABANDONED IN PLACE NO CONNECTION
FLANGED CONNECTION (ORIGINALLY TO CAF)
(H-1)
33013-2250
ABANDONED AND RECONFIGURED DUE TO EWR 10034
SEE STATION "F" AT UPPER LEFT
ABANDONED
CONTAMINATED STORAGE BUILDING
SEE STATION "E" RIGHT
DOMESTIC WTR. TRAILER #62
FIRE SERV.WTR. TRAILER #62
OFF LOADING PORTAL
FIRE SERV.WTR. TRAILER #61
DOMESTIC WTR. TRAILER #61
DOMESTIC WTR. BUTLER BLDG.
GUARD HOUSE
CITY WATER
6" WATER LINE FROM ONTARIO MUNICIPAL WATER SYSTEM
SEE STATION 'C' BELOW
UPPER RADWASTE STORAGE BLDG.
STEAM GENERATOR BLDG.
DOMESTIC WATER
SEE STATION 'D' BELOW
(F-2)
33013-2344
DESSICANT
CONTAMINATED STORAGE BLDG. OUTSIDE
OUTSIDE CONTAMINATED STORAGE BLDG.
STATION "E"
S50
CONTAMINATED STORAGE BLDG. FIRE PROTECTION PREACTION SYSTEM
D-44
THOSE PORTIONS OF THIS DRAWING WHICH ARE COLORED CYAN INDICATE THAT THE COLORED ITEM IS SUBJECT TO AGING MANAGEMENT REVIEW
TFS06 RETARDING CHAMBER
(H-3)
33013-2343
PROJ. PAL. SHOP
YARD
STATION 'A'
PROJECTS BUILDING SPRINKLER SYSTEM
TFS07 RETARDING CHAMBER
(I-9)
33013-2341
TUBING
NOTE 2
BUTLER BLDG.
YARD
STATION 'B'
BUTLER BUILDING SPRINKLER SYSTEM
(I-3)
33013-2342
AIR COMPRESSOR
RADWASTE BLDG.
YARD
STATION 'C'
UPPER RADWASTE STORAGE BLDG. DRY PIPE SPRINKLER SYSTEM
TFS08 RETARDING CHAMBER
(I-7)
33013-2342
ALARM
TEST
STEAM GEN. BLDG.
YARD
STATION 'D'
FIRE PROTECTION SYSTEM FOR STEAM GENERATOR BLDG.
NOTES:
1. FOR GENERAL NOTES SEE DRAWING 33013-2241.
2. ALL VALVE TAMPER SWITCHES ARE SUPERVISED BY RELAY ROOM SATELLITE STA. (SEE 33013-841).
3. VALVE POSITIONS AT THIS TIME DO NOT REFLECT ALIGNMENT FOR ANY MODE OF OPERATION. THE ARE SHOWN ONLY TO REPRESENT THE SYSTEM AS-BUILT CONFIGURATION.
4. VALVE 8549A (A-1) IS A COMBINATION ISOLATION & PRESSURE REDUCING VALVE.
CONSTRUCTION
LIMITED CONSTRUCTION AS NOTED
PRELIMINARY NOT FOR CONSTRUCTION
BIDDING PURPOSES
AS BUILT
RELEASED FOR
GINNA STA.
NONE
FIRE PROTECTION SYSTEM
YARD LOOP
P & ID
EWR 3391E
33013-1607-LR
CCD 01
CONTROL COPY #