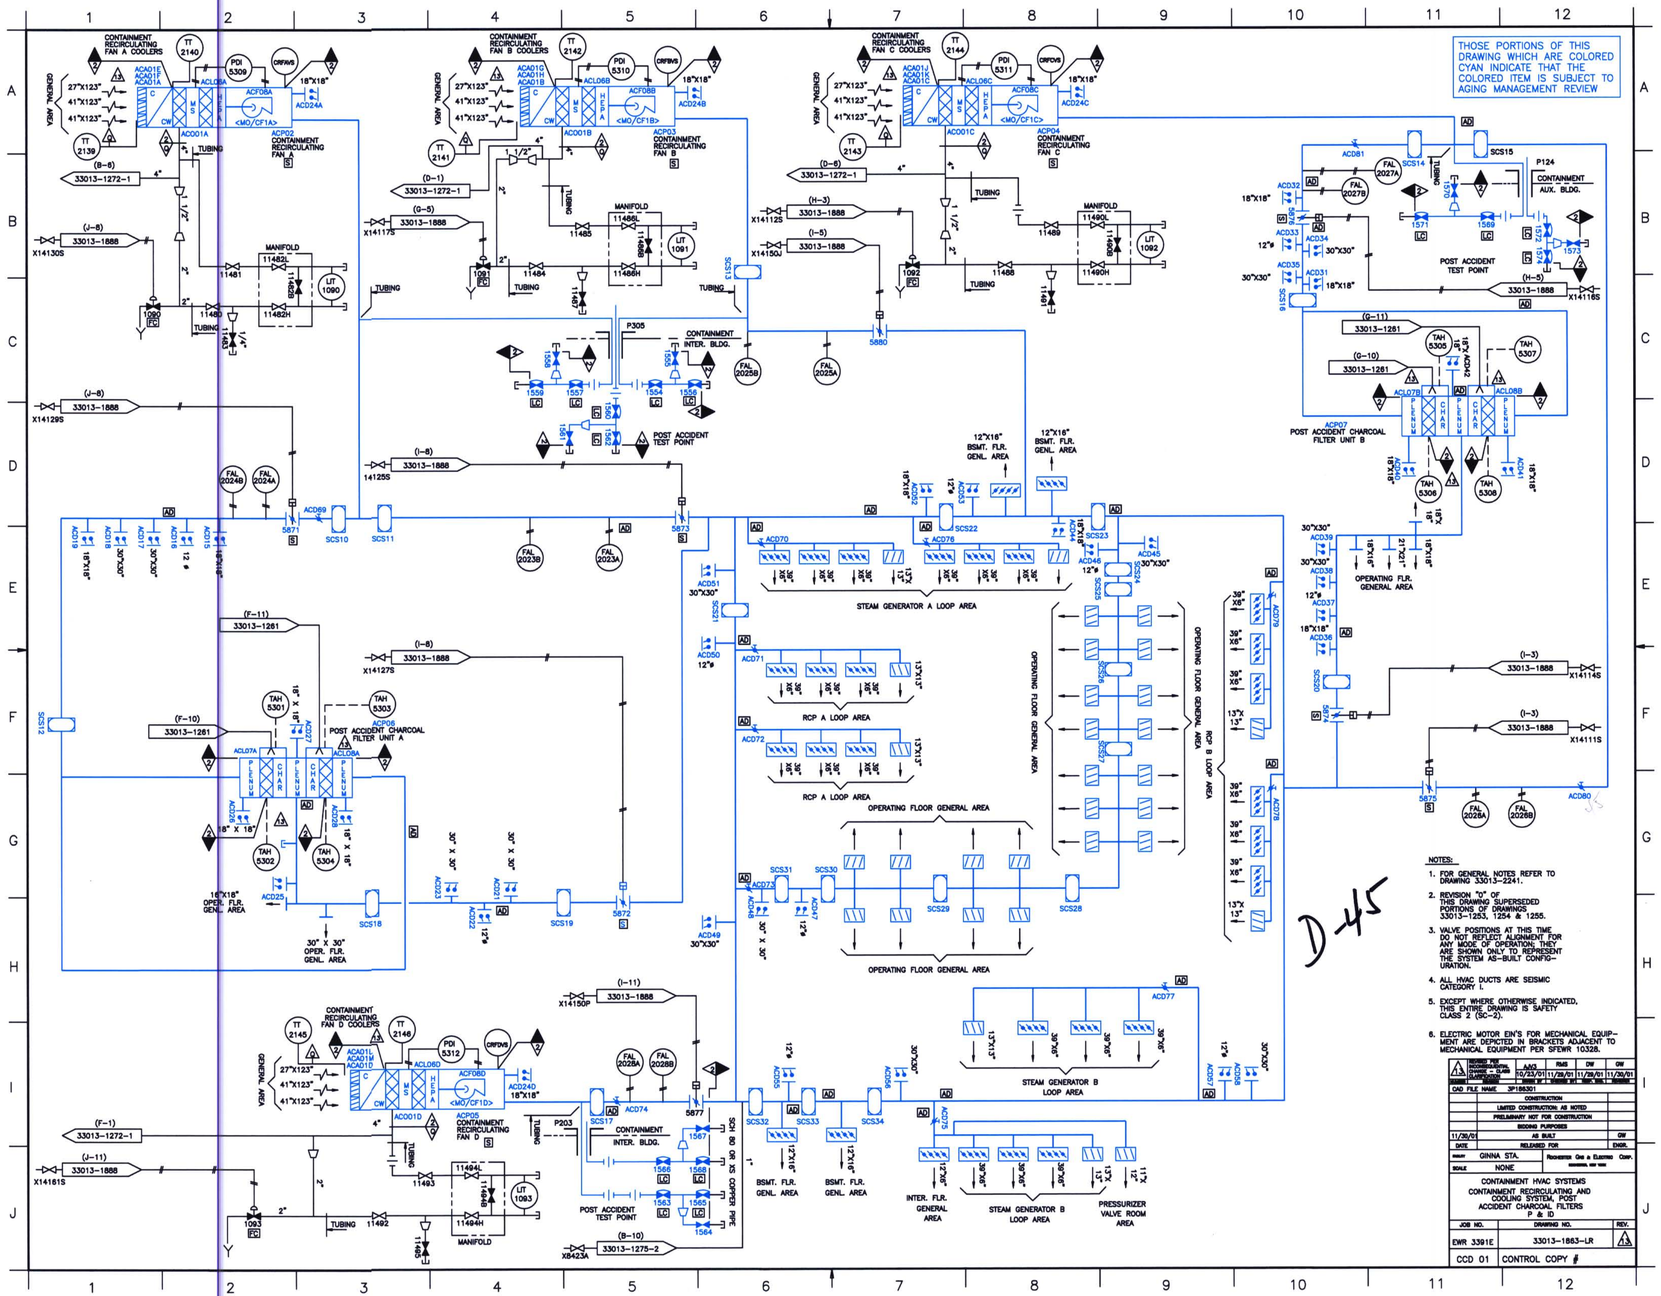
THOSE PORTIONS OF THIS DRAWING WHICH ARE COLORED CYAN INDICATE THAT THE COLORED ITEM IS SUBJECT TO AGING MANAGEMENT REVIEW
CONTAINMENT RECIRCULATING FAN A COOLERS
CONTAINMENT RECIRCULATING FAN B COOLERS
CONTAINMENT RECIRCULATING FAN C COOLERS
CONTAINMENT RECIRCULATING FAN D COOLERS
ACP02 CONTAINMENT RECIRCULATING FAN A
ACP03 CONTAINMENT RECIRCULATING FAN B
ACP04 CONTAINMENT RECIRCULATING FAN C
ACP05 CONTAINMENT RECIRCULATING FAN D
MANIFOLD
CONTAINMENT INTER. BLDG.
CONTAINMENT AUX. BLDG.
POST ACCIDENT TEST POINT
ACP07 POST ACCIDENT CHARCOAL FILTER UNIT B
POST ACCIDENT CHARCOAL FILTER UNIT A
STEAM GENERATOR A LOOP AREA
RCP A LOOP AREA
OPERATING FLOOR GENERAL AREA
STEAM GENERATOR B LOOP AREA
INTER. FLR. GENERAL AREA
PRESSURIZER VALVE ROOM AREA
BSMT. FLR. GENERAL AREA
OPERATING FLR. GENERAL AREA
SIDE HR OR 30 X 30 OPERATING FLOOR GENERAL AREA
NOTES:
1. FOR GENERAL NOTES REFER TO DRAWING 33013-2241.
2. REVISION "0" OF THIS DRAWING SUPERSEDED PORTIONS OF DRAWINGS 33013-1253, 1254 & 1255.
3. VALVE POSITIONS AT THIS TIME DO NOT REFLECT ALIGNMENT FOR ANY MODE OF OPERATION; THEY ARE SHOWN ONLY TO REPRESENT THE SYSTEM AS-BUILT CONFIGURATION.
4. ALL HVAC DUCTS ARE SEISMIC CATEGORY I.
5. EXCEPT WHERE OTHERWISE INDICATED, THIS ENTIRE DRAWING IS SAFETY CLASS 2 (SC-2).
6. ELECTRIC MOTOR EIN'S FOR MECHANICAL EQUIPMENT ARE DEPICTED IN BRACKETS ADJACENT TO MECHANICAL EQUIPMENT PER SFEWR 10328.
D-45
CONSTRUCTION
LIMITED CONSTRUCTION AS NOTED
PRELIMINARY NOT FOR CONSTRUCTION
DESIGN PURPOSES
AS BUILT
RELEASED FOR
GINNA STA.
NONE
CONTAINMENT HVAC SYSTEMS
CONTAINMENT RECIRCULATING AND COOLING SYSTEM, POST ACCIDENT CHARCOAL FILTERS
P & ID
EWR 3391E
33013-1863-LR
CCD 01
CONTROL COPY