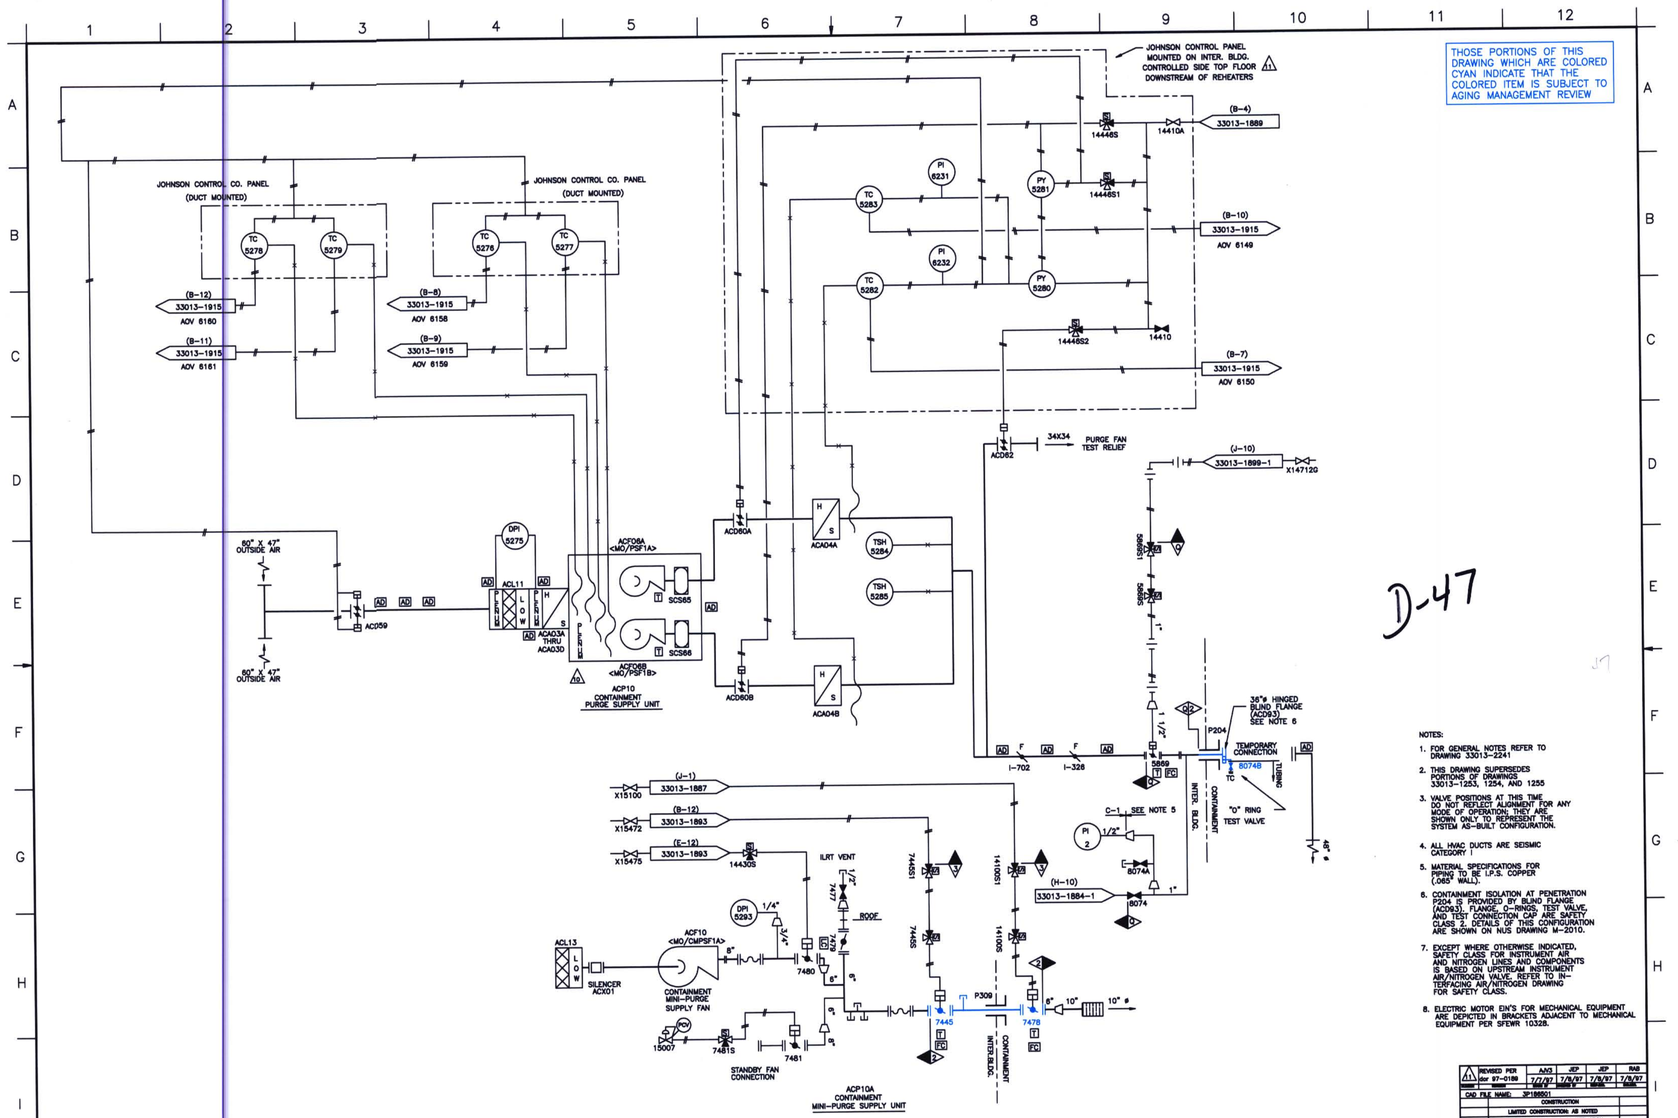

THOSE PORTIONS OF THIS DRAWING WHICH ARE COLORED CYAN INDICATE THAT THE COLORED ITEM IS SUBJECT TO AGING MANAGEMENT REVIEW

D-47

NOTES:

1. FOR GENERAL NOTES REFER TO DRAWING 33013-2241
2. THIS DRAWING SUPERSEDES PORTIONS OF DRAWINGS 33013-1253, 1254, AND 1255
3. VALVE POSITIONS AT THIS TIME DO NOT REFLECT ALIGNMENT FOR ANY MODE OF OPERATION; THEY ARE SHOWN ONLY TO REPRESENT THE SYSTEM AS-BUILT CONFIGURATION.
4. ALL HVAC DUCTS ARE SEISMIC CATEGORY I
5. MATERIAL SPECIFICATIONS FOR PIPING TO BE I.P.S. COPPER (.065" WALL).
6. CONTAINMENT ISOLATION AT PENETRATION P204 IS PROVIDED BY BLIND FLANGE (ACD93). FLANGE, O-RINGS, TEST VALVE, AND TEST CONNECTION CAP ARE SAFETY CLASS 2. DETAILS OF THIS CONFIGURATION ARE SHOWN ON NUS DRAWING M-2010.
7. EXCEPT WHERE OTHERWISE INDICATED, SAFETY CLASS FOR INSTRUMENT AIR AND NITROGEN LINES AND COMPONENTS IS BASED ON UPSTREAM INSTRUMENT AIR/NITROGEN VALVE. REFER TO INTERFACING AIR/NITROGEN DRAWING FOR SAFETY CLASS.
8. ELECTRIC MOTOR EIN'S FOR MECHANICAL EQUIPMENT ARE DEPICTED IN BRACKETS ADJACENT TO MECHANICAL EQUIPMENT PER SFEWR 10328.

REVISED PER dcr 97-0189	AJG	JEP	JEP	RAB
	7/7/97	7/8/97	7/8/97	7/8/97

CAD FILE NAME: 3P186501

CONSTRUCTION

LIMITED CONSTRUCTION AS NOTED

PRELIMINARY NOT FOR CONSTRUCTION

BIDDING PURPOSES

7/8/97 AS-BUILT JEP

DATE RELEASED FOR ENGR.

DRAWN GINNA STA. ROCHESTER GAS & ELECTRIC CORP.

SCALE NONE

CONTAINMENT HVAC SYSTEMS
PURGE SUPPLY
P & ID

JOB NO.	DRAWING NO.	REV.
EWR-3391E	33013-1865-LR	11

CCD 01 CONTROL COPY #