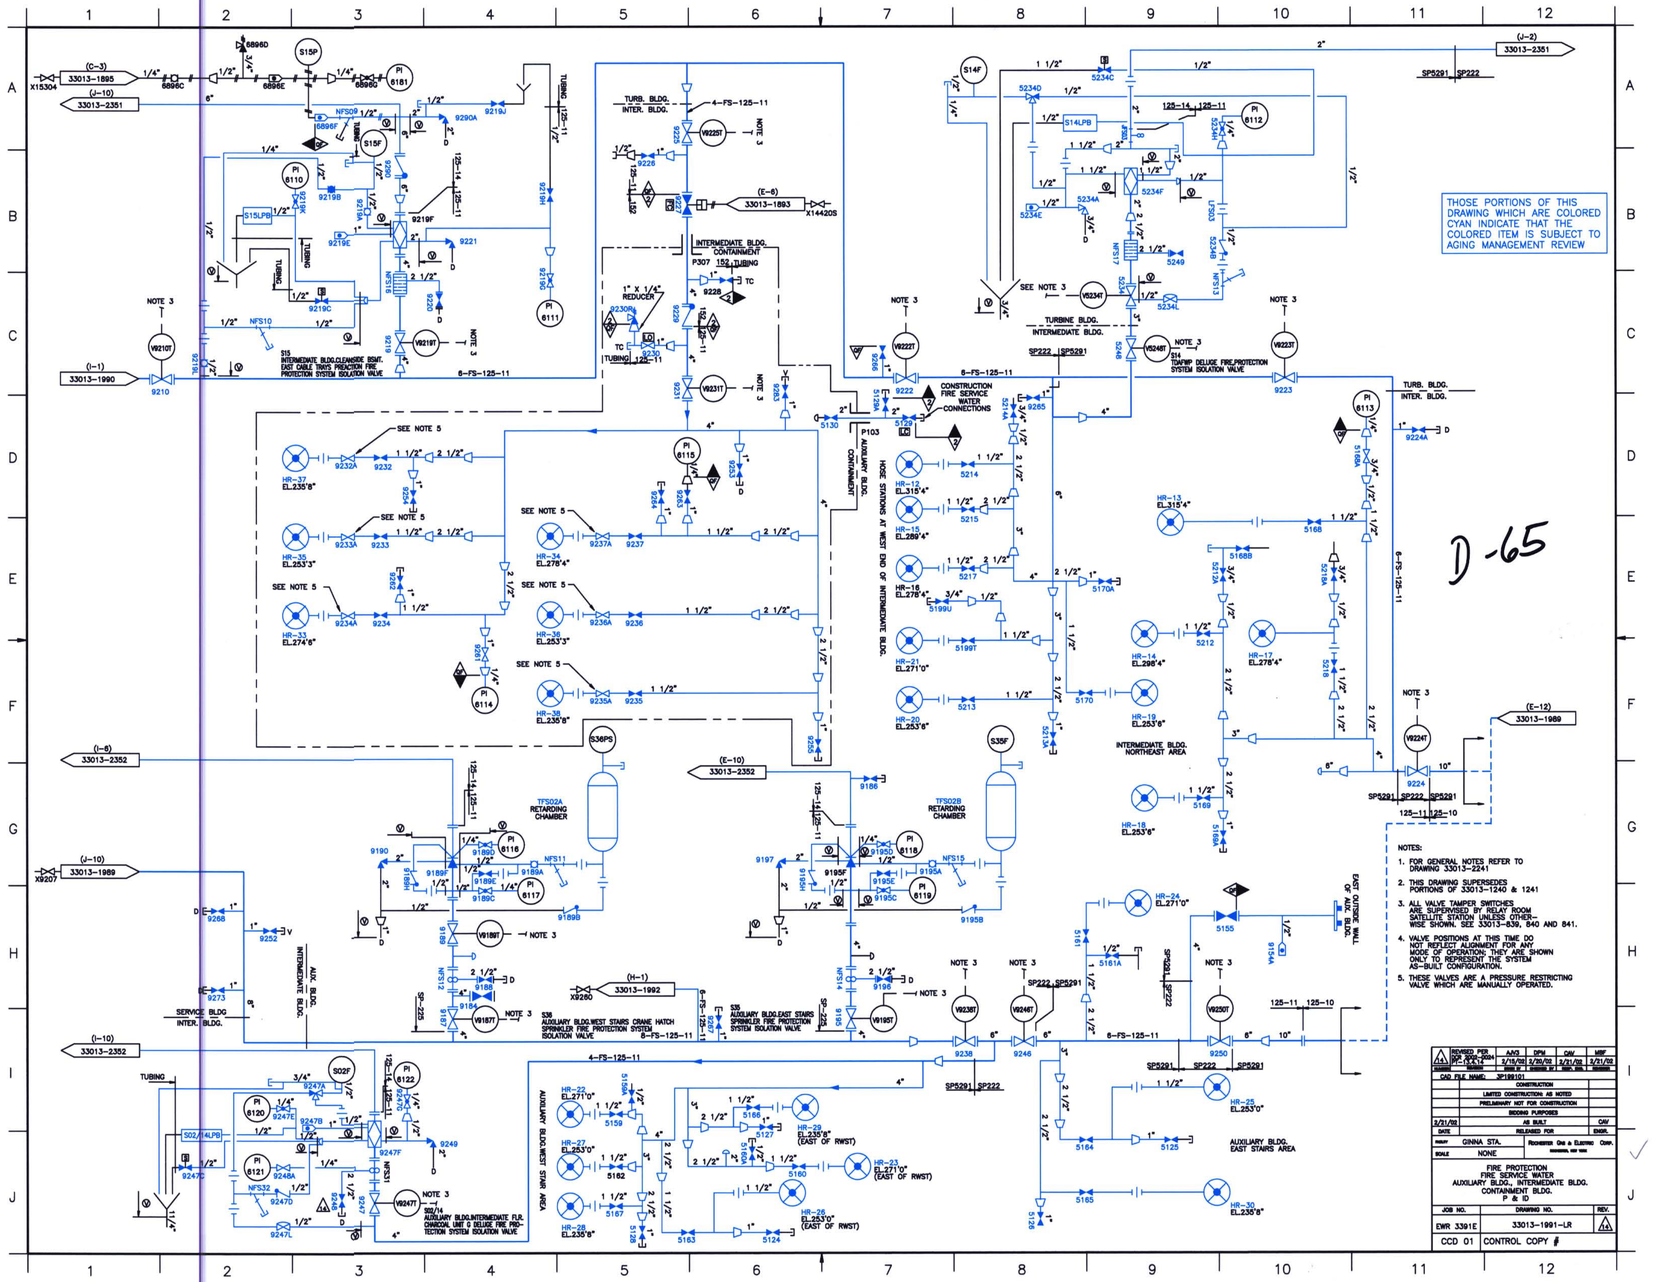
THOSE PORTIONS OF THIS DRAWING WHICH ARE COLORED CYAN INDICATE THAT THE COLORED ITEM IS SUBJECT TO AGING MANAGEMENT REVIEW
D-65
NOTES:
1. FOR GENERAL NOTES REFER TO DRAWING 33013-2241
2. THIS DRAWING SUPERSEDES PORTIONS OF 33013-1240 & 1241
3. ALL VALVE TAMPER SWITCHES ARE SUPERVISED BY RELAY ROOM SATELLITE STATION UNLESS OTHERWISE SHOWN. SEE 33013-839, 840 AND 841.
4. VALVE POSITIONS AT THIS TIME DO NOT REFLECT ALIGNMENT FOR ANY MODE OF OPERATION; THEY ARE SHOWN ONLY TO REPRESENT THE SYSTEM AS-BUILT CONFIGURATION.
5. THESE VALVES ARE A PRESSURE RESTRICTING VALVE WHICH ARE MANUALLY OPERATED.
CONSTRUCTION
LIMITED CONSTRUCTION AS NOTED
PRELIMINARY NOT FOR CONSTRUCTION
BIDDING PURPOSES
AS BUILT
RELEASED FOR
GINNA STA.
ROCHESTER GAS & ELECTRIC CORP.
NONE
FIRE PROTECTION
FIRE SERVICE WATER
AUXILIARY BLDG., INTERMEDIATE BLDG.
CONTAINMENT BLDG.
P & ID
JOB NO.
DRAWING NO.
REV.
EWR 3391E
33013-1991-LR
CCD 01
CONTROL COPY