THOSE PORTIONS OF THIS DRAWING WHICH ARE COLORED CYAN INDICATE THAT THE COLORED ITEM IS SUBJECT TO AGING MANAGEMENT REVIEW

D-60

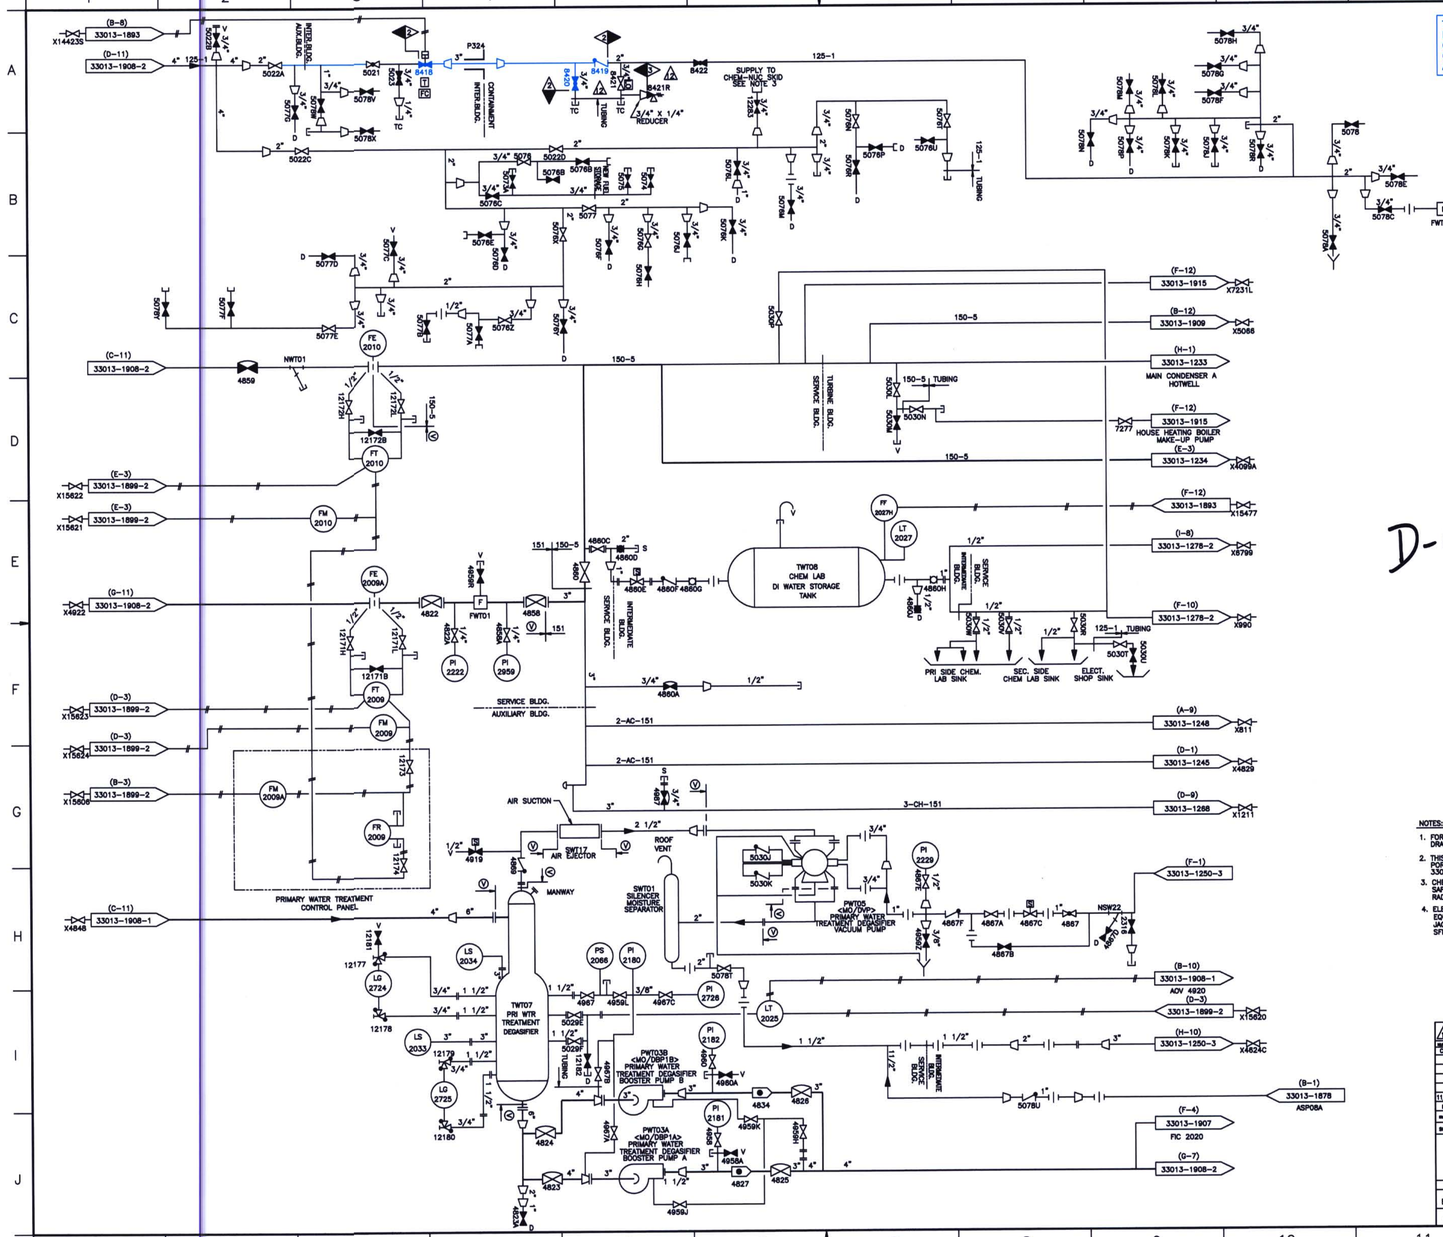

NOTES:

1. FOR GENERAL NOTES REFER TO DRAWING 33013-2241.
2. THIS DRAWING SUPERSEDES PORTIONS OF DRAWING 33013-1908, REV. 2.
3. CHEM-NUC SKID EVALUATED UNDER EWR 4999A, SAFETY ANALYSIS, "CHEM-NUCLEAR LIQUID RADWASTE DEMINERALIZER SYSTEM".
4. ELECTRIC MOTOR EIN'S FOR MECHANICAL EQUIPMENT ARE DEPICTED IN BRACKETS ADJACENT TO MECHANICAL EQUIPMENT PER SFEWR 10326.

3	REVISED PER DCR 391-0146	AAG	RMS	PJS	MJS
2A	REVISED PER DCR 97-010	11/12/01	11/28/01	11/28/01	11/28/01
REVISION		DRAWN BY	CHECKED BY	REV. SUP.	REVISION
CAD FILE NAME	3P190803				

	CONSTRUCTION	
	LIMITED CONSTRUCTION: AS NOTED	
	PRELIMINARY NOT FOR CONSTRUCTION	
	SIGNING PURPOSES	
11/28/01	AS BUILT	PJG
DATE	RELEASED FOR	SIGN.

DRAWN	GINNA STA.	Rochester Gas & Electric Corp.
SCALE	NONE	ROCHESTER, NEW YORK

PRIMARY WATER TREATMENT

P & ID

JOB NO.	DRAWING NO.	REV.
EWR 3391E	33013-1908 SHEET 3 OF 3-LR	2A
CCD 01	CONTROL COPY #	