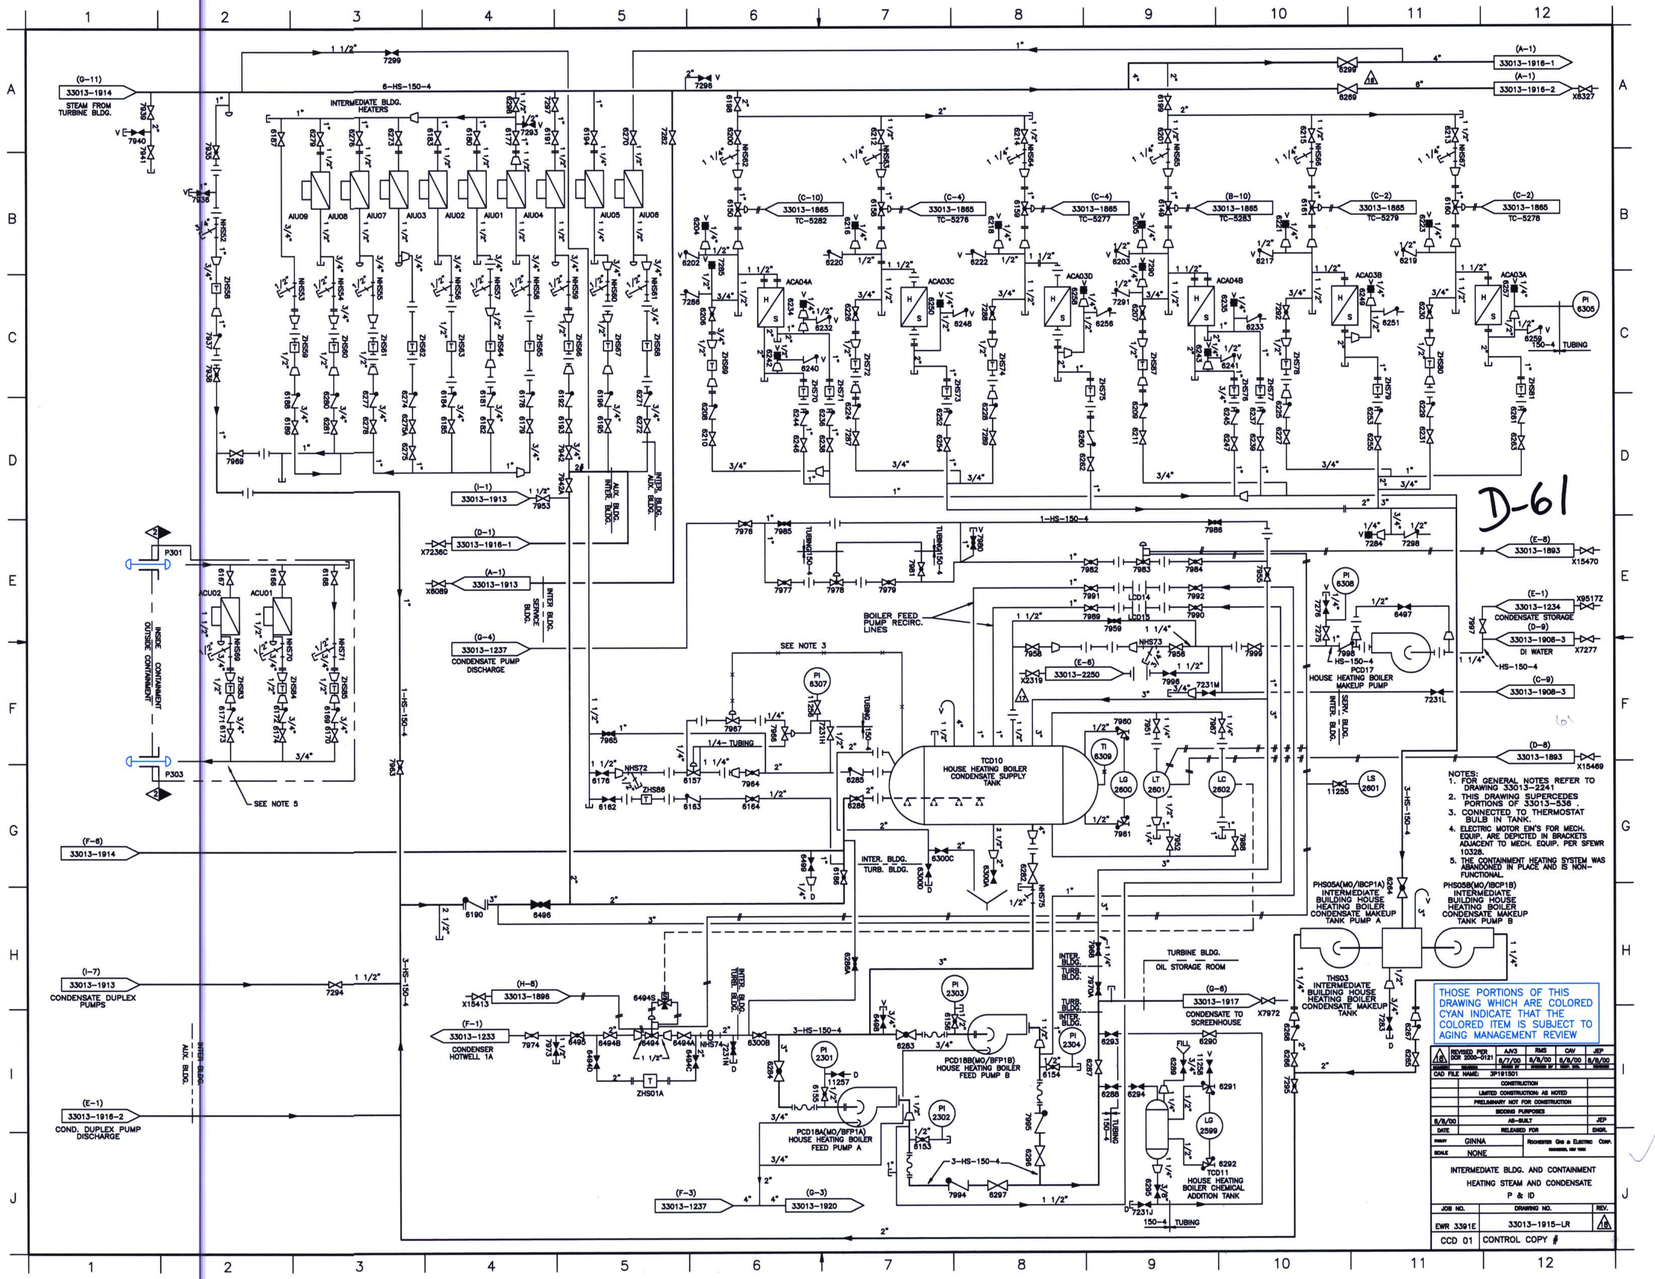
D-61
STEAM FROM TURBINE BLDG.
INTERMEDIATE BLDG. HEATERS
INSIDE CONTAINMENT
OUTSIDE CONTAINMENT
SEE NOTE 5
CONDENSATE DUPLEX PUMPS
COND. DUPLEX PUMP DISCHARGE
CONDENSATE PUMP DISCHARGE
BOILER FEED PUMP RECIRC. LINES
SEE NOTE 3
TCD10 HOUSE HEATING BOILER CONDENSATE SUPPLY TANK
PCD17 HOUSE HEATING BOILER MAKEUP PUMP
CONDENSATE STORAGE
DI WATER
PHS05A(MO/IBCP1A) INTERMEDIATE BUILDING HOUSE HEATING BOILER CONDENSATE MAKEUP TANK PUMP A
PHS05B(MO/IBCP1B) INTERMEDIATE BUILDING HOUSE HEATING BOILER CONDENSATE MAKEUP TANK PUMP B
THS03 INTERMEDIATE BUILDING HOUSE HEATING BOILER CONDENSATE MAKEUP TANK
TURBINE BLDG. OIL STORAGE ROOM
CONDENSATE TO SCREENHOUSE
CONDENSER HOTWELL 1A
PCD18B(MO/BFP1B) HOUSE HEATING BOILER FEED PUMP B
PCD18A(MO/BFP1A) HOUSE HEATING BOILER FEED PUMP A
TCD11 HOUSE HEATING BOILER CHEMICAL ADDITION TANK
NOTES:
1. FOR GENERAL NOTES REFER TO DRAWING 33013-2241
2. THIS DRAWING SUPERCEDES PORTIONS OF 33013-536.
3. CONNECTED TO THERMOSTAT BULB IN TANK.
4. ELECTRIC MOTOR EIN'S FOR MECH. EQUIP. ARE DEPICTED IN BRACKETS ADJACENT TO MECH. EQUIP. PER SFEWR 10328.
5. THE CONTAINMENT HEATING SYSTEM WAS ABANDONED IN PLACE AND IS NON-FUNCTIONAL.
THOSE PORTIONS OF THIS DRAWING WHICH ARE COLORED CYAN INDICATE THAT THE COLORED ITEM IS SUBJECT TO AGING MANAGEMENT REVIEW
REVISED PER DCR 2000-0121
CAD FILE NAME: 3P191501
CONSTRUCTION
LIMITED CONSTRUCTION AS NOTED
PRELIMINARY NOT FOR CONSTRUCTION
BIDDING PURPOSES
AS-BUILT
RELEASED FOR
GINNA
NONE
INTERMEDIATE BLDG. AND CONTAINMENT HEATING STEAM AND CONDENSATE P & ID
JOB NO.
DRAWING NO.
REV.
EWR 3391E
33013-1915-LR
CCD 01
CONTROL COPY #