THOSE PORTIONS OF THIS DRAWING WHICH ARE COLORED CYAN INDICATE THAT THE COLORED ITEM IS SUBJECT TO AGING MANAGEMENT REVIEW

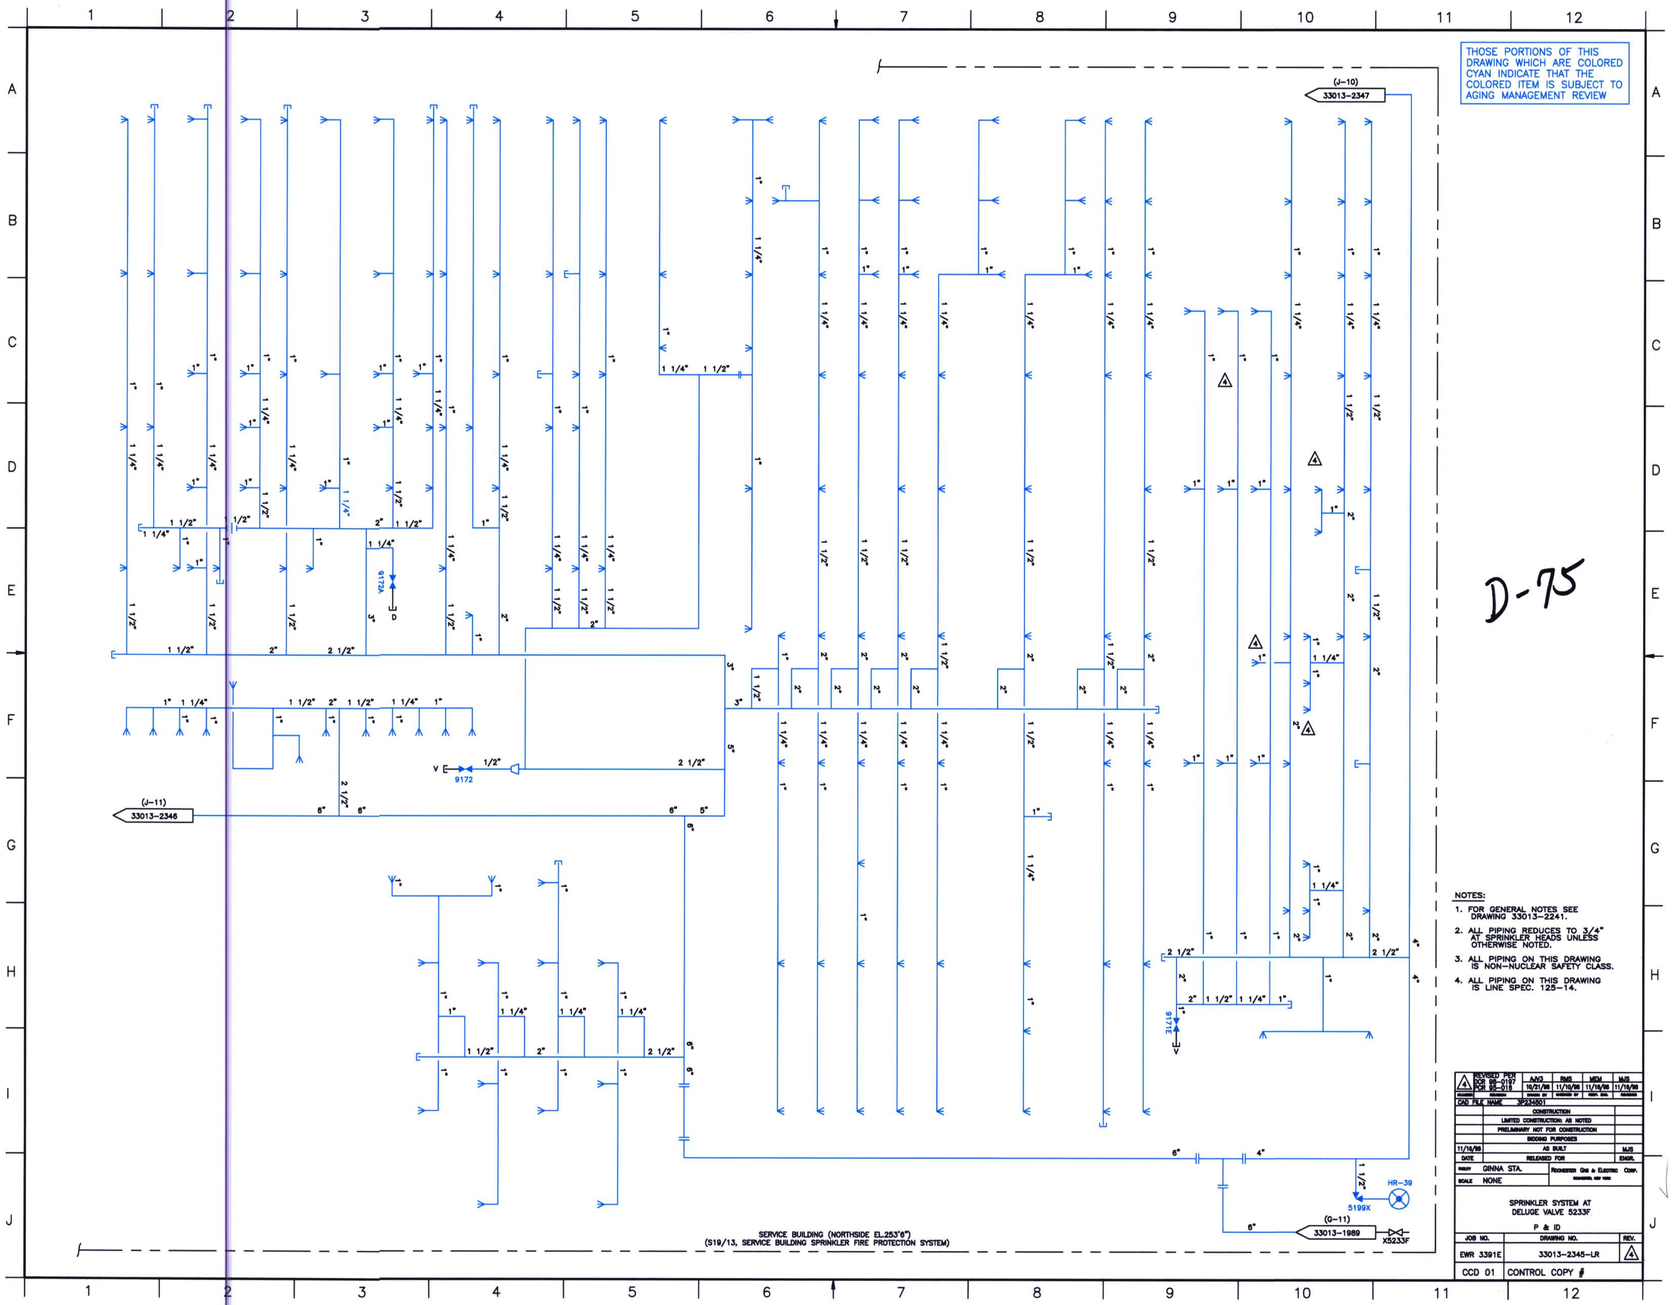

D-75

NOTES:

1. FOR GENERAL NOTES SEE DRAWING 33013-2241.
2. ALL PIPING REDUCES TO 3/4" AT SPRINKLER HEADS UNLESS OTHERWISE NOTED.
3. ALL PIPING ON THIS DRAWING IS NON-NUCLEAR SAFETY CLASS.
4. ALL PIPING ON THIS DRAWING IS LINE SPEC. 125-14.

4	REVISED PER DCR 98-0197 DCR 95-016	AWG	RMS	MEM	MJS
		10/21/98	11/16/98	11/16/98	11/16/98
CAD FILE NAME	3P234501				

CONSTRUCTION

LIMITED CONSTRUCTION AS NOTED

PRELIMINARY NOT FOR CONSTRUCTION

BIDDING PURPOSES

11/16/98	AS BUILT	MJS
DATE	RELEASED FOR	ENGR.

FAMILY GINNA STA.	ROCHESTER GAS & ELECTRIC CORP.
SCALE NONE	

SPRINKLER SYSTEM AT DELUGE VALVE 5233F

P & ID

JOB NO.	DRAWING NO.	REV.
EWR 3391E	33013-2345-LR	4
CCD 01	CONTROL COPY #	