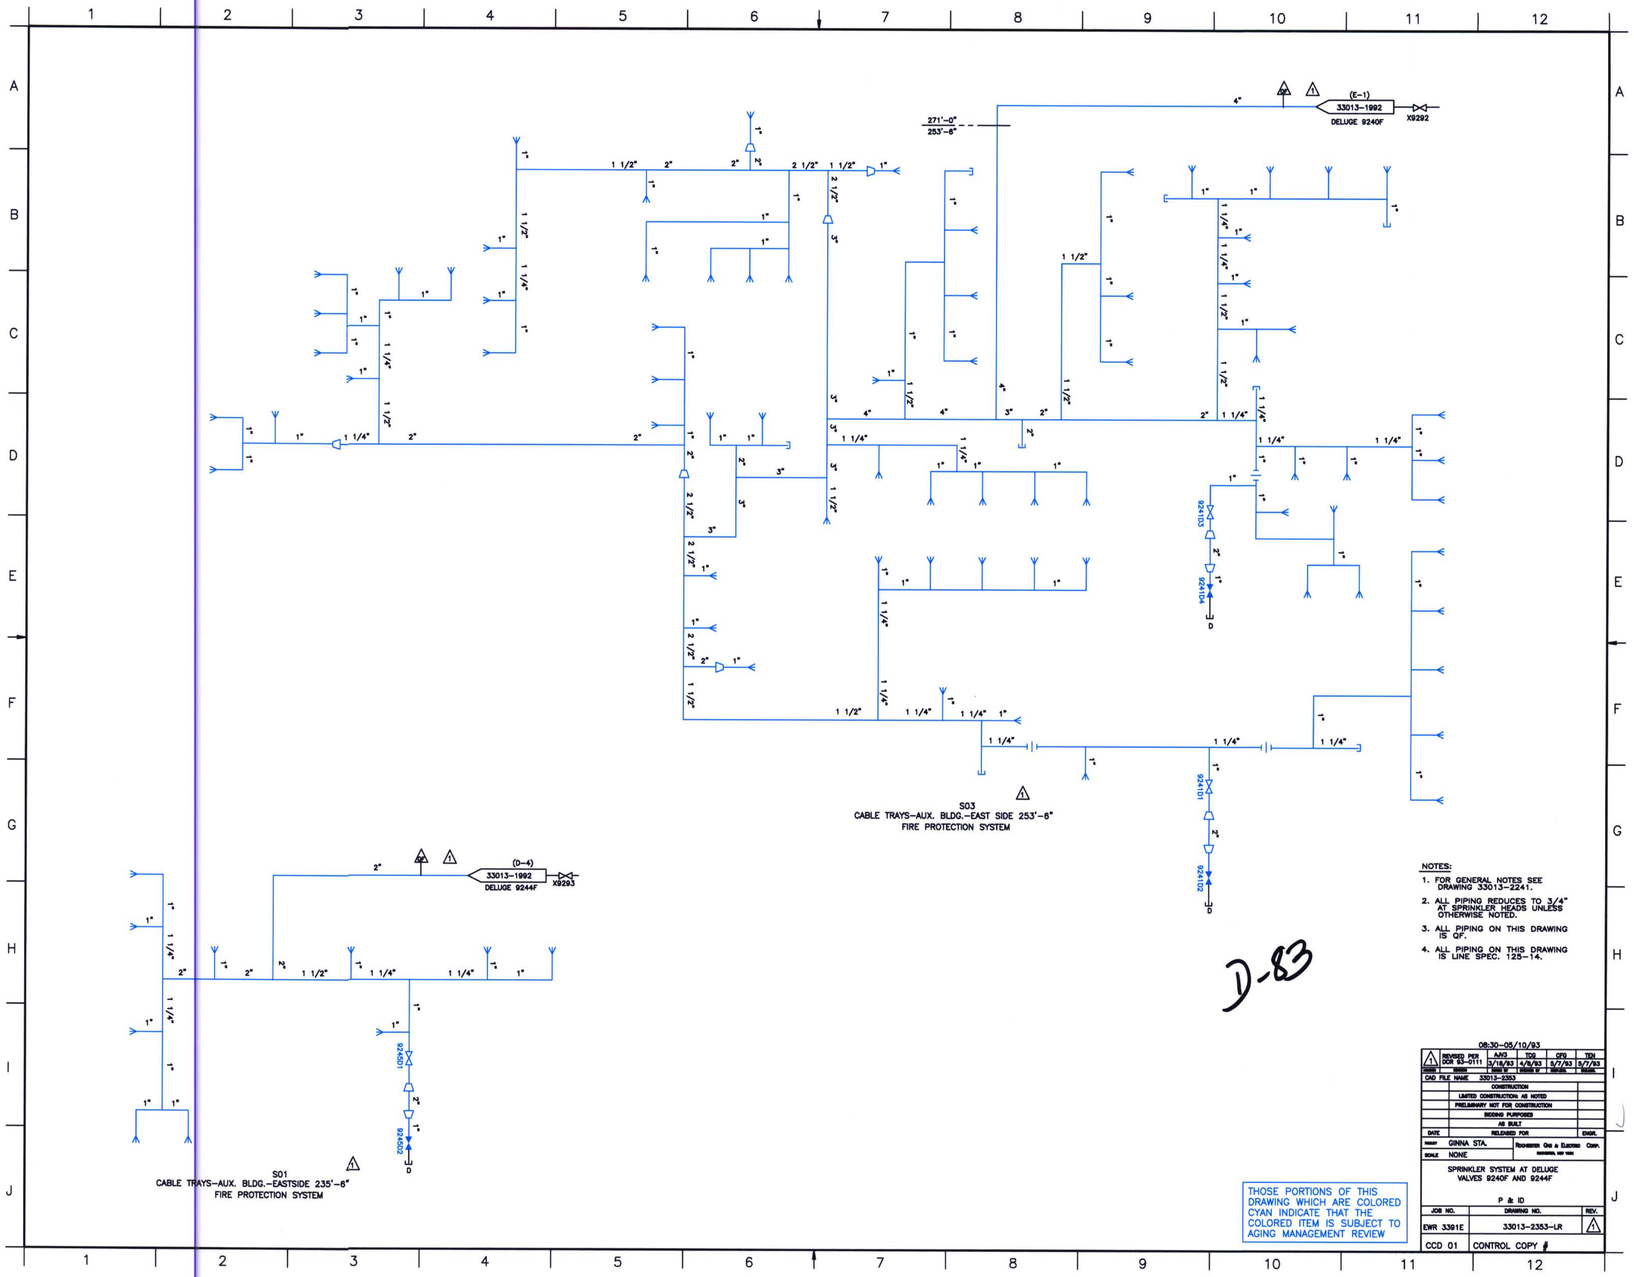
(E-1)
33013-1992
DELUGE 9240F
X9292
271'-0"
253'-6"
S03
CABLE TRAYS-AUX. BLDG.-EAST SIDE 253'-6"
FIRE PROTECTION SYSTEM
(D-4)
33013-1992
DELUGE 9244F
X9293
S01
CABLE TRAYS-AUX. BLDG.-EASTSIDE 235'-6"
FIRE PROTECTION SYSTEM
D-83
NOTES:
1. FOR GENERAL NOTES SEE DRAWING 33013-2241.
2. ALL PIPING REDUCES TO 3/4" AT SPRINKLER HEADS UNLESS OTHERWISE NOTED.
3. ALL PIPING ON THIS DRAWING IS QF.
4. ALL PIPING ON THIS DRAWING IS LINE SPEC. 125-14.
THOSE PORTIONS OF THIS DRAWING WHICH ARE COLORED CYAN INDICATE THAT THE COLORED ITEM IS SUBJECT TO AGING MANAGEMENT REVIEW
08:30-05/10/93
REVISED PER DCN 93-0111
CAD FILE NAME 33013-2353
CONSTRUCTION
LIMITED CONSTRUCTION AS NOTED
PRELIMINARY NOT FOR CONSTRUCTION
BIDDING PURPOSES
AS BUILT
RELEASED FOR
PLANT CINNA STA.
SCALE NONE
SPRINKLER SYSTEM AT DELUGE VALVES 9240F AND 9244F
P & ID
JOB NO. EWR 3391E
DRAWING NO. 33013-2353-LR
CCD 01 CONTROL COPY