THOSE PORTIONS OF THIS DRAWING WHICH ARE COLORED CYAN INDICATE THAT THE COLORED ITEM IS SUBJECT TO AGING MANAGEMENT REVIEW

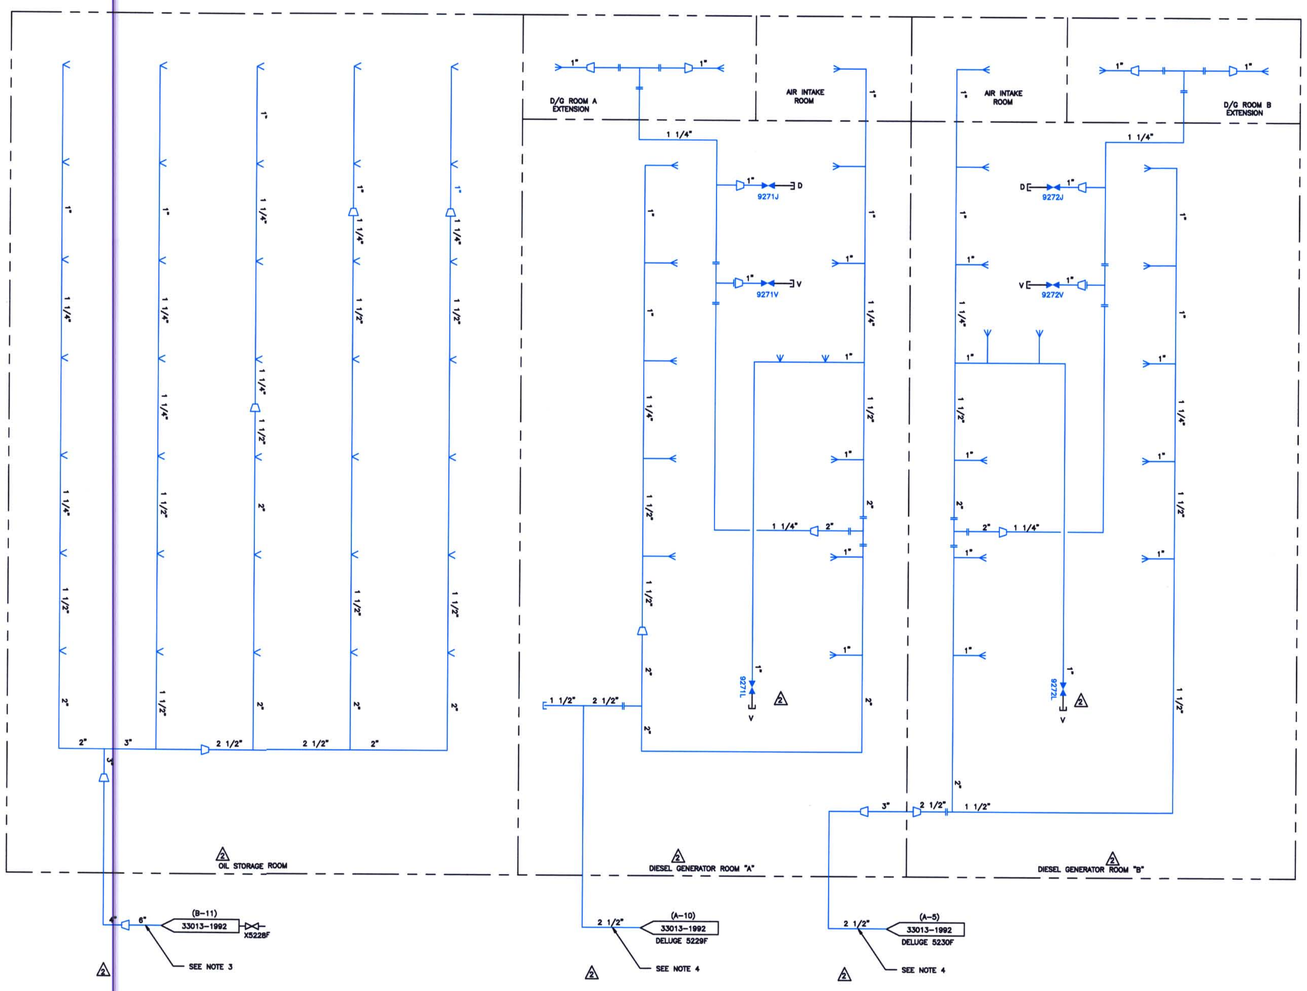

(S16, OIL STORAGE ROOM DELUGE FIRE PROTECTION SYSTEM)

(S12, DIESEL GENERATOR A BUILDING PREACTION FIRE PROTECTION SYSTEM)

(S13, DIESEL GENERATOR B BUILDING PREACTION FIRE PROTECTION SYSTEM)

D-85

NOTES:

1. FOR GENERAL NOTES SEE DRAWING 33013-2241.
2. ALL PIPING REDUCES TO 3/4" AT SPRINKLER HEADS UNLESS OTHERWISE NOTED.
3. SPRINKLER PIPING FOR OIL STORAGE BUILDING IS NON QF.
4. SPRINKLER PIPING FOR DIESEL GENERATOR ROOMS A & B IS QF.
5. ALL PIPING ON THIS DRAWING IS LINE SPEC. 125-11.

15:00-12/01/92

2	REVISED PER DCR 92-0607	AJVD 11/20/92	BJT 11/20/92	CFG 11/20/92	YDN 12/1/92
REV.	REM.	REM.	REM.	REM.	REM.

CAD FILE NAME 33013-2355

CONSTRUCTION
LIMITED CONSTRUCTION AS NOTED
PRELIMINARY NOT FOR CONSTRUCTION
BIDDING PURPOSES
AS BUILT

DATE | RELEASED FOR | ENGR.

DRAWN GINNA STA.
SCALE NONE
ROCHESTER GAS & ELECTRIC CORP. ROCHESTER, NEW YORK

SPRINKLER SYSTEM AT DELUGE VALVES 5228F, 5229F AND 5230F

P & ID

JOB NO.	DRAWING NO.	REV.
EWR 3391E	33013-2355-LR	2
CCD 01	CONTROL COPY #	