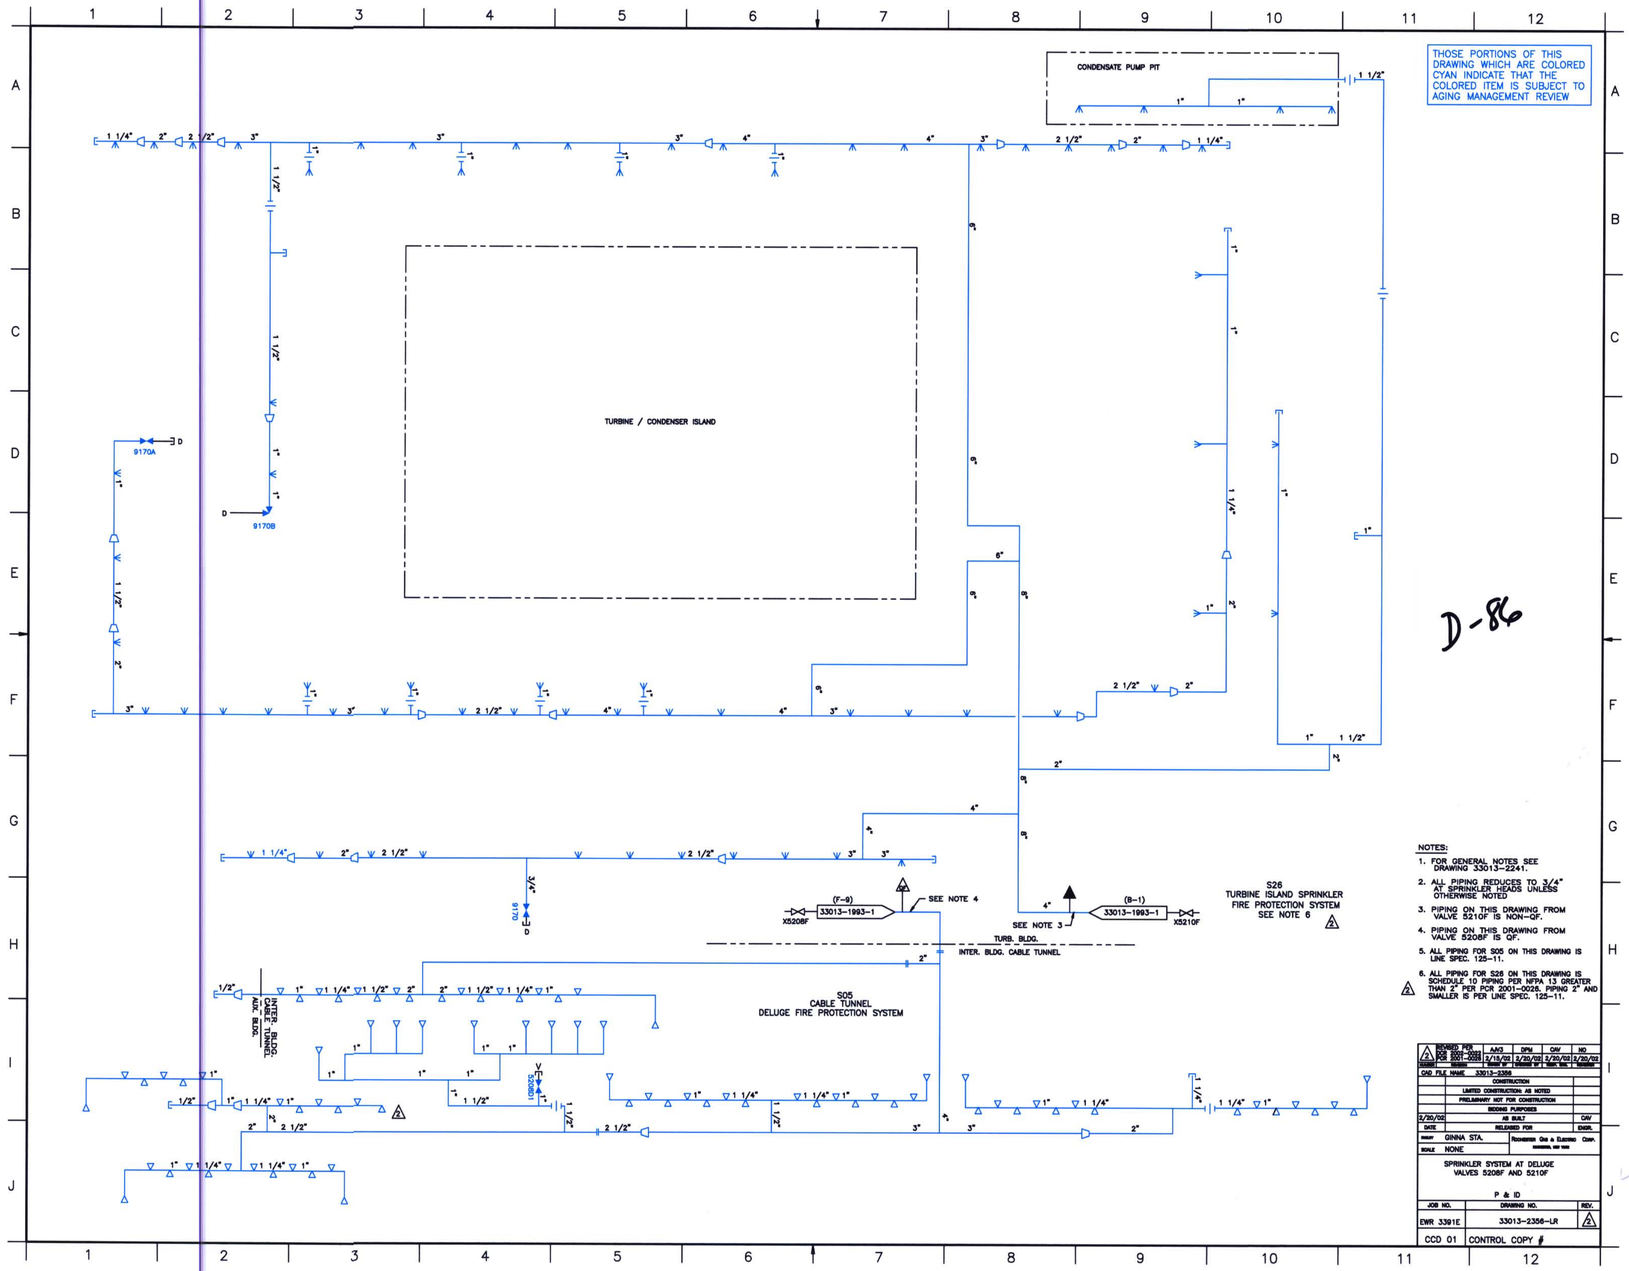

THOSE PORTIONS OF THIS DRAWING WHICH ARE COLORED CYAN INDICATE THAT THE COLORED ITEM IS SUBJECT TO AGING MANAGEMENT REVIEW

D-86

NOTES:

1. FOR GENERAL NOTES SEE DRAWING 33013-2241.
2. ALL PIPING REDUCES TO 3/4" AT SPRINKLER HEADS UNLESS OTHERWISE NOTED
3. PIPING ON THIS DRAWING FROM VALVE 5210F IS NON-QF.
4. PIPING ON THIS DRAWING FROM VALVE 5208F IS QF.
5. ALL PIPING FOR S05 ON THIS DRAWING IS LINE SPEC. 125-11.
6. ALL PIPING FOR S26 ON THIS DRAWING IS SCHEDULE 10 PIPING PER NFPA 13 GREATER THAN 2" PER PCR 2001-0026. PIPING 2" AND SMALLER IS PER LINE SPEC. 125-11.

REV.	REMARKS	1 PLANT SP	REVISED BY	CHKD.	APPROVED

CAD FILE NAME 33013-2356

CONSTRUCTION
LIMITED CONSTRUCTION AS NOTED
PRELIMINARY NOT FOR CONSTRUCTION
BIDDING PURPOSES

3/20/02 AS BUILT CAV

DATE RELEASED FOR ENGR.

DRAWN GINNA STA. REFERENCE: Gen. & Electric Comp. DRAWINGS, SEE NOTE

SCALE NONE

SPRINKLER SYSTEM AT DELUGE VALVES 5208F AND 5210F

P & ID

JOB NO.	DRAWING NO.	REV.
EWR 3391E	33013-2356-LR	4

CCD 01 CONTROL COPY #