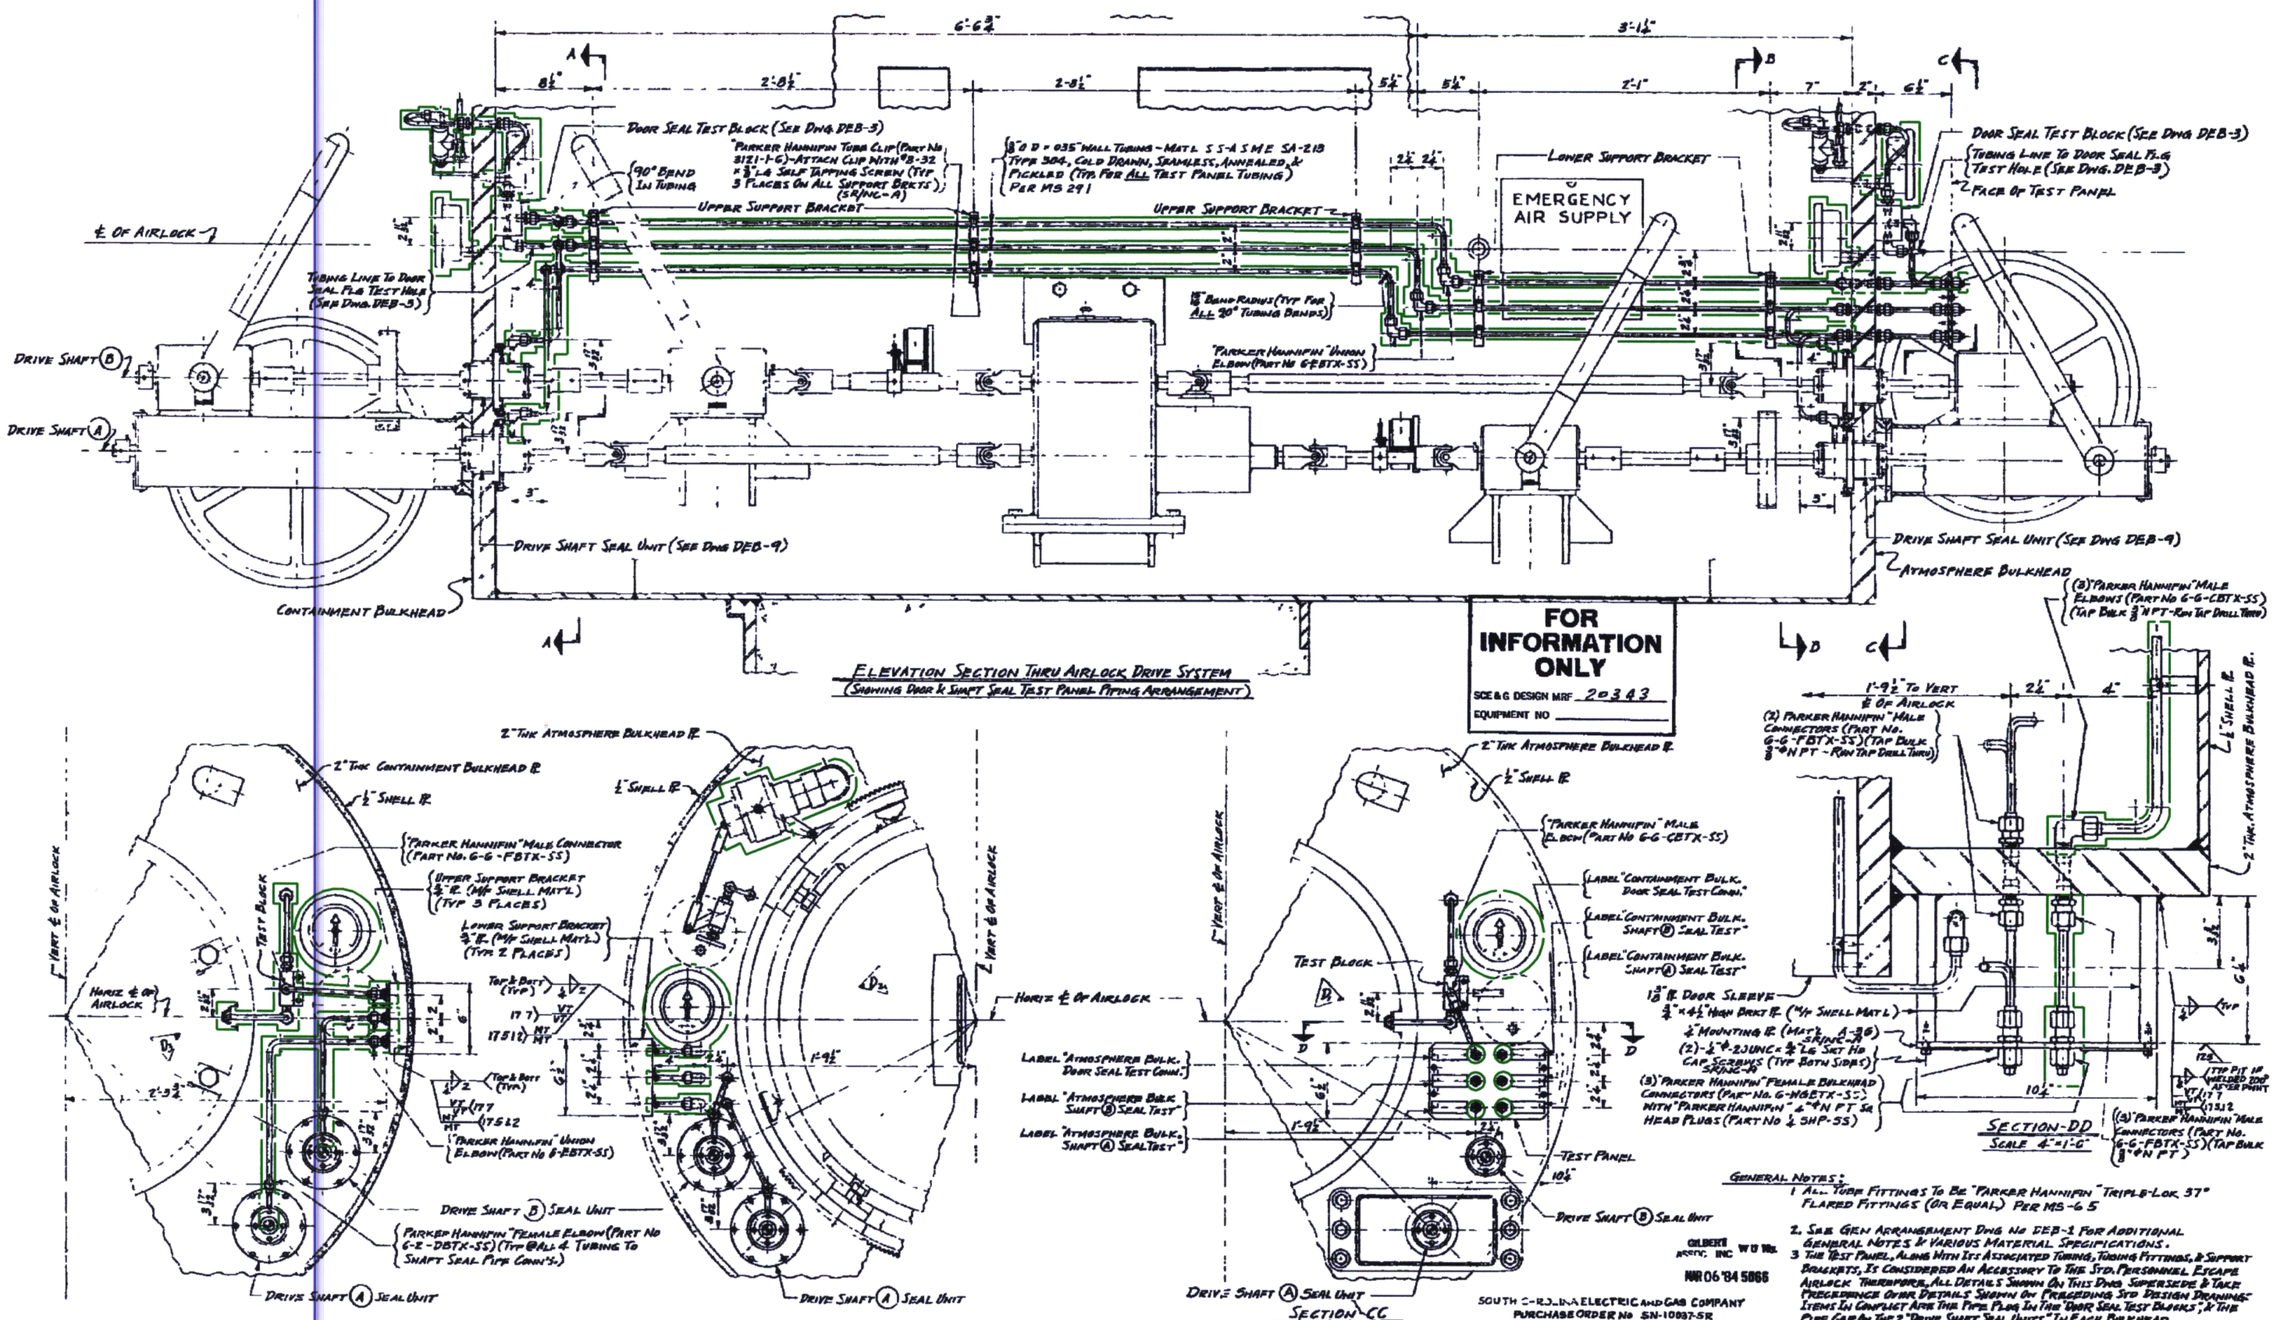

FOR INFORMATION ONLY

SCE&G DESIGN MRF 20343

EQUIPMENT NO

GENERAL NOTES:

1. All Tube Fittings To Be "Parker Hannifin" Triple-Lok 37° Flared Fittings (Or Equal) Per MS-6 5
2. See Gen Arrangement Dwg No DEB-1 For Additional General Notes & Various Material Specifications.
3. The Test Panel, Along With Its Associated Tubing, Tubing Fittings, & Support Brackets, Is Considered An Accessory To The Std. Personnel Escape Airlock. Therefore, All Details Shown On This Dwg Supersede & Take Precedence Over Details Shown On Preceding Std Design Drawings Items In Conflict Are The Pipe Plug In The Door Seal Test Drains, & The Pipe Cap On The 2" Drive Shaft Seal Units In Each Bulkhead.

GILBERT ASSOC. INC W O No. NR 06 '84 5866

SOUTH CAROLINA ELECTRIC AND GAS COMPANY
PURCHASE ORDER No SN-10987-SR

FINAL ISSUE	GLF	7/29/76
START OF DETAIL DRAWING PREPARATION	GLF	7/26/76
CUSTOMER INFORMATION	GLF	7/26/76
MATERIAL PROCUREMENT	GLF	7/26/76
RELEASED FOR	PROJ. ENGR	DATE

REV.	DATE	DESCRIPTION OF REVISION	BY
2-24-84	Dec 23-84	Removed 1/2" Door Handles As-Built	
GLF	Oct 15-79	Rev NC Items To SR/NC-Emergency	
GLF	8-6-22-78	Added Switch Brkt Picture In Elev Sect Light Control Unit Switches Elev Sect Shaft Seal Light Changed Light Brkt Picture In Elev Sect Unit Rt. To Socket Lifeline & Valve In Section-AA	
GLF	A	3-21-78	Revised MS-Nos. & Weld Inspection Nos.
GLF	0	9-24-76	Initial Issue
PROJ. ENGR.	NO.	DATE	DESCRIPTION OF REVISION

PITTSBURGH-DES MOINES STEEL CO.
ENGINEERS-FABRICATORS-CONTRACTORS

Personnel Escape Airlock-V.C. Summer Nuclear Sta
Unit No. 1 - South Carolina Electric & Gas Co.
Door & Shaft Seal Test Panel

	BY	DAT.
DESIGNED	HMR	
DRAWN	HMR	
CHECKED		
SCALE	2"=1'-0" Except Noted	

DESIGN FILE NO
CONTRACT NO 1SC84-520
DRAWING NO DEB-10
DATE 8-16-78

D-5

PLEX Drawing TR00160-006

NO.	DATE	BY	REVISION	CKD. BY	LE APPROVAL

VENDOR/DRAWING NO.:

DESIGN ENGINEERING
V. C. SUMMER NUCLEAR STATION JENKINSVILLE, S.C.

1MS-05-150 | 1

1MS-05-150-5