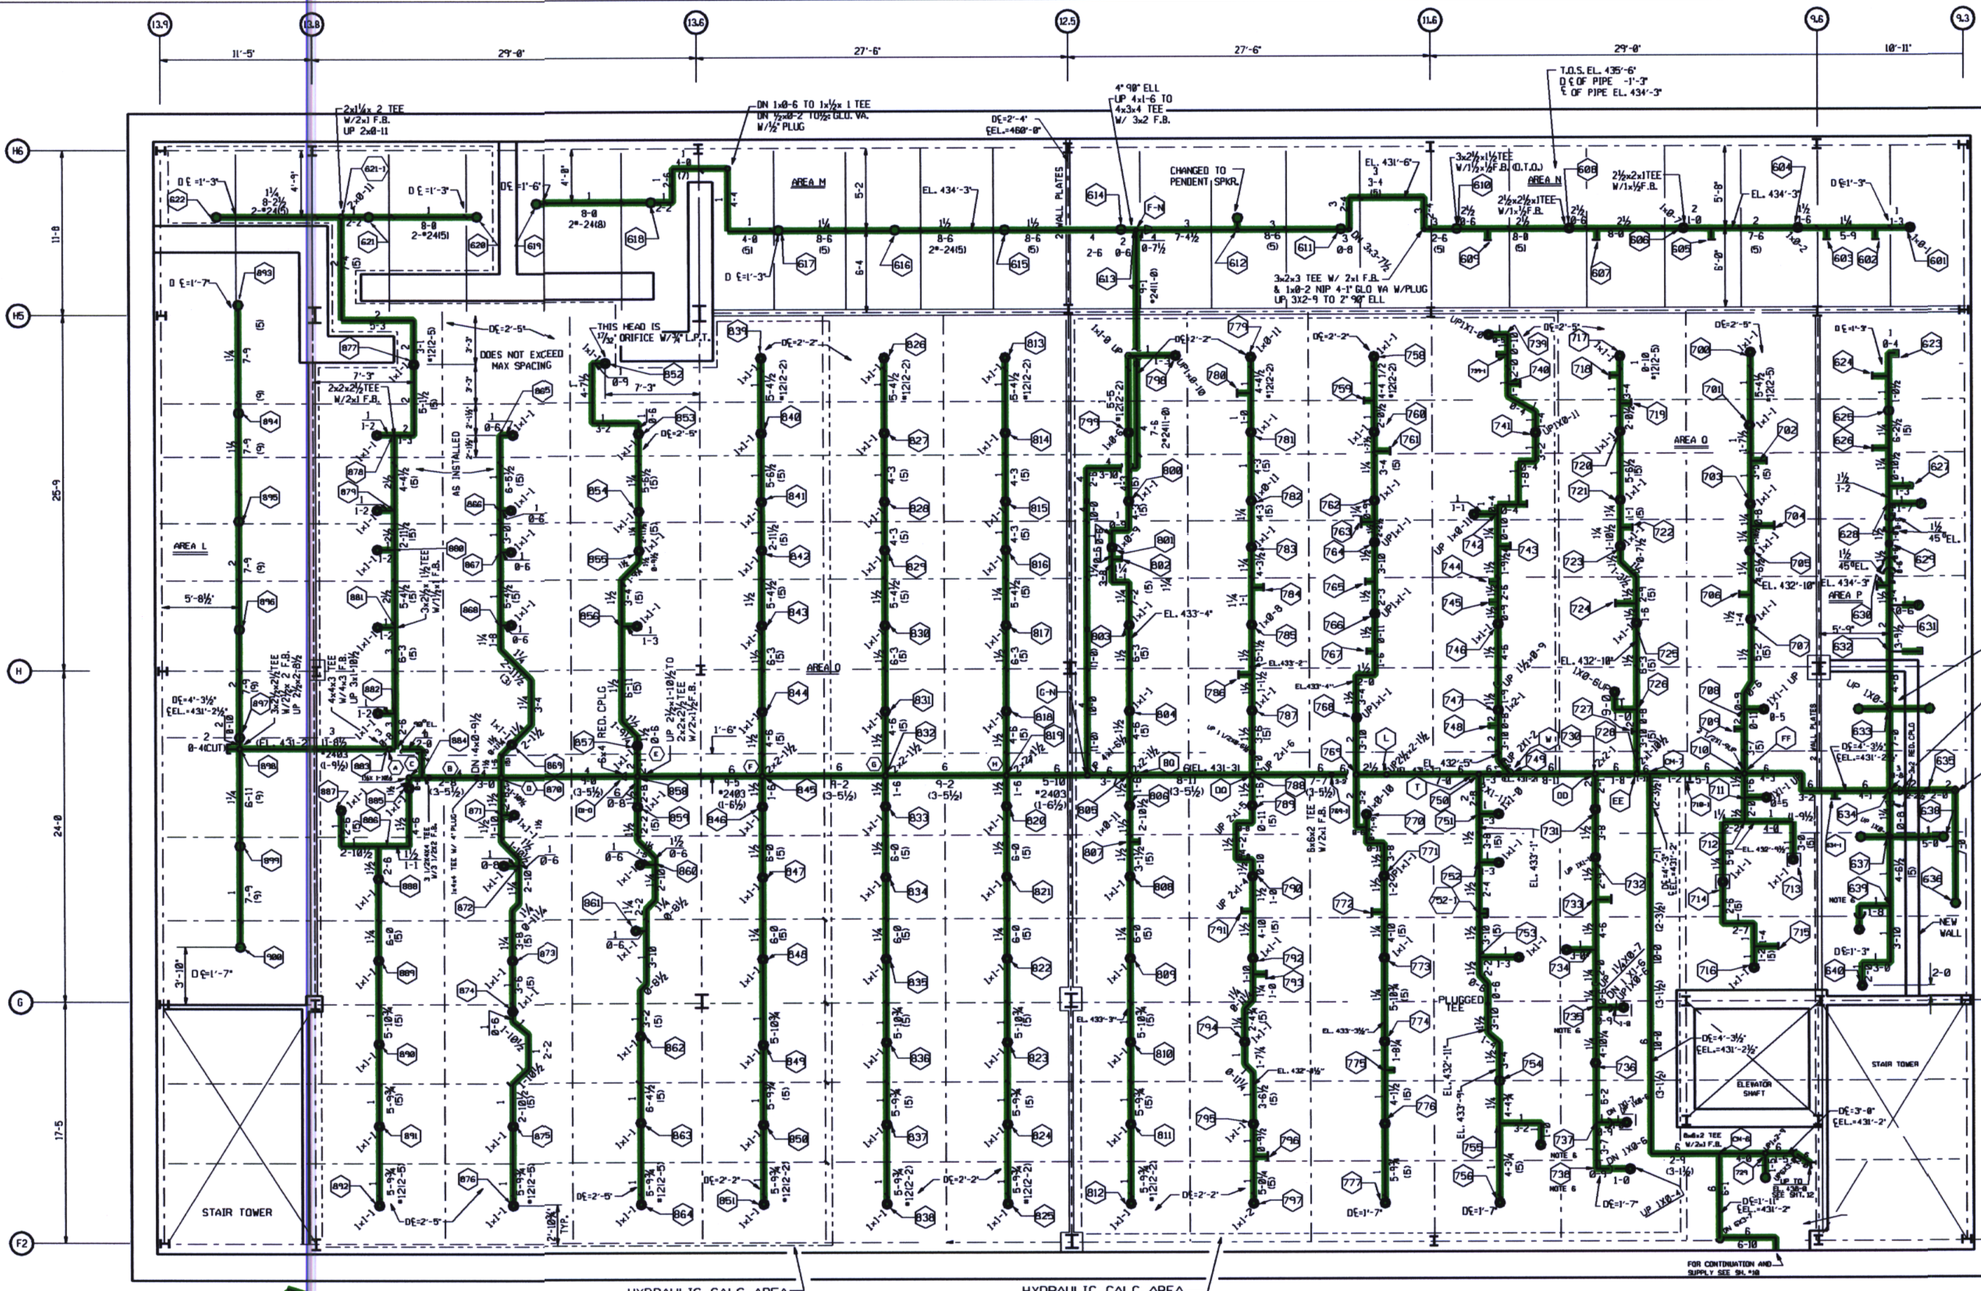
AREA L
AREA M
AREA N
AREA O
AREA P
AREA Q
STAIR TOWER
ELEVATOR SHAFT
NEW WALL
PLUGGED TEE
CHANGED TO PENDENT SPKR.
THIS HEAD IS 17/32" ORIFICE W/¾" I.P.T.
DOES NOT EXCEED MAX SPACING
AS INSTALLED
T.O.S. EL. 435'-6"
℄ OF PIPE -1'-3"
℄ OF PIPE EL. 434'-3"
EL. 434'-3"
EL. 433'-4"
EL. 433'-1"
EL. 432'-10"
EL. 432'-11"
EL. 431'-6"
EL. 434'-3"
EL. 432'-10"
EL. 434'-3"
EL. 431'-2½"
EL. 431'-2½"
EL. 431'-2"
EL. 433'-3½"
EL. 432'-9½"
EL. 433'-2"
