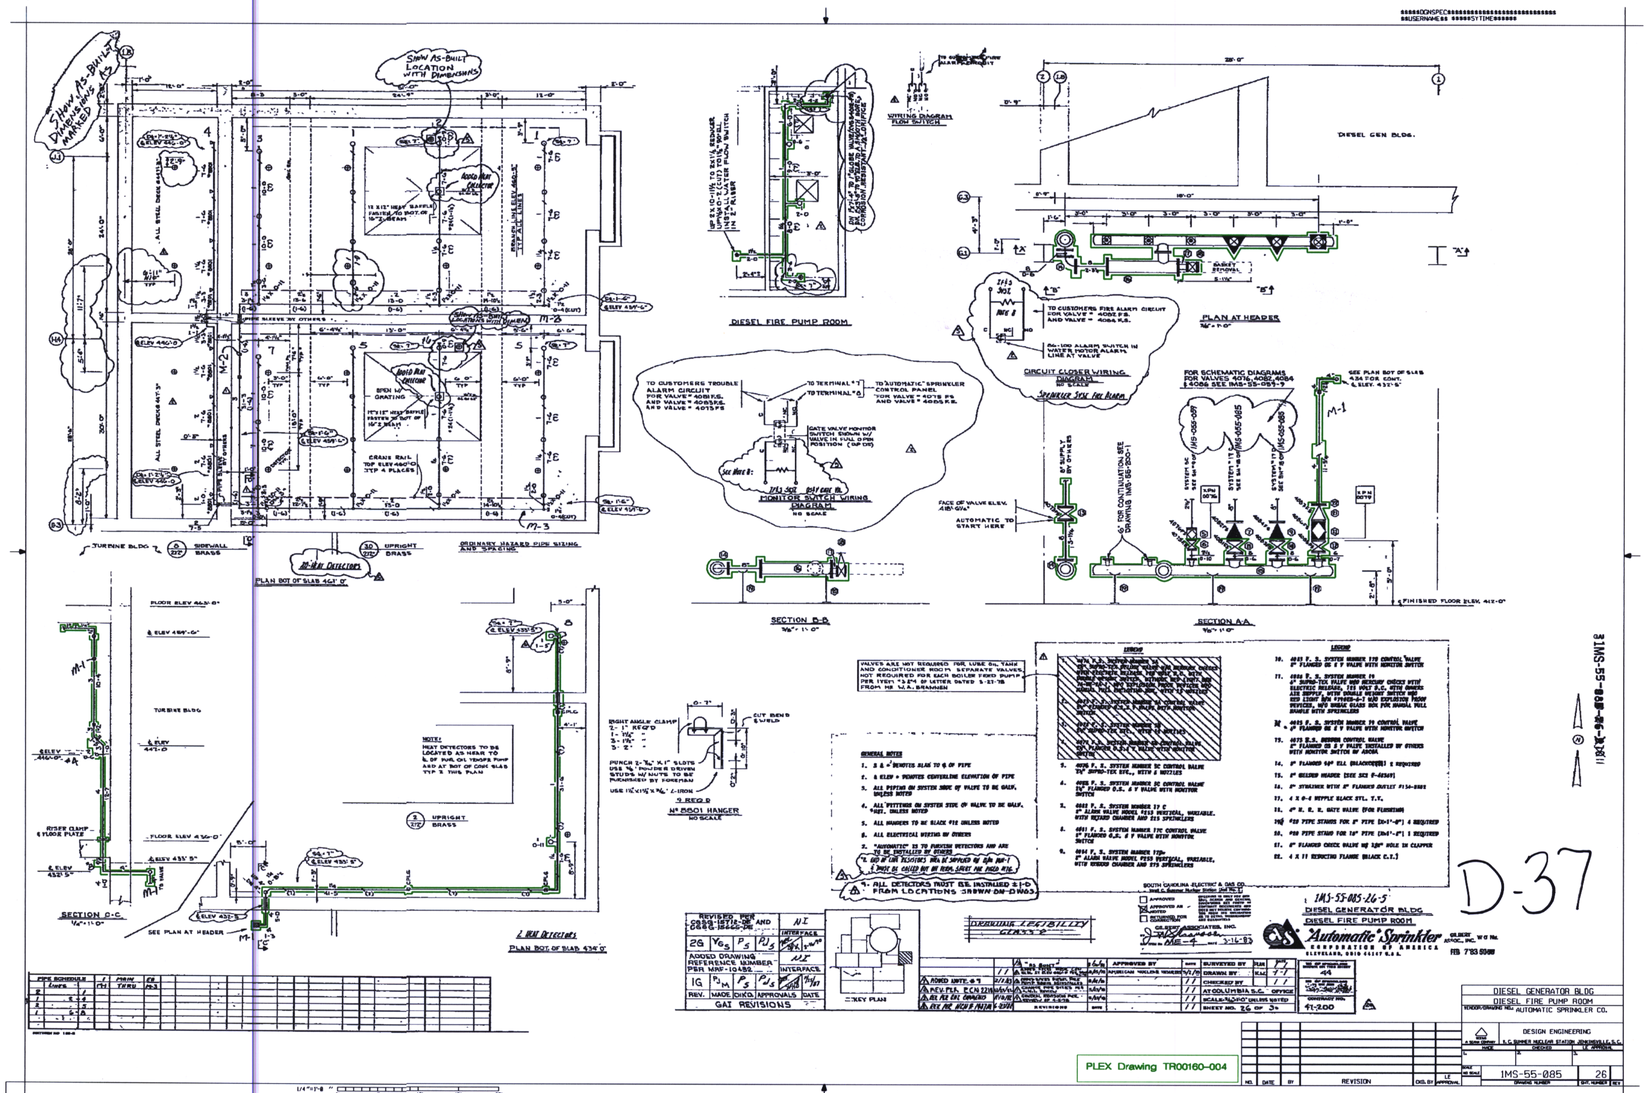

SHOW AS-BUILT LOCATION WITH DIMENSIONS
DIESEL FIRE PUMP ROOM
DIESEL GEN BLDG.
PLAN AT HEADER
CIRCUIT CLOSER WIRING DIAGRAM
MONITOR SWITCH WIRING DIAGRAM
SECTION B-B
SECTION A-A
SECTION C-C
PLAN BOT OF SLAB 461'-0"
PLAN BOT OF SLAB 434'-0"
ORDINARY HAZARD PIPE SIZING AND SPACING
TURBINE BLDG
SEE PLAN AT HEADER
FINISHED FLOOR ELEV. 442'-0"
DRAWING LEGIBILITY CLASS D
GAT REVISIONS
DIESEL GENERATOR BLDG
DIESEL FIRE PUMP ROOM
"Automatic" Sprinkler
CORPORATION OF AMERICA
DESIGN ENGINEERING
IMS-55-085
26
PLEX Drawing TR00160-004

D-37