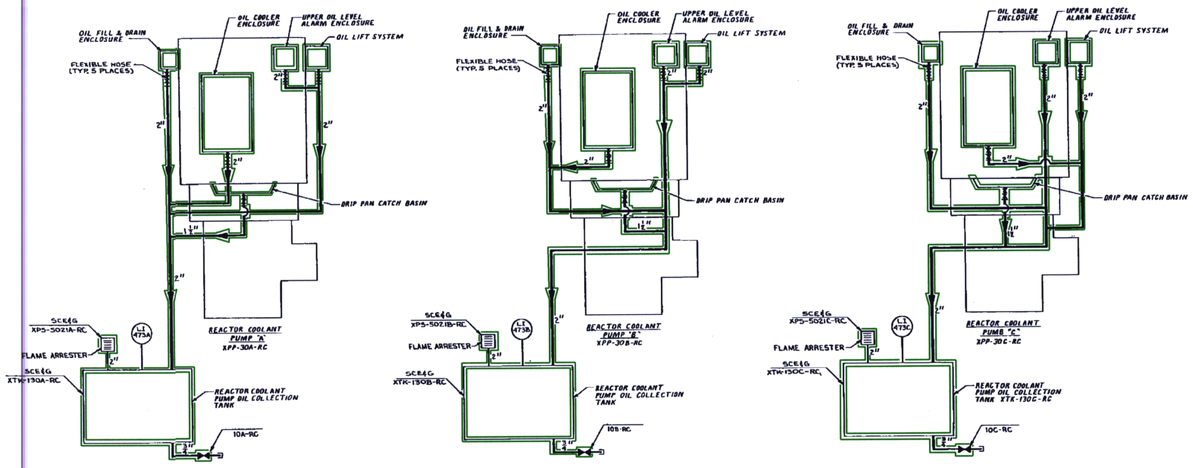

PIPING THIS DRAWING TO BE LINE SPEC. 155X

D-86

0	07/31/03	DMB	AS BUILT PER E.O.M. EI-7	PJM	PJS	
NO.	DATE	BY	REVISION	CHD. BY	LE APPROVAL	

DRAWING LEGIBILITY
CLASS 1
SCE&G CAD ENHANCED

PLEX Drawing TR00160-002

SOUTH CAROLINA ELECTRIC & GAS COMPANY

VIRGIL C. SUMMER NUCLEAR STATION

PIPING — SYSTEM FLOW DIAGRAM
REACTOR COOLANT PUMPS
OIL COLLECTION SYSTEM
DESIGN ENGINEERING

V. C. SUMMER NUCLEAR STATION JENKINSVILLE, S.C.

SIZE	CHECKED	LE APPROVAL
RJS	PJM	PJS

DRAWING NUMBER	SHT. NUMBER	REV.
D-302-606		0