


FOR REFERENCE ONLY

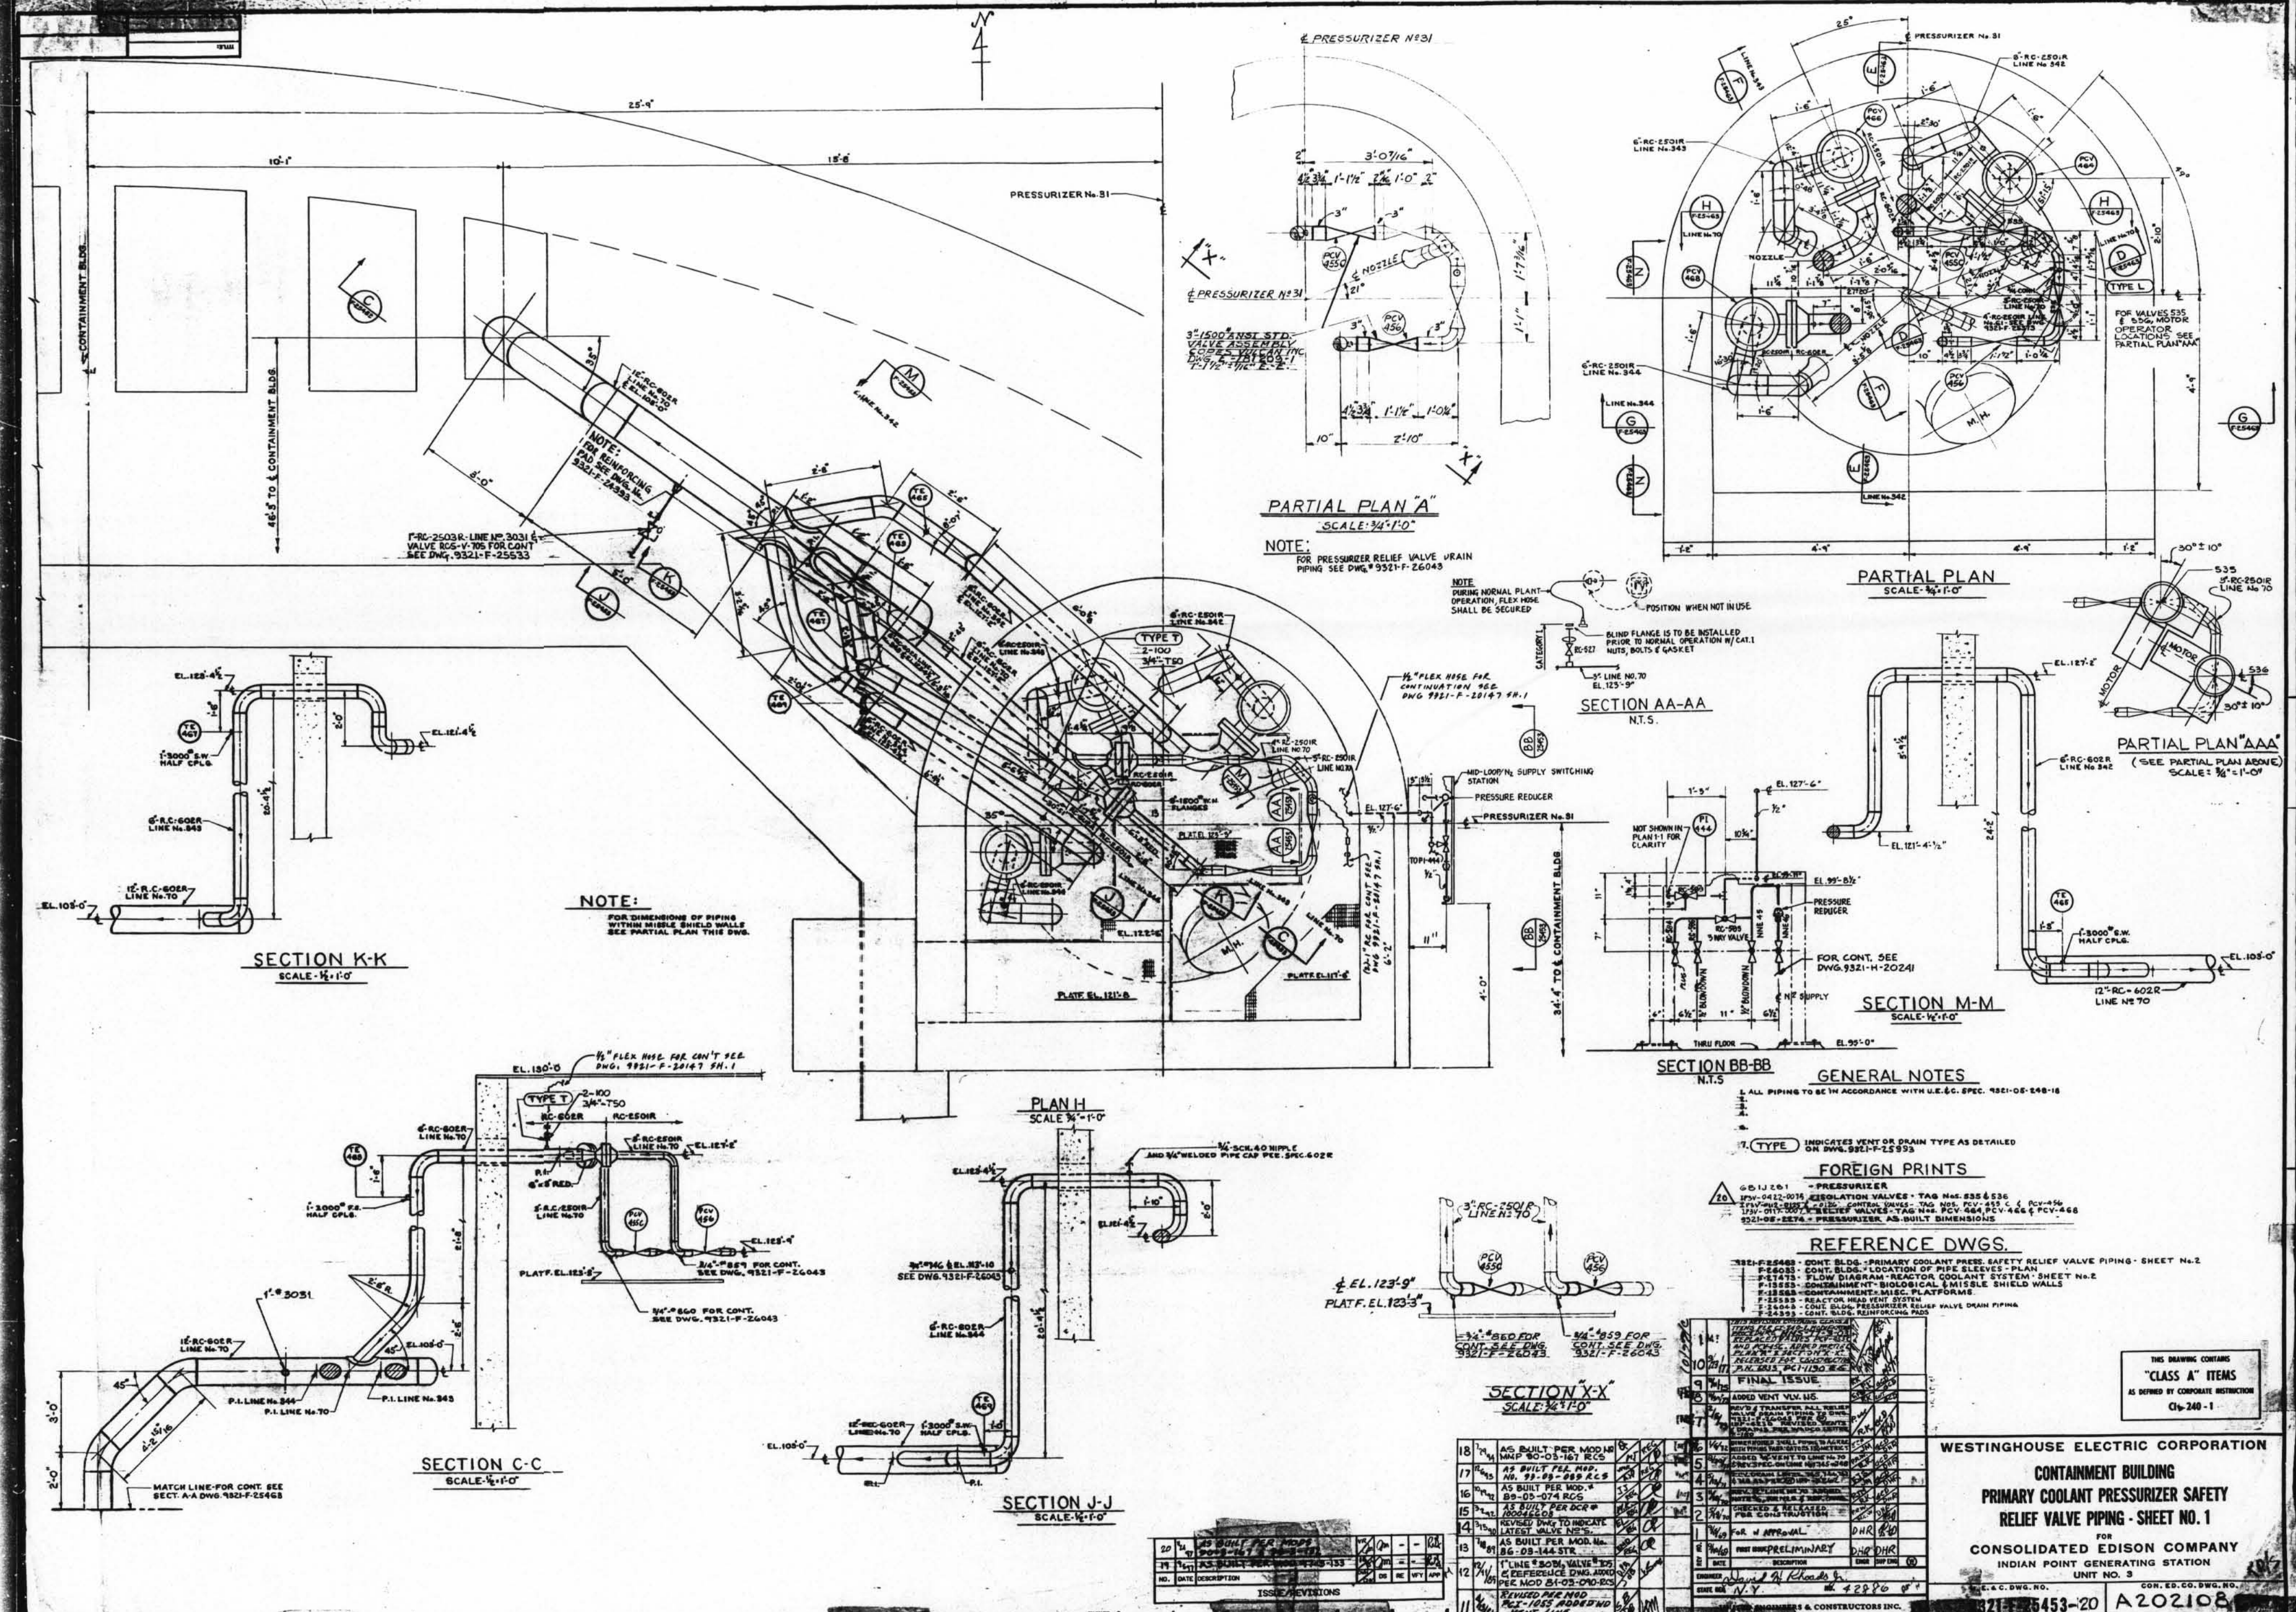

GENERAL NOTES

1. ALL PIPING TO BE IN ACCORDANCE WITH U.E.C. SPEC. 9321-05-248-16

2. TYPE INDICATES VENT OR DRAIN TYPE AS DETAILED

FOREIGN PRINTS





REFERENCE DWGS.








THIS DRAWING CONTAINS
"CLASS A" ITEMS
AS DEFINED BY CORPORATE INSTRUCTION
CIS-240-1

WESTINGHOUSE ELECTRIC CORPORATION
CONTAINMENT BUILDING
PRIMARY COOLANT PRESSURIZER SAFETY
RELIEF VALVE PIPING - SHEET NO. 1
FOR
CONSOLIDATED EDISON COMPANY
INDIAN POINT GENERATING STATION
UNIT NO. 3


9321-F-25453-20 A202108