U.E.&C.

9321-F-25463

FOR REFERENCE ONLY

FOR REFERENCE ONLY

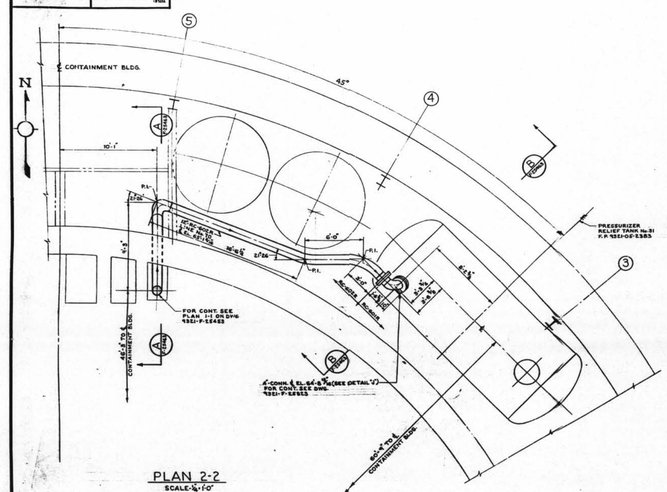

PLAN 2-2
SCALE-1/8"=1'-0"

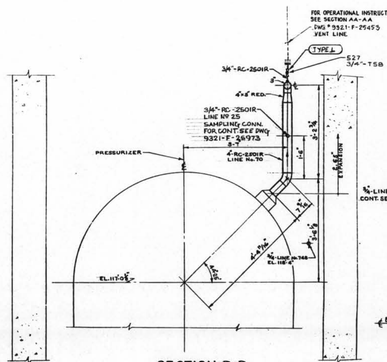

SECTION D-D
SCALE-3/8"=1'-0"

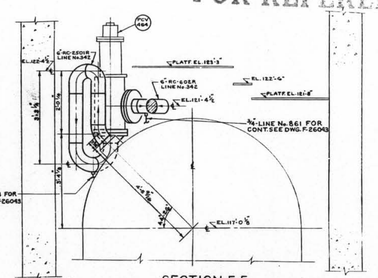

SECTION E-E
SCALE-3/8"=1'-0"

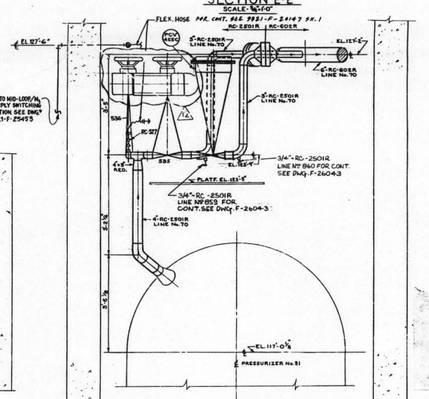

SECTION H-H
SCALE-3/8"=1'-0"

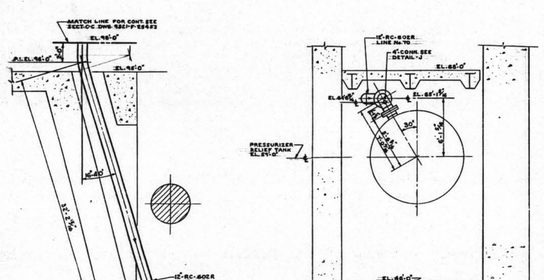

SECTION B-B
SCALE-1/4"=1'-0"

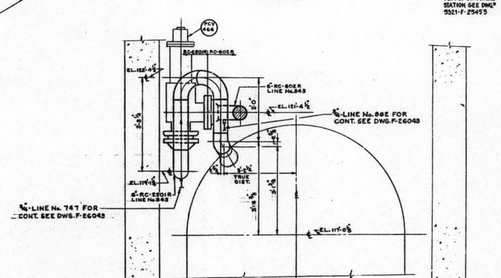

SECTION F-F
SCALE-3/8"=1'-0"

SECTION A-A
SCALE-1/4"=1'-0"

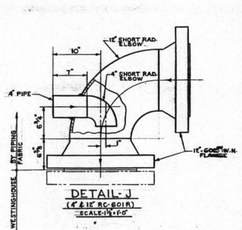

DETAIL-J
(4" & 12" RC-801R)
SCALE-1"=1'-0"

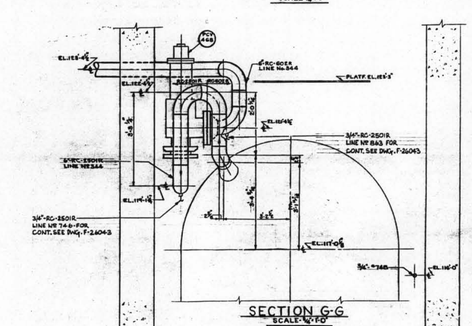

SECTION G-G
SCALE-3/8"=1'-0"

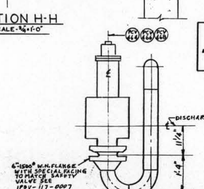

SECTION N-N
SCALE-3/4"=1'-0"
(TYPICAL FOR LINES 4"-RC-5 & 4"-RC-6)

THIS DRAWING CONTAINS "CLASS A" ITEMS AS DEFINED BY CORPORATE INSTRUCTION CI-240-1

WORK THIS DWG. WITH 9321-F-25453

D		AS BUILT PER MOD # 03-05-004 RCS		
C		REVISED DWG. TO INDICATE LATEST WELDS MADE		
B		REVISED DWG. TO INDICATE ADDED WD'S VENT LINE		
A		FINAL ISSUE		
12		REVS & TRANSFERS ALL RELIEF VALVE CHGS FROM DWG. 9321-F-24494 PER MP-A-257		
11		REVISED PER MP-A-257		
10		AS BUILT PER MOD 03 MP-P-50-05-107 RCS		
9		AS BUILT PER MP-P-15-187 CCS & MOD MP-P-15-176		
8		FIRST ISSUE PRELIMINARY	DWK	
REVISION	DATE	DESCRIPTION	DRAWN	CHK'D

DESIGNED BY: [illegible]
DRAWN BY: [illegible]
CHECKED BY: [illegible]
APPROVED BY: [illegible]

DESIGNED ENGINEERS & CONSTRUCTORS INC.

WESTINGHOUSE ELECTRIC CORPORATION

CONTAINMENT BUILDING
PRIMARY COOLANT PRESSURIZER SAFETY RELIEF VALVE PIPING - SHEET NO. 2

FOR
CONSOLIDATED EDISON COMPANY
INDIAN POINT GENERATING STATION
UNIT NO. 3

U.E.&C. DWG. NO. 9321-F-25463-12

CON. ED. CO. DWG. NO. A20210

D-03