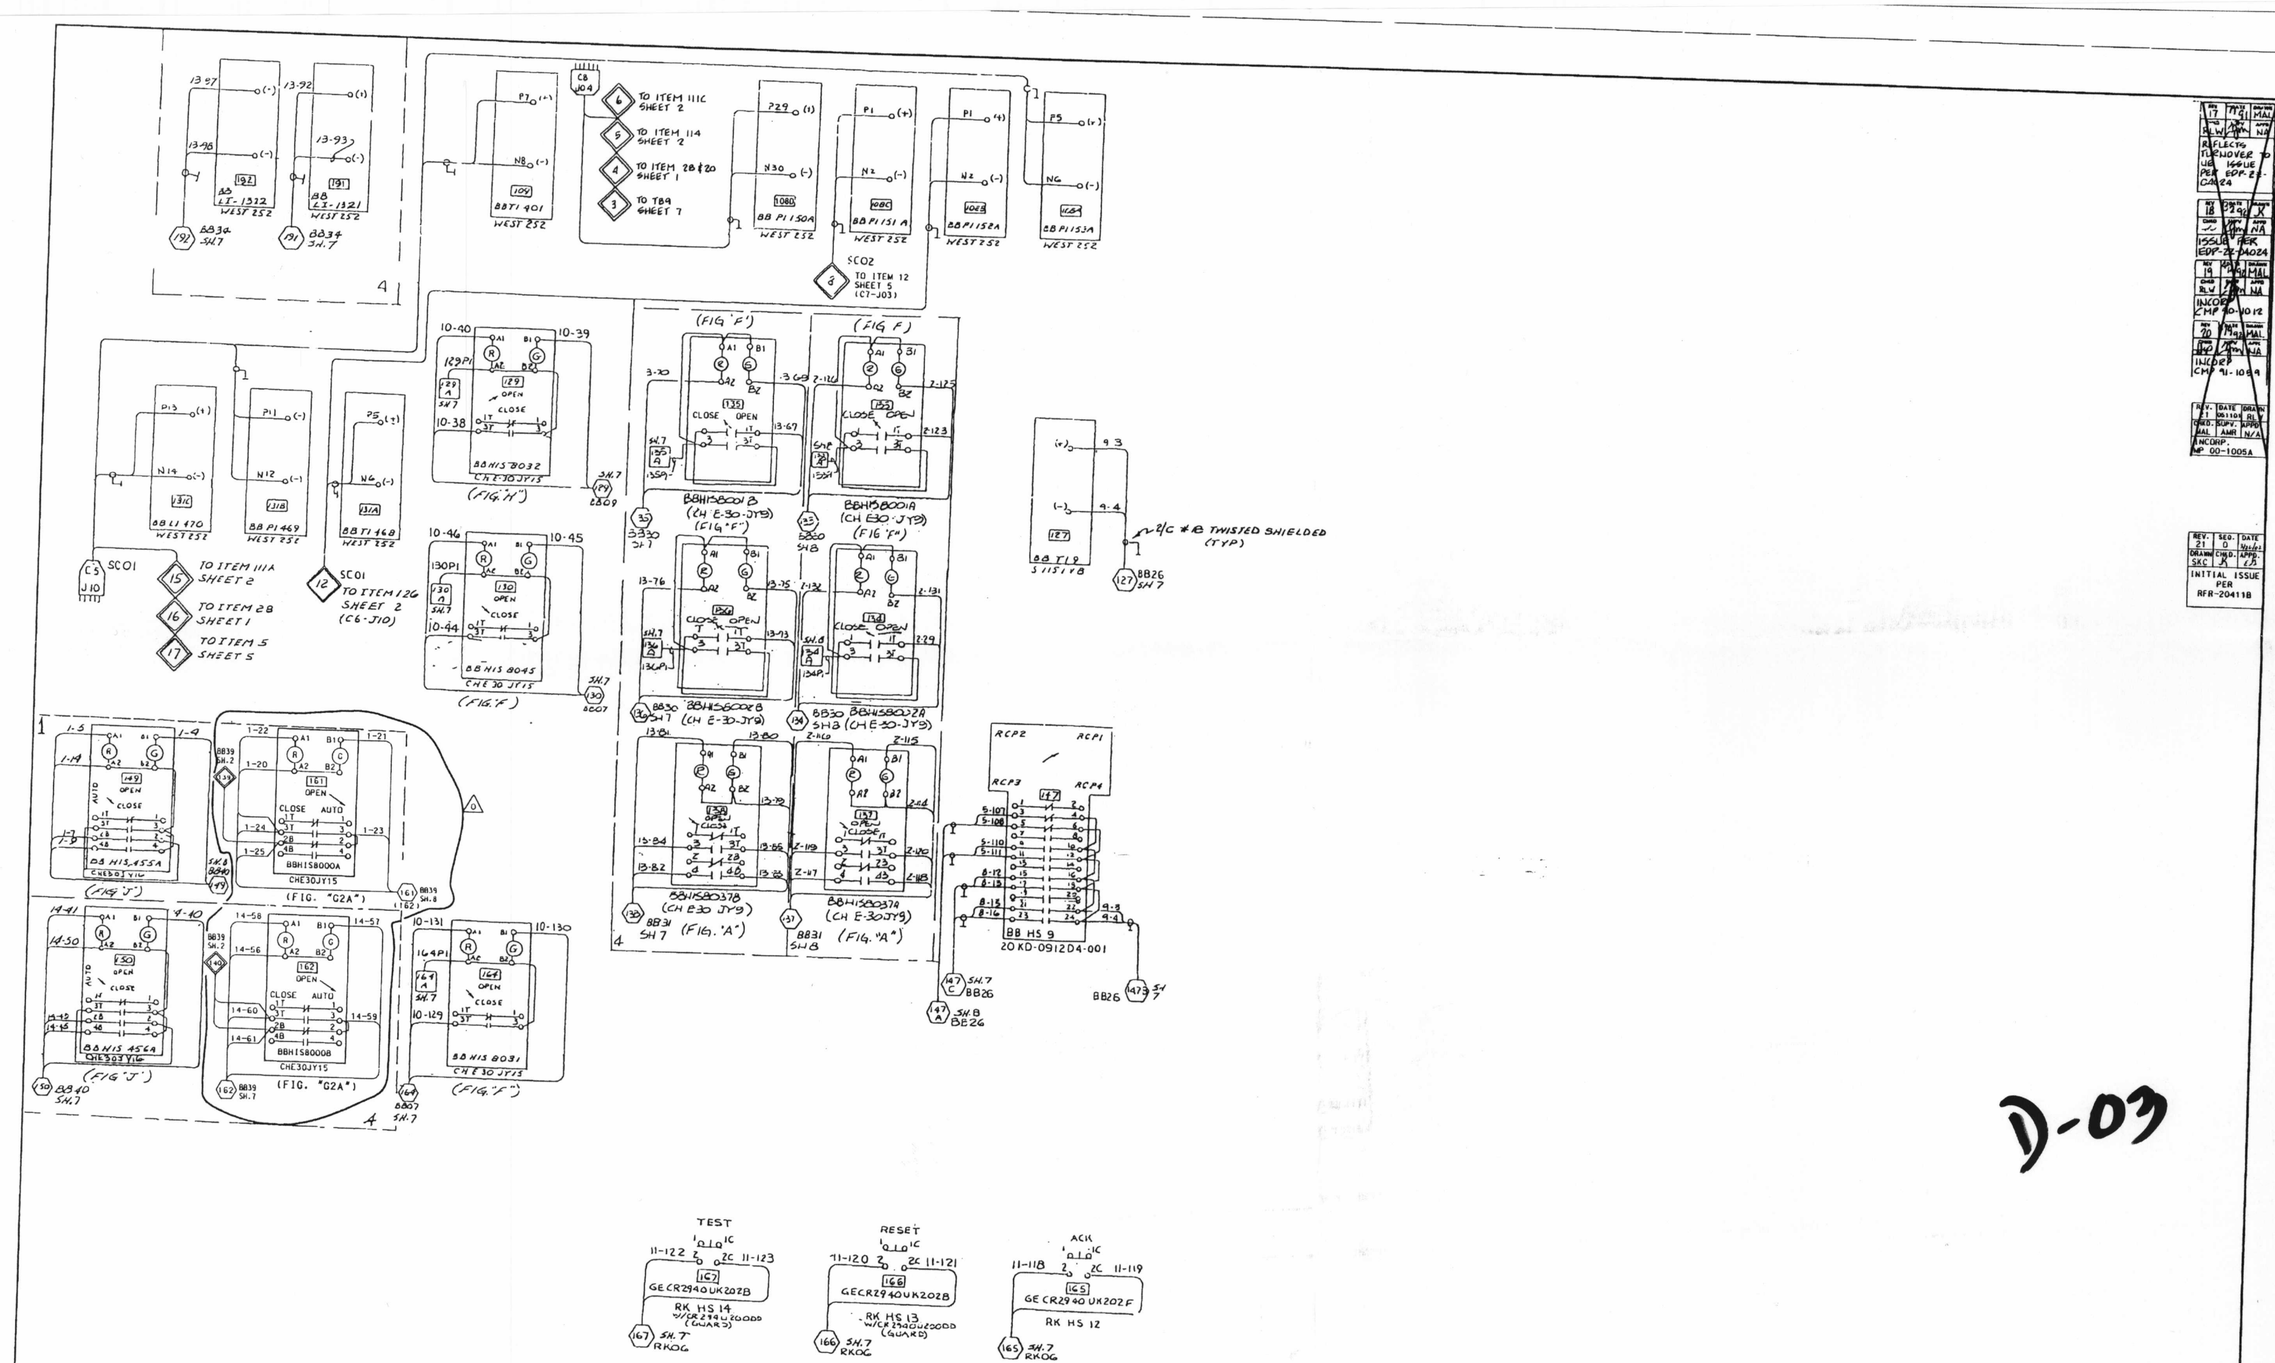


D-03

| RFR NO. | DRAWING NO. | REV. | SEQ. |
|---|---|---|---|
| 20411B | J-200-00055 | 021 | 000 |

SYSTEM: RL ~~AS BUILT~~

| DRAWING NO. | REV. |
|---|---|
| ~~J-200-00055~~ | ~~21~~ |

**Comsip Customline, Corp.**
LINDEN, NEW JERSEY

TITLE: MAIN CONTROL BOARD RL021 & RL022 WIRING DIAGRAM

PROJECT BECHTEL GAITHERSBURG, MD SNUPPS

| | | | |
|---|---|---|---|
| DRWN BY OA | DATE 7-12-77 | SCALE NTS | APPD FOR CONST |
| CHKD BY WVA | DATE 7-15-77 | DRAWING NO | REV NO |
| APPD BY | DATE 8-22-77 | ~~J-200-00055~~ | ~~21~~ |

39J & ITD