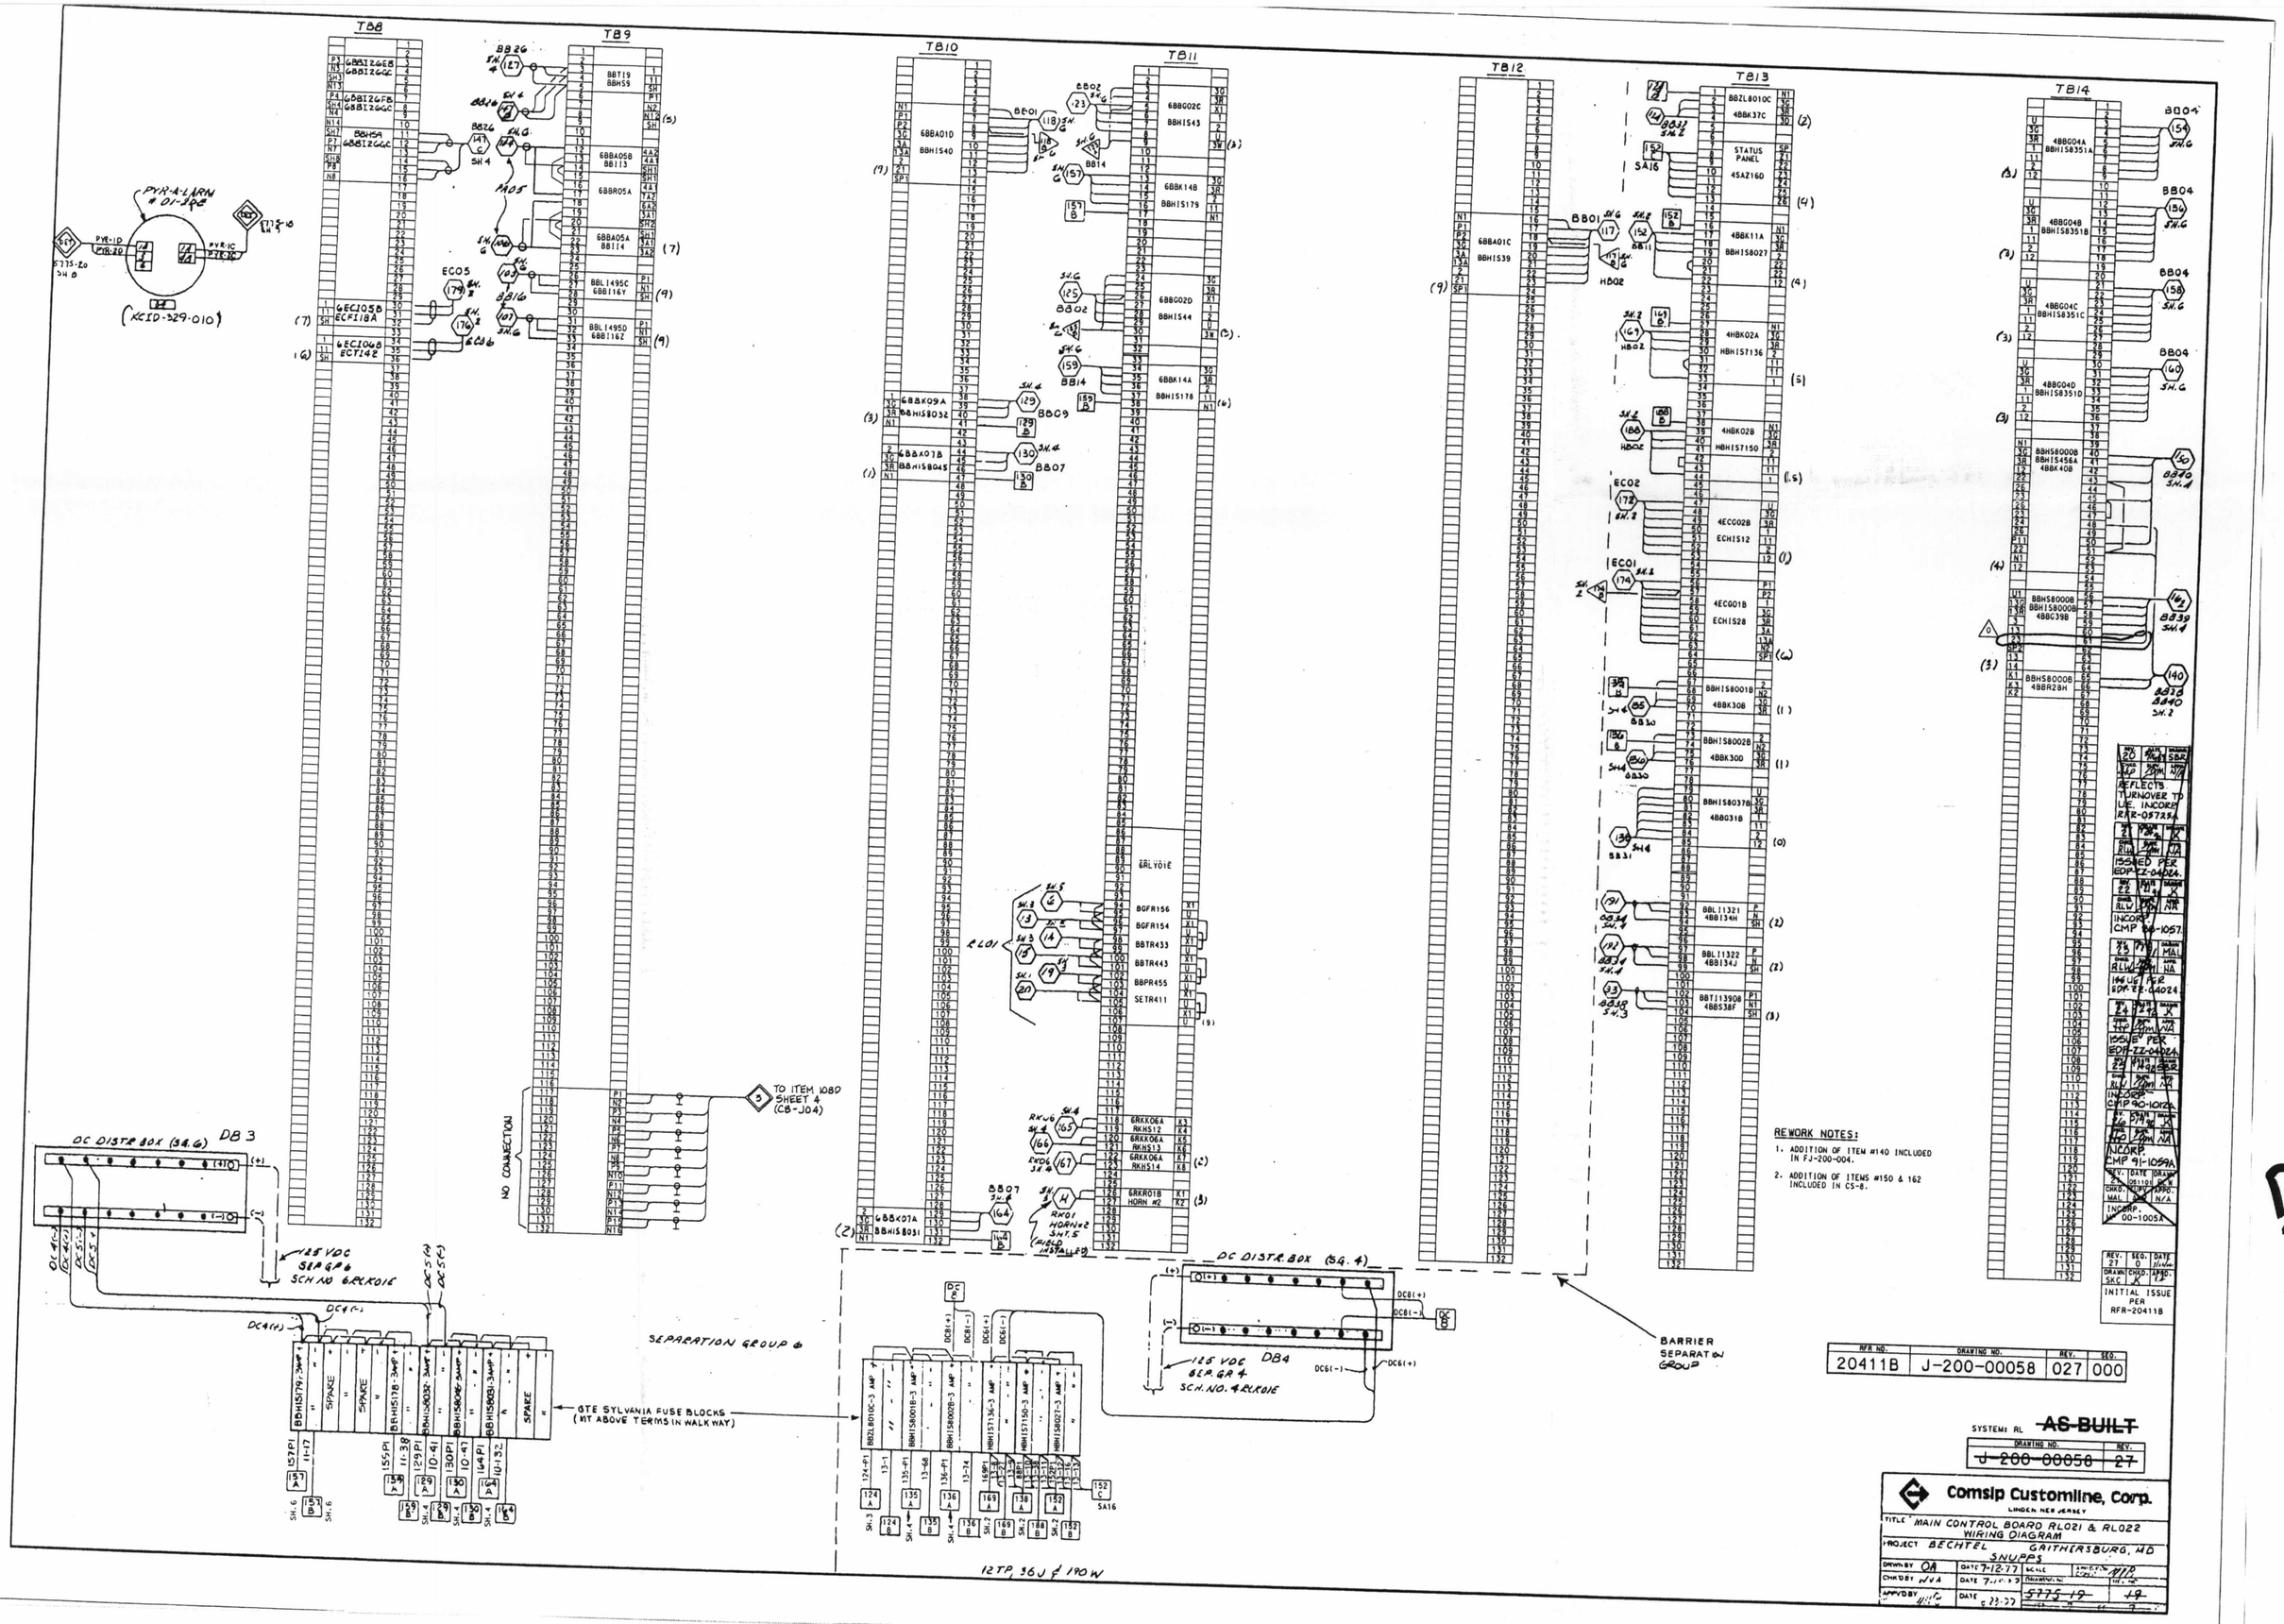

REWORK NOTES:

1. ADDITION OF ITEM #140 INCLUDED IN FJ-200-004.
2. ADDITION OF ITEMS #150 & 162 INCLUDED IN CS-8.

RFR NO.	DRAWING NO.	REV.	SEQ.
20411B	J-200-00058	027	000

SYSTEM: RL ~~AS-BUILT~~

DRAWING NO.	REV.
~~J-200-00058~~	~~27~~

Comsip Customline, Corp.
LINDEN NEW JERSEY

TITLE: MAIN CONTROL BOARD RL021 & RL022 WIRING DIAGRAM

PROJECT: BECHTEL GAITHERSBURG, MD SNUPPS

DRWN BY: OA	DATE: 7-12-77	SCALE:	APPROVED BY: MJR
CHKD BY: NVA	DATE: 7-12-77	DRAWING NO.: ~~5775-19~~	REV. NO.: ~~19~~
APPVD BY: [illegible]	DATE: 5-23-77		

D-C