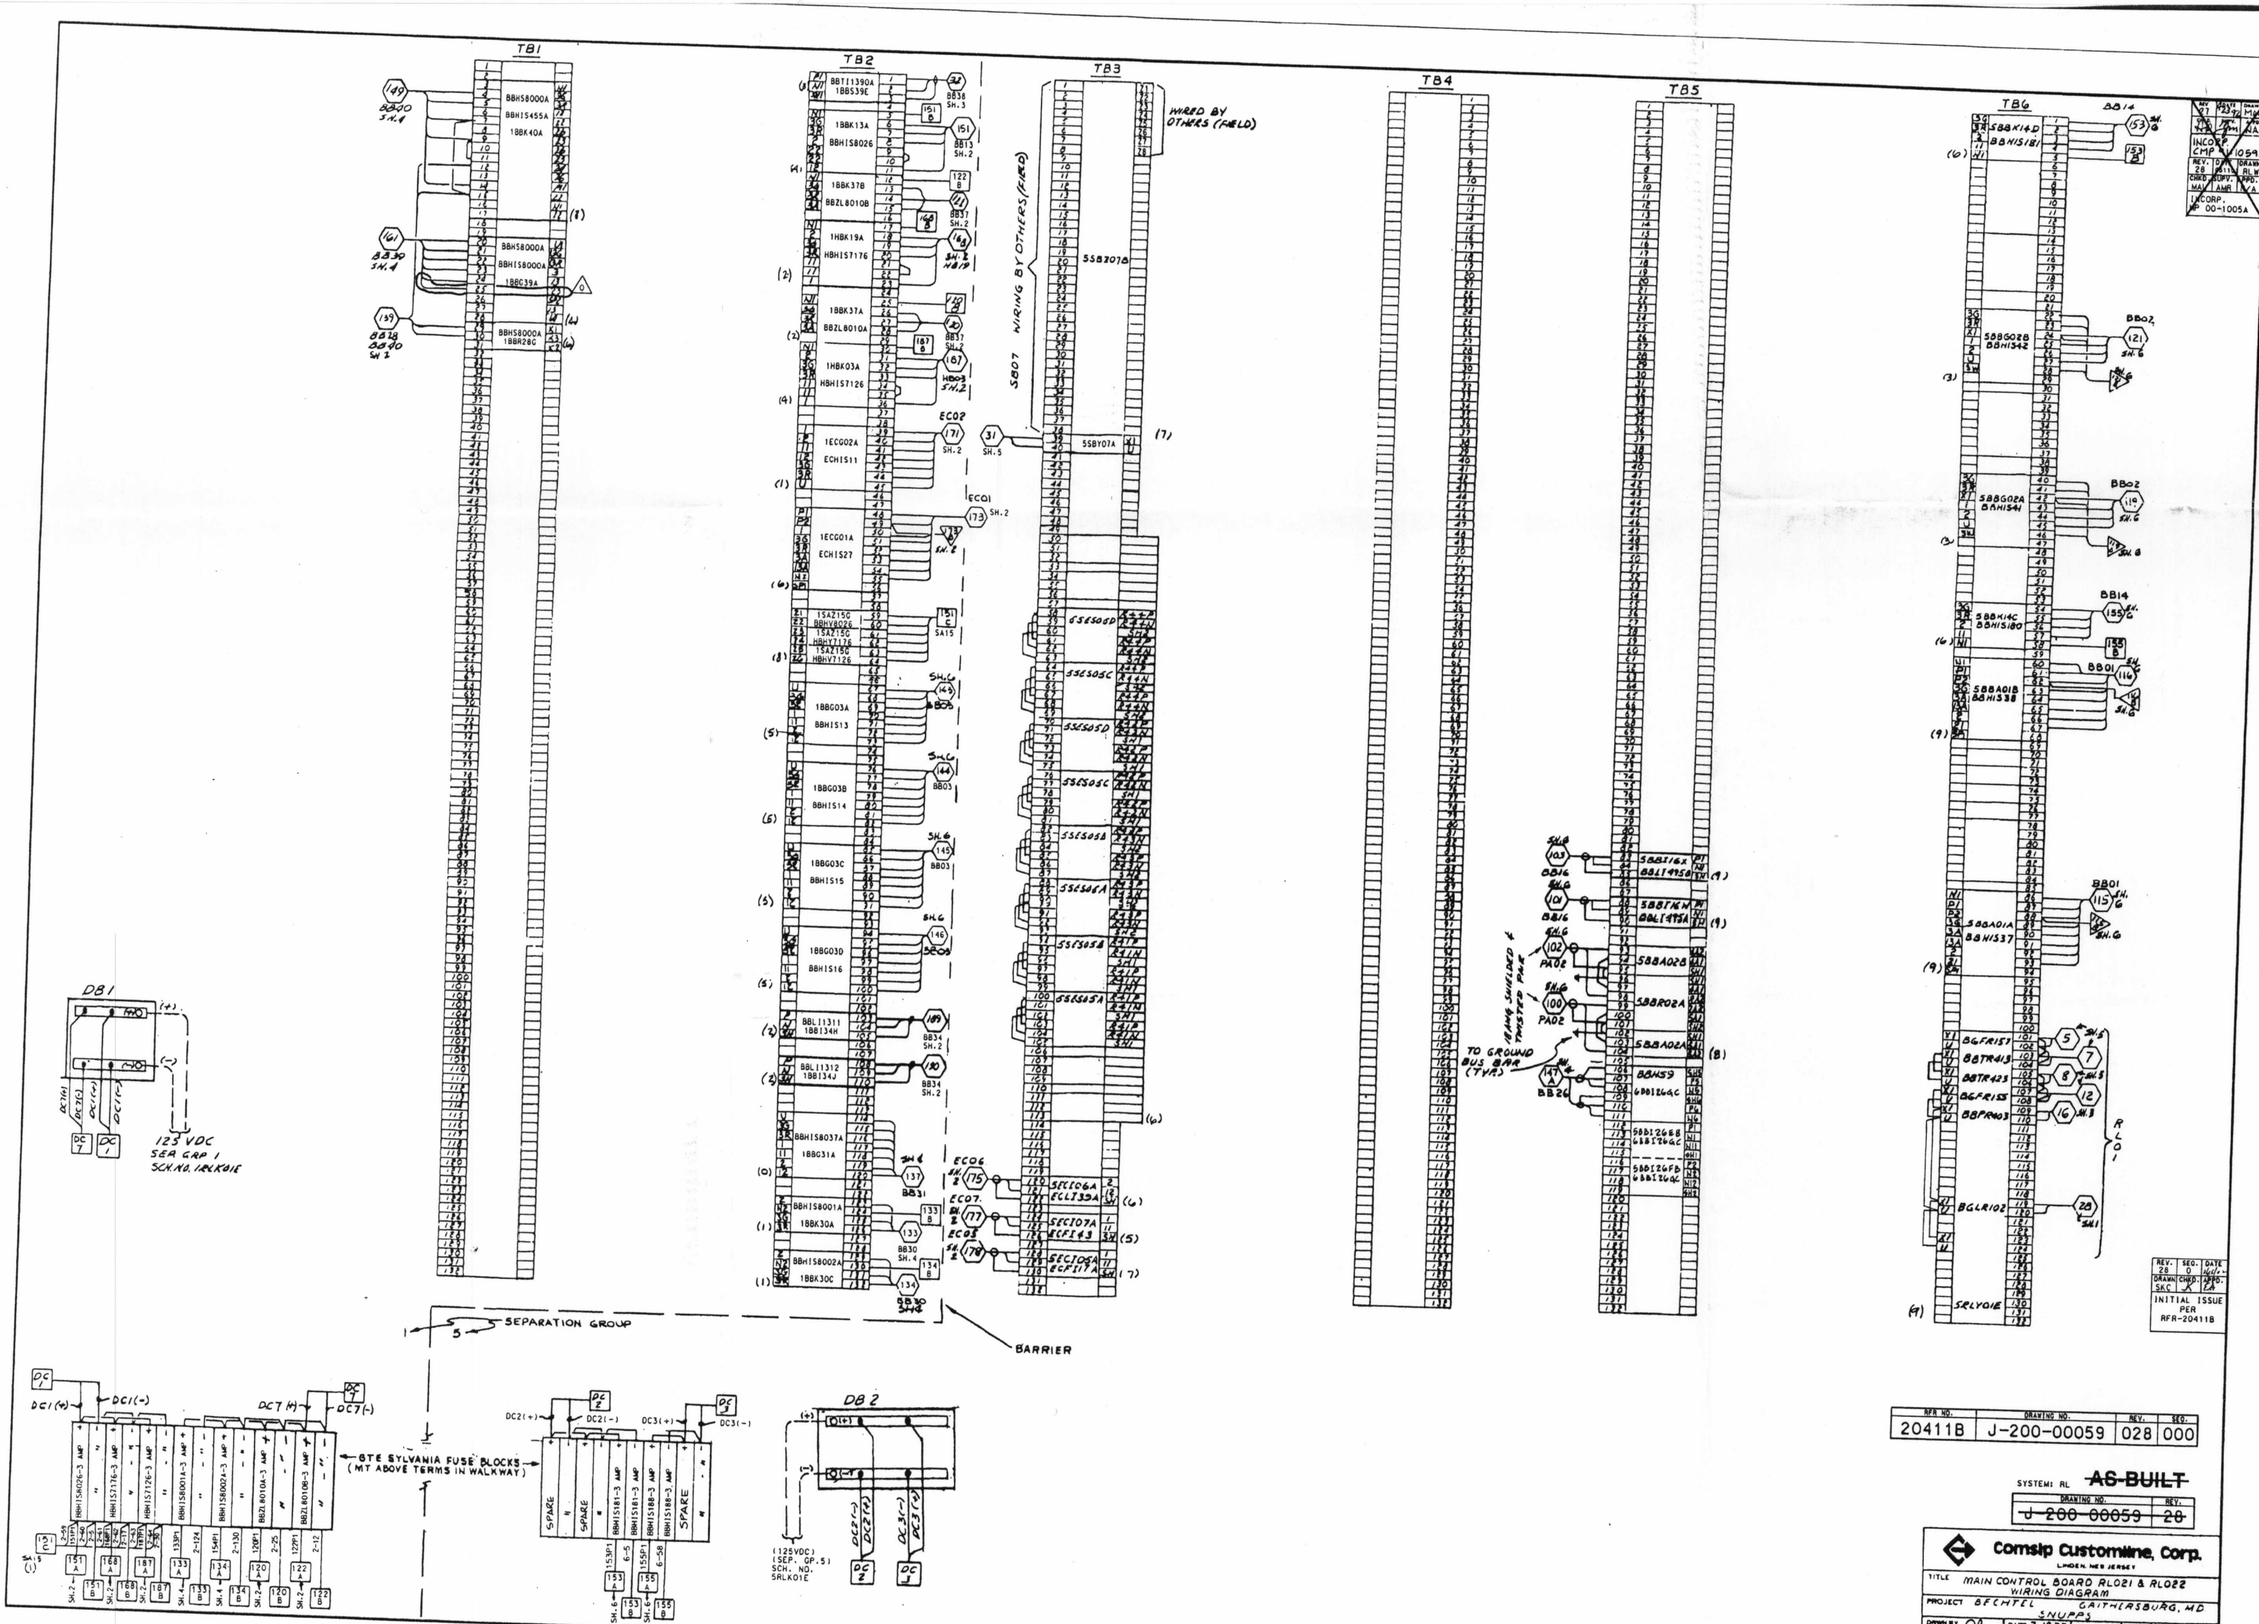

D-05

RFR NO.	DRAWING NO.	REV.	SEQ.
20411B	J-200-00059	028	000

SYSTEM: RL ~~AS-BUILT~~

DRAWING NO.	REV.
~~J-200-00059~~	~~28~~

Comsip Customline, Corp.
LINDEN, NEW JERSEY

TITLE: MAIN CONTROL BOARD RL021 & RL022 WIRING DIAGRAM

PROJECT: BECHTEL GAITHERSBURG, MD SNUPPS

DRAWN BY: OA	DATE: 7-12-77	SCALE	APP'D FOR CONST: MB
CHK'D BY: WVA	DATE: 8-10-77	DRAWING NO: 5775-19	REV NO: 19
APP'D BY: MB	DATE: 8-23-77	SHEET	