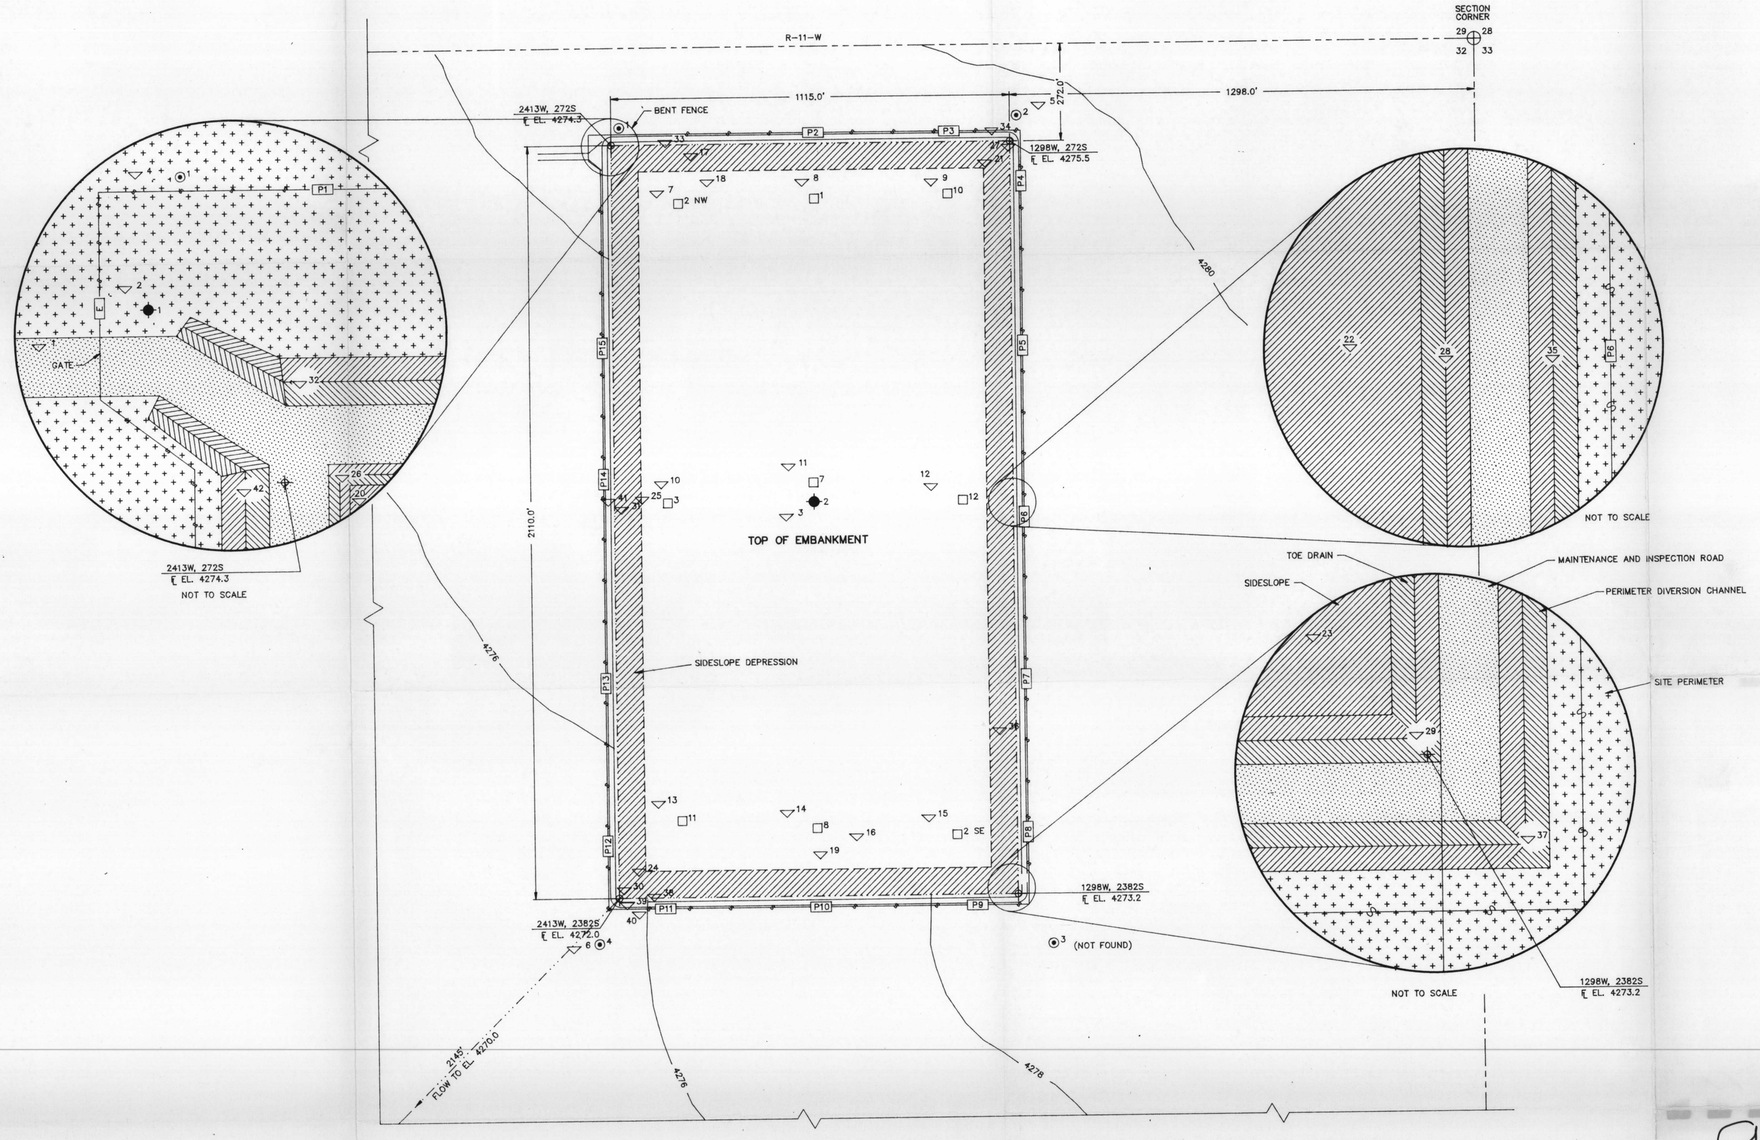

NOTES:

1. THIS DRAWING IS BASED ON DRAWING NUMBER S.L.C.-CL-0017 OF THE SALT LAKE CITY, UTAH, CLIVE SITE FINAL GRADING PLAN. THE ORIGINAL DRAWING WAS PRODUCED BY THE UTAH DEPARTMENT OF TRANSPORTATION, DISTRICT 2 FOR THE DEPARTMENT OF ENERGY UMTRA PROJECT OFFICE.
2. NO PERMANENT SURVEY MONUMENTS EXIST. IN LIEU OF PERMANENT SURVEY MONUMENTS WITHIN THE DESIGNATED SITE BOUNDARY, THREE SECTION CORNER MONUMENTS (SOUTHWEST, NORTHWEST, AND NORTHEAST) OF SECTION 32, TOWNSHIP 2 SOUTH, RANGE 11 WEST WERE USED.
3. THE SCALE FOR THIS DRAWING IS APPROXIMATE AT BEST. SINCE NO AS-BUILT DRAWINGS CURRENTLY EXIST, LOCATIONS AND SIZES OF FEATURES IN MANY CASES ARE BASED ON THE RECOLLECTION OF THE INSPECTORS AND DO NOT NECESSARILY REFLECT ACTUAL MEASUREMENTS.

SI
APERTURE
CARD

GRID NORTH
MAGNETIC NORTH
16°00'00"

0 100 200 400
APPROXIMATE SCALE IN FEET - SEE NOTE 3

EXPLANATION

P17	PERIMETER SIGN AND NUMBER
2 SE	SETTLEMENT PLATE AND NUMBER
BM	BOUNDARY MONUMENT
1	SITE MARKER AND NUMBER
	USGS TOWNSHIP AND SECTION LINE MARKER
15	PHOTOGRAPH LOCATION AND NUMBER
	PROPERTY BOUNDARY
	SECURITY FENCE
	DRAINAGE AND DIRECTION

TRANSECTS

- TOP OF EMBANKMENT
- SIDESLOPE
- TOE DRAIN
- MAINTENANCE AND INSPECTION ROAD
- PERIMETER DIVERSIOIN CHANNEL
- SITE PERIMETER

9301210321

1991 PRELICENSING INSPECTION
SOUTH CLIVE, UTAH DISPOSAL SITE
CONDUCTED JULY 29 AND 30, 1991

NO.	DATE	REVISIONS	DWN.	CKD.	SUB.	NO.	DATE	REVISIONS	DWN.	CKD.	SUB.

U.S. DEPARTMENT OF ENERGY
GRAND JUNCTION PROJECTS OFFICE, COLORADO

DRAWN — DATE 9/16/92
CHIEF INSPECTOR — DATE 9/16/92
REVIEWED — DATE 9/16/92

PLATE 1
SOUTH CLIVE, UTAH INSPECTION DRAWING
1991 PRELICENSING INSPECTION

CN Geotech, Inc.

PROJECT NO. ENG-111-0005-00-000
DWG. NO. E0093400
SHT. 1 OF 1