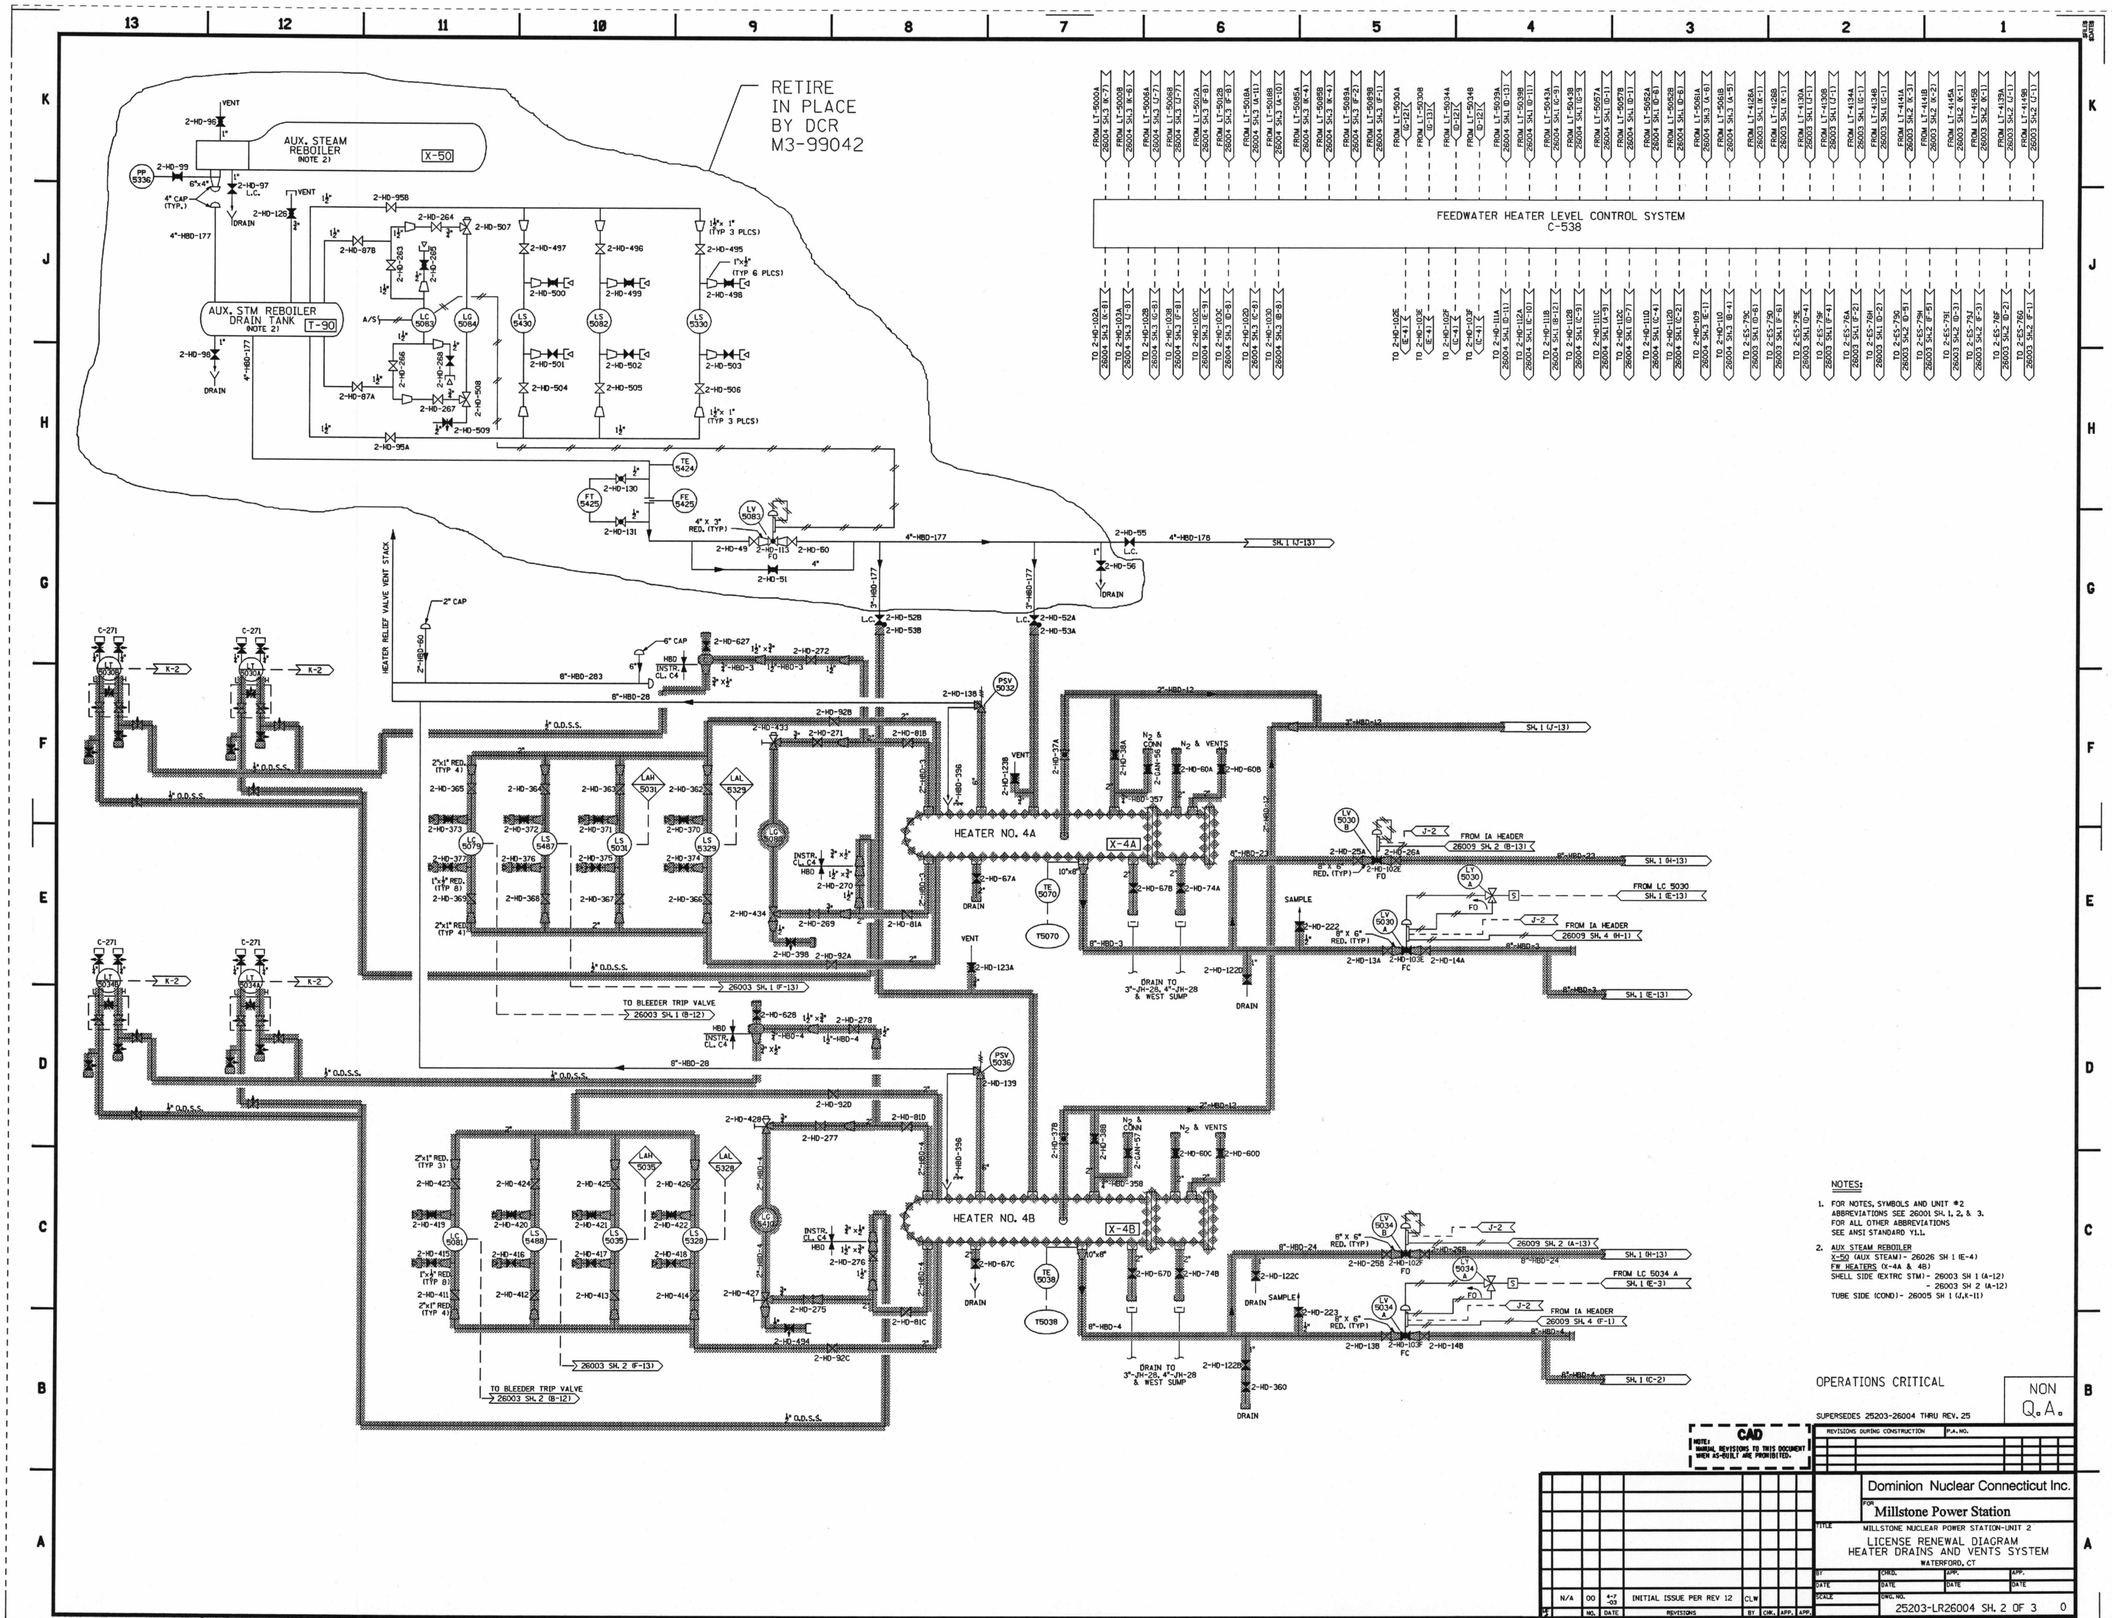

NOTES:

1. FOR NOTES, SYMBOLS AND UNIT #2 ABBREVIATIONS SEE 26001 SH. 1, 2, & 3. FOR ALL OTHER ABBREVIATIONS SEE ANSI STANDARD Y1.1.
2. AUX STEAM REBOILER
   X-50 (AUX STEAM) - 26026 SH 1 (E-4)
   FW HEATERS (X-4A & 4B)
   SHELL SIDE (EXTRC STM) - 26003 SH 1 (A-12)
   - 26003 SH 2 (A-12)
   TUBE SIDE (COND) - 26005 SH 1 (J,K-11)

OPERATIONS CRITICAL

NON Q.A.

SUPERSEDES 25203-26004 THRU REV. 25

CAD

NOTE: MARGINAL REVISIONS TO THIS DOCUMENT WHEN AS-BUILT ARE PROHIBITED.

REVISIONS DURING CONSTRUCTION	P.A. NO.

Dominion Nuclear Connecticut Inc.

FOR Millstone Power Station

TITLE MILLSTONE NUCLEAR POWER STATION-UNIT 2
LICENSE RENEWAL DIAGRAM
HEATER DRAINS AND VENTS SYSTEM
WATERFORD, CT

BY	CHKD.	APP.
DATE	DATE	DATE

SCALE DWG. NO. 25203-LR26004 SH. 2 OF 3 0

NO.	DATE	REVISIONS	BY	CHK.	APP.
N/A	00	4-7-03 INITIAL ISSUE PER REV 12	CLW		

ISSUED PER MASTER DRAWING

COMPONENTS SUBJECT TO AGING MANAGEMENT REVIEW

2328 FEEDWATER HEATER VENTS & DRAINS

2319A CONDENSATE

NOTE: SOME SHADED LINES MAY CONTAIN COMPONENTS FROM MORE THAN ONE SYSTEM.

D01

Submitted by SEKULIC on Monday December 22 2003 at 07:42:25 AM EST