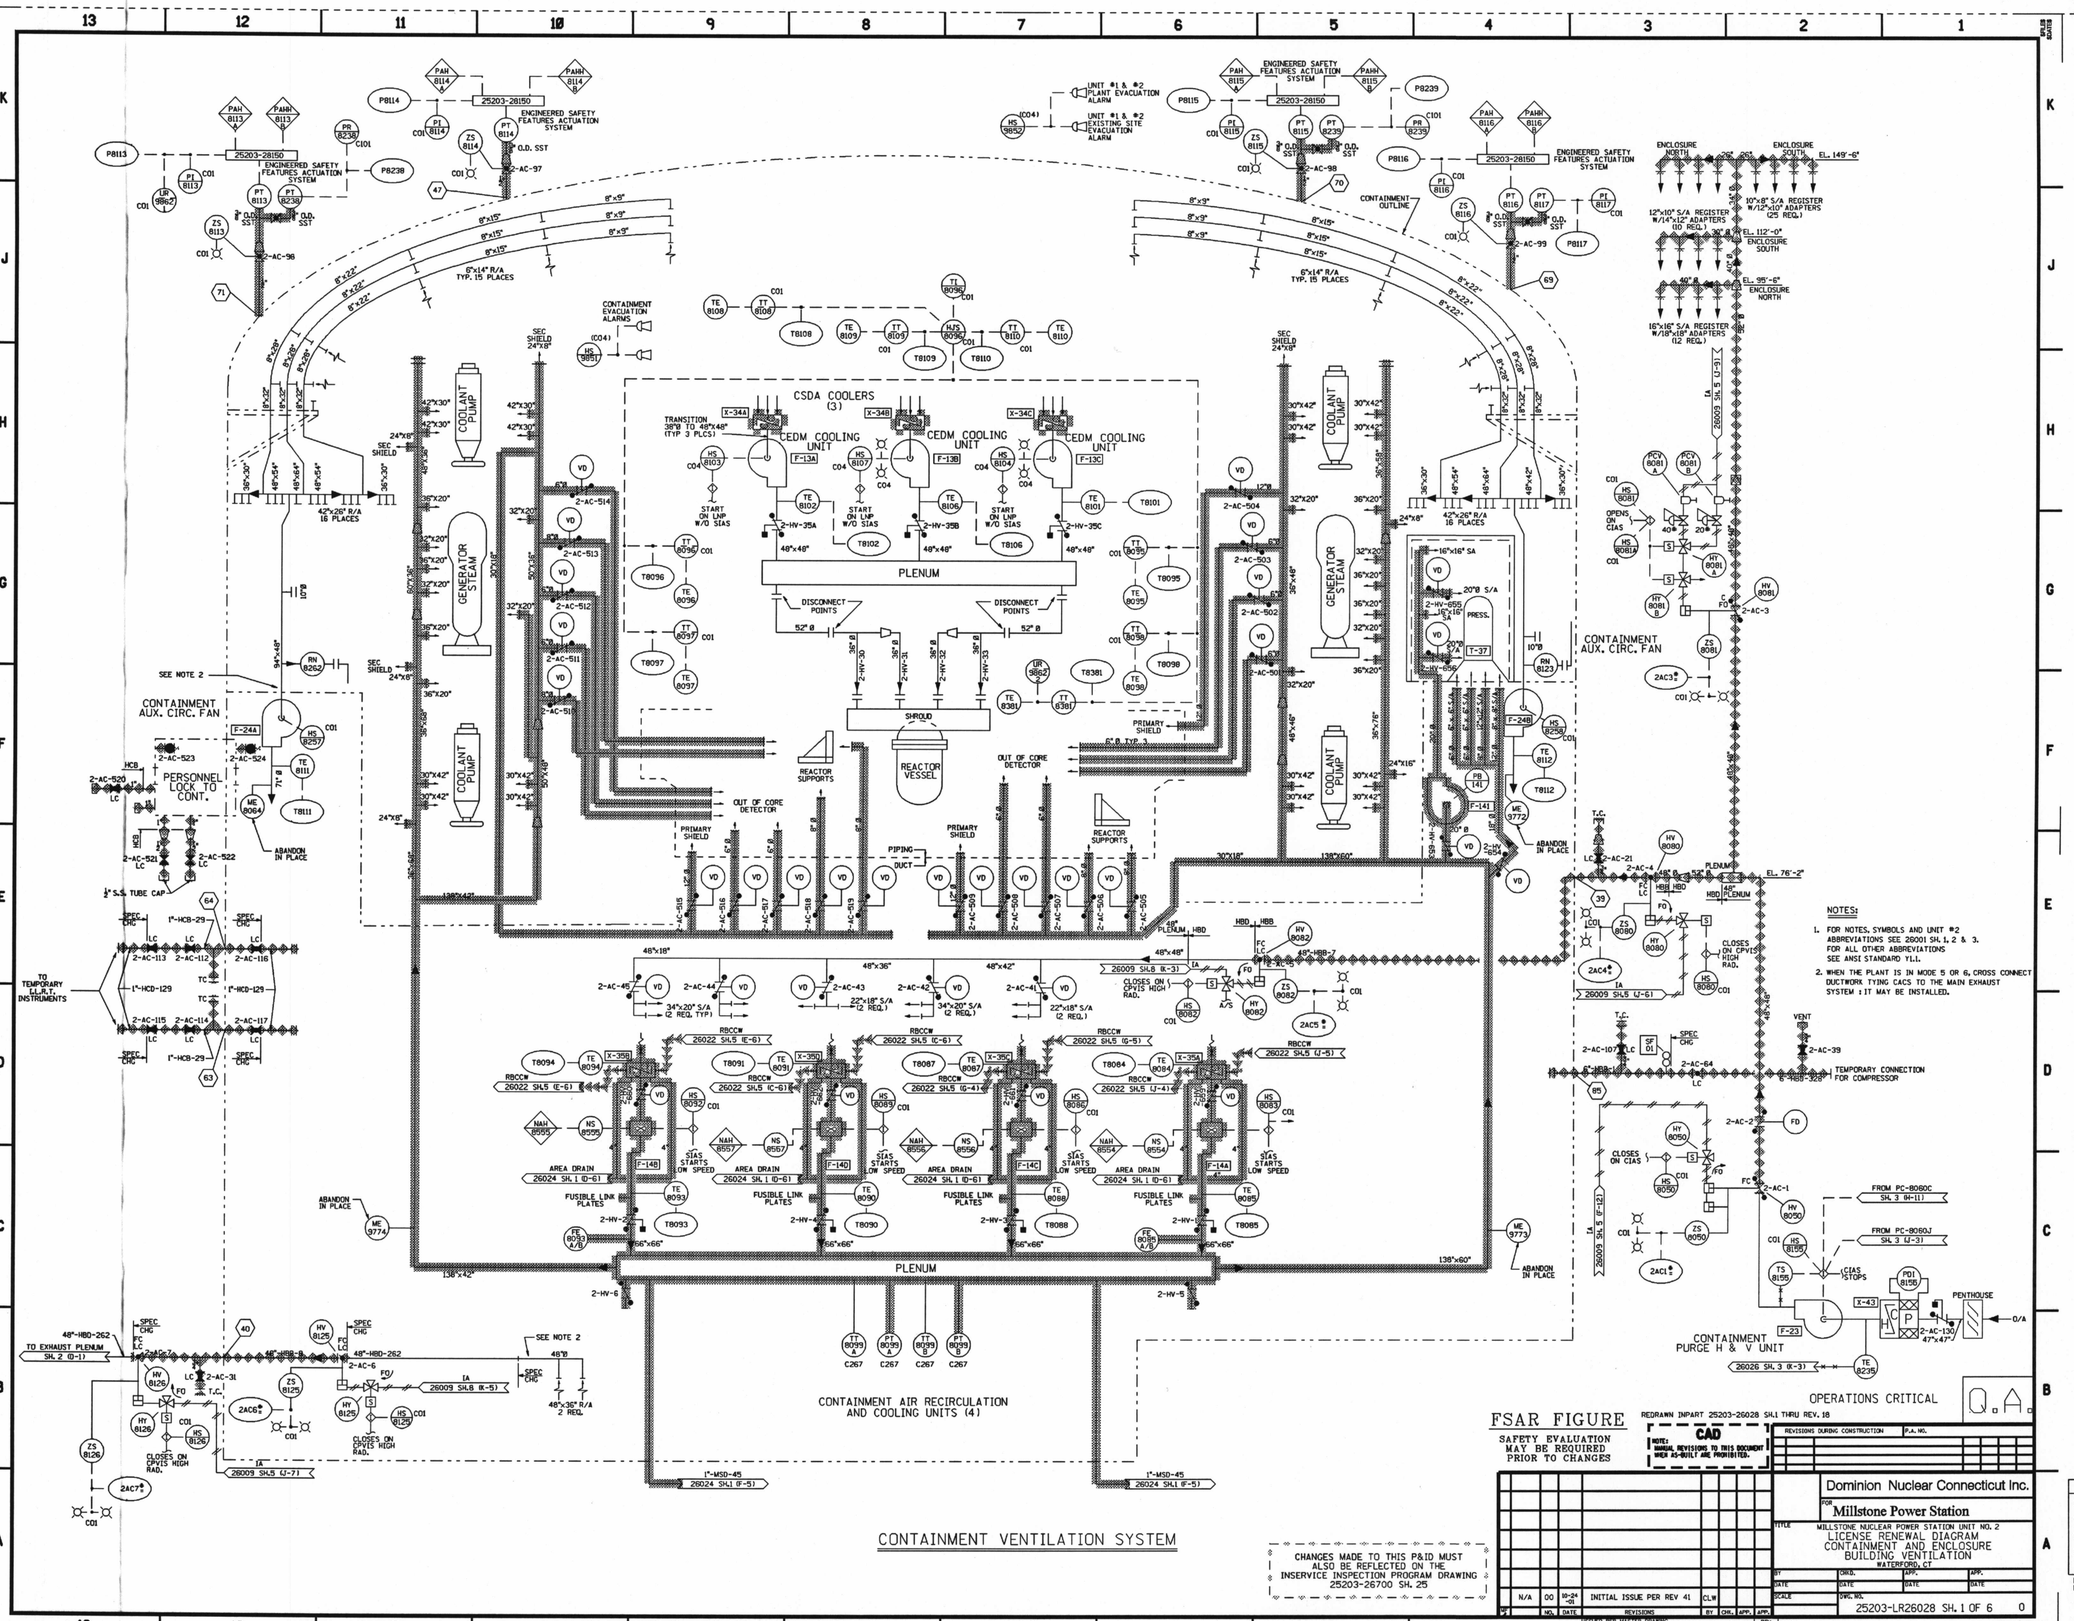

FSAR FIGURE

SAFETY EVALUATION MAY BE REQUIRED PRIOR TO CHANGES

REDRAWN INPART 25203-26028 SH.1 THRU REV. 18

CAD

NOTE: MANUAL REVISIONS TO THIS DOCUMENT MUST BE AS-BUILT ARE PROHIBITED.

CONTAINMENT VENTILATION SYSTEM

CHANGES MADE TO THIS P&ID MUST ALSO BE REFLECTED ON THE INSERVICE INSPECTION PROGRAM DRAWING 25203-26700 SH. 25

REVISIONS DURING CONSTRUCTION	P.A. NO.

REV	NO.	DATE	REVISIONS	BY	CHK.	APP.	APP.
N/A	00	10-24-01	INITIAL ISSUE PER REV 41	CLW			

ISSUED FOR MASTER DRAWING 25203-26028 SH. 1 OF 6 REV 41

Dominion Nuclear Connecticut Inc.

FOR Millstone Power Station

TITLE MILLSTONE NUCLEAR POWER STATION UNIT NO. 2
LICENSE RENEWAL DIAGRAM
CONTAINMENT AND ENCLOSURE
BUILDING VENTILATION
WATERFORD, CT

BY	DRD.	APP.	APP.
DATE	DATE	DATE	DATE
SCALE	DWG. NO. 25203-LR26028 SH. 1 OF 6		0

COMPONENTS SUBJECT TO AGING MANAGEMENT REVIEW	
2313A	CONTAINMENT AIR RECIRC & COOLING
2314B	CONTAINMENT & ENCLOSURE BLDG PURGE
2313D	CEDM COOLING
2330A	REACTOR BUILDING CLOSED COOLING WTR

NOTE: SOME SHADED LINES MAY CONTAIN COMPONENTS FROM MORE THAN ONE SYSTEM.

D070

Submitted by SEKULIC on Monday December 22 2003 at 07:36:27 AM EST