12179-EM-151C

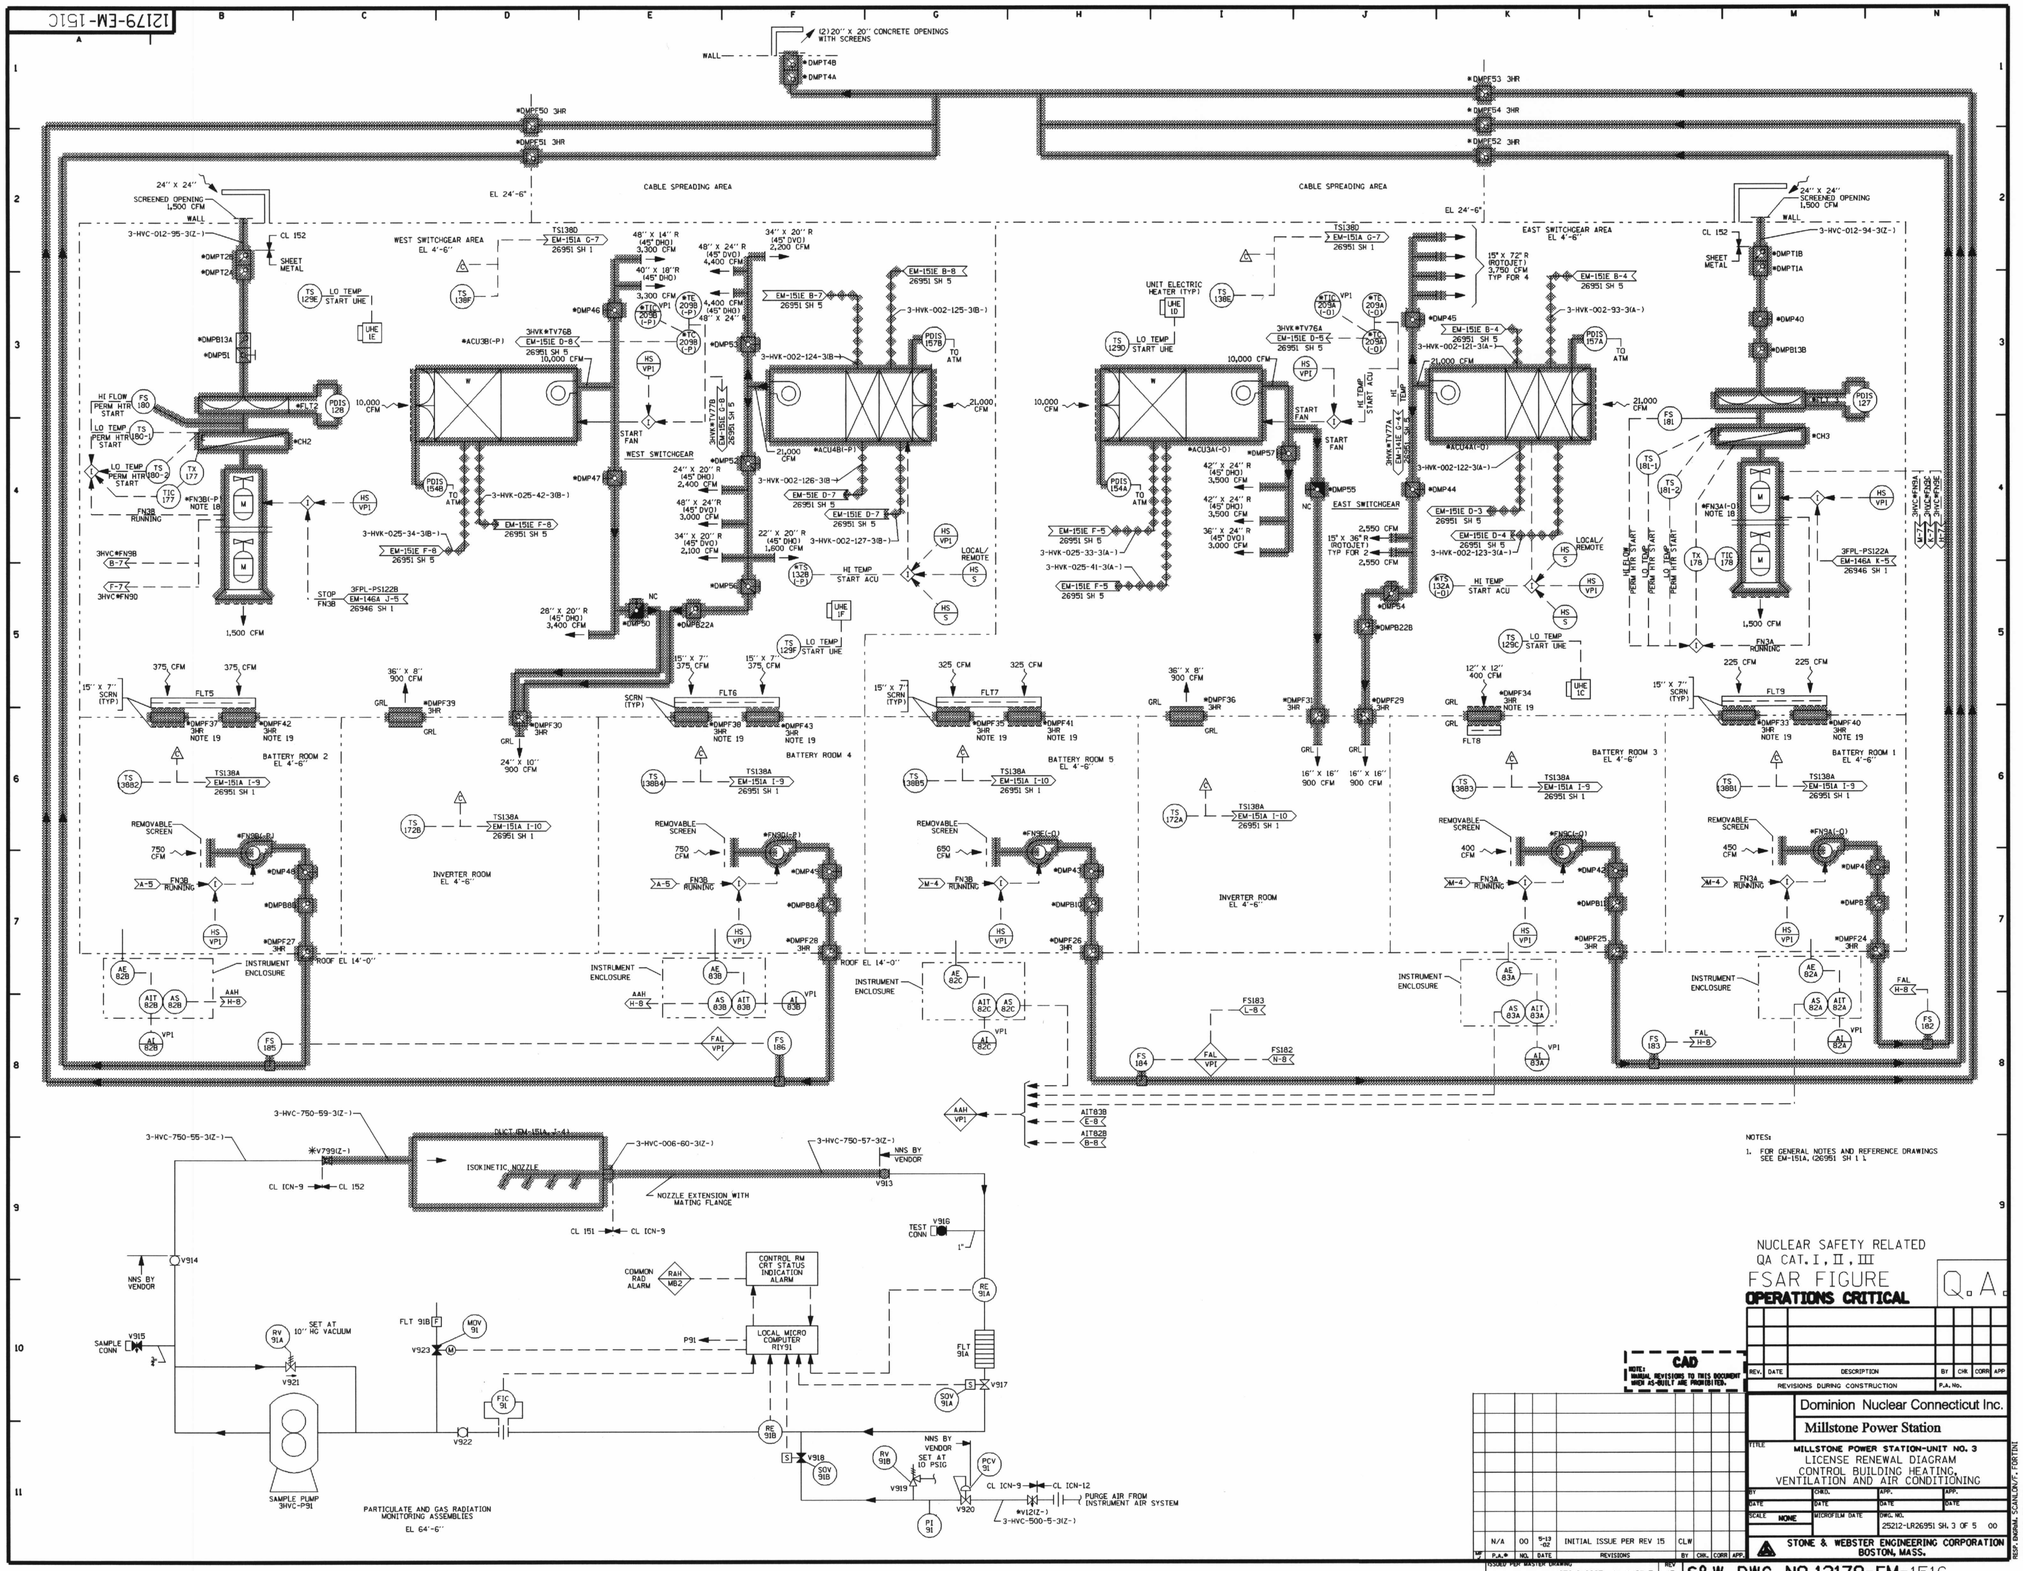

NUCLEAR SAFETY RELATED
QA CAT. I, II, III

FSAR FIGURE

OPERATIONS CRITICAL

Q.A.

REV.	DATE	DESCRIPTION	BY	CHK	CORR	APP
		REVISIONS DURING CONSTRUCTION		P.A. No.		

Dominion Nuclear Connecticut Inc.

Millstone Power Station

TITLE: MILLSTONE POWER STATION-UNIT NO. 3
LICENSE RENEWAL DIAGRAM
CONTROL BUILDING HEATING, VENTILATION AND AIR CONDITIONING

BY	CHKD.	APP.
DATE	DATE	DATE
SCALE NONE	MICROFILM DATE	DWG. NO. 25212-LR26951 SH. 3 OF 5 00

STONE & WEBSTER ENGINEERING CORPORATION
BOSTON, MASS.

CAD
NOTE: MANUAL REVISIONS TO THIS DOCUMENT MADE AS-BUILT ARE PROHIBITED.

P.A.#	NO.	DATE	REVISIONS	BY	CHK.	CORR.	APP.
N/A	00	5-13-02	INITIAL ISSUE PER REV 15	CLW			

ISSUED FOR MASTER DRAWING: 25212-26951 SH. 3 OF 5 | REV 15 | S&W DWG. NO. 12179-EM-151C

DRAWN BY: CHECKED BY:

REDY DRAWN: S.CAULOV.F. FORTINI
DESIGN DRAWER: BIDULSKIS

COMPONENTS SUBJECT TO AGING MANAGEMENT REVIEW
3304F CONTROL BUILDING HVAC VENTILATION SIDE
3304F CONTROL BUILDING HVAC CHILLED WATER SIDE

NOTE: SOME SHADED LINES MAY CONTAIN COMPONENTS FROM MORE THAN ONE SYSTEM.

D198

Submitted by AHLUWALIAC on Wednesday January 07 2004 at 11:00:42 AM EST