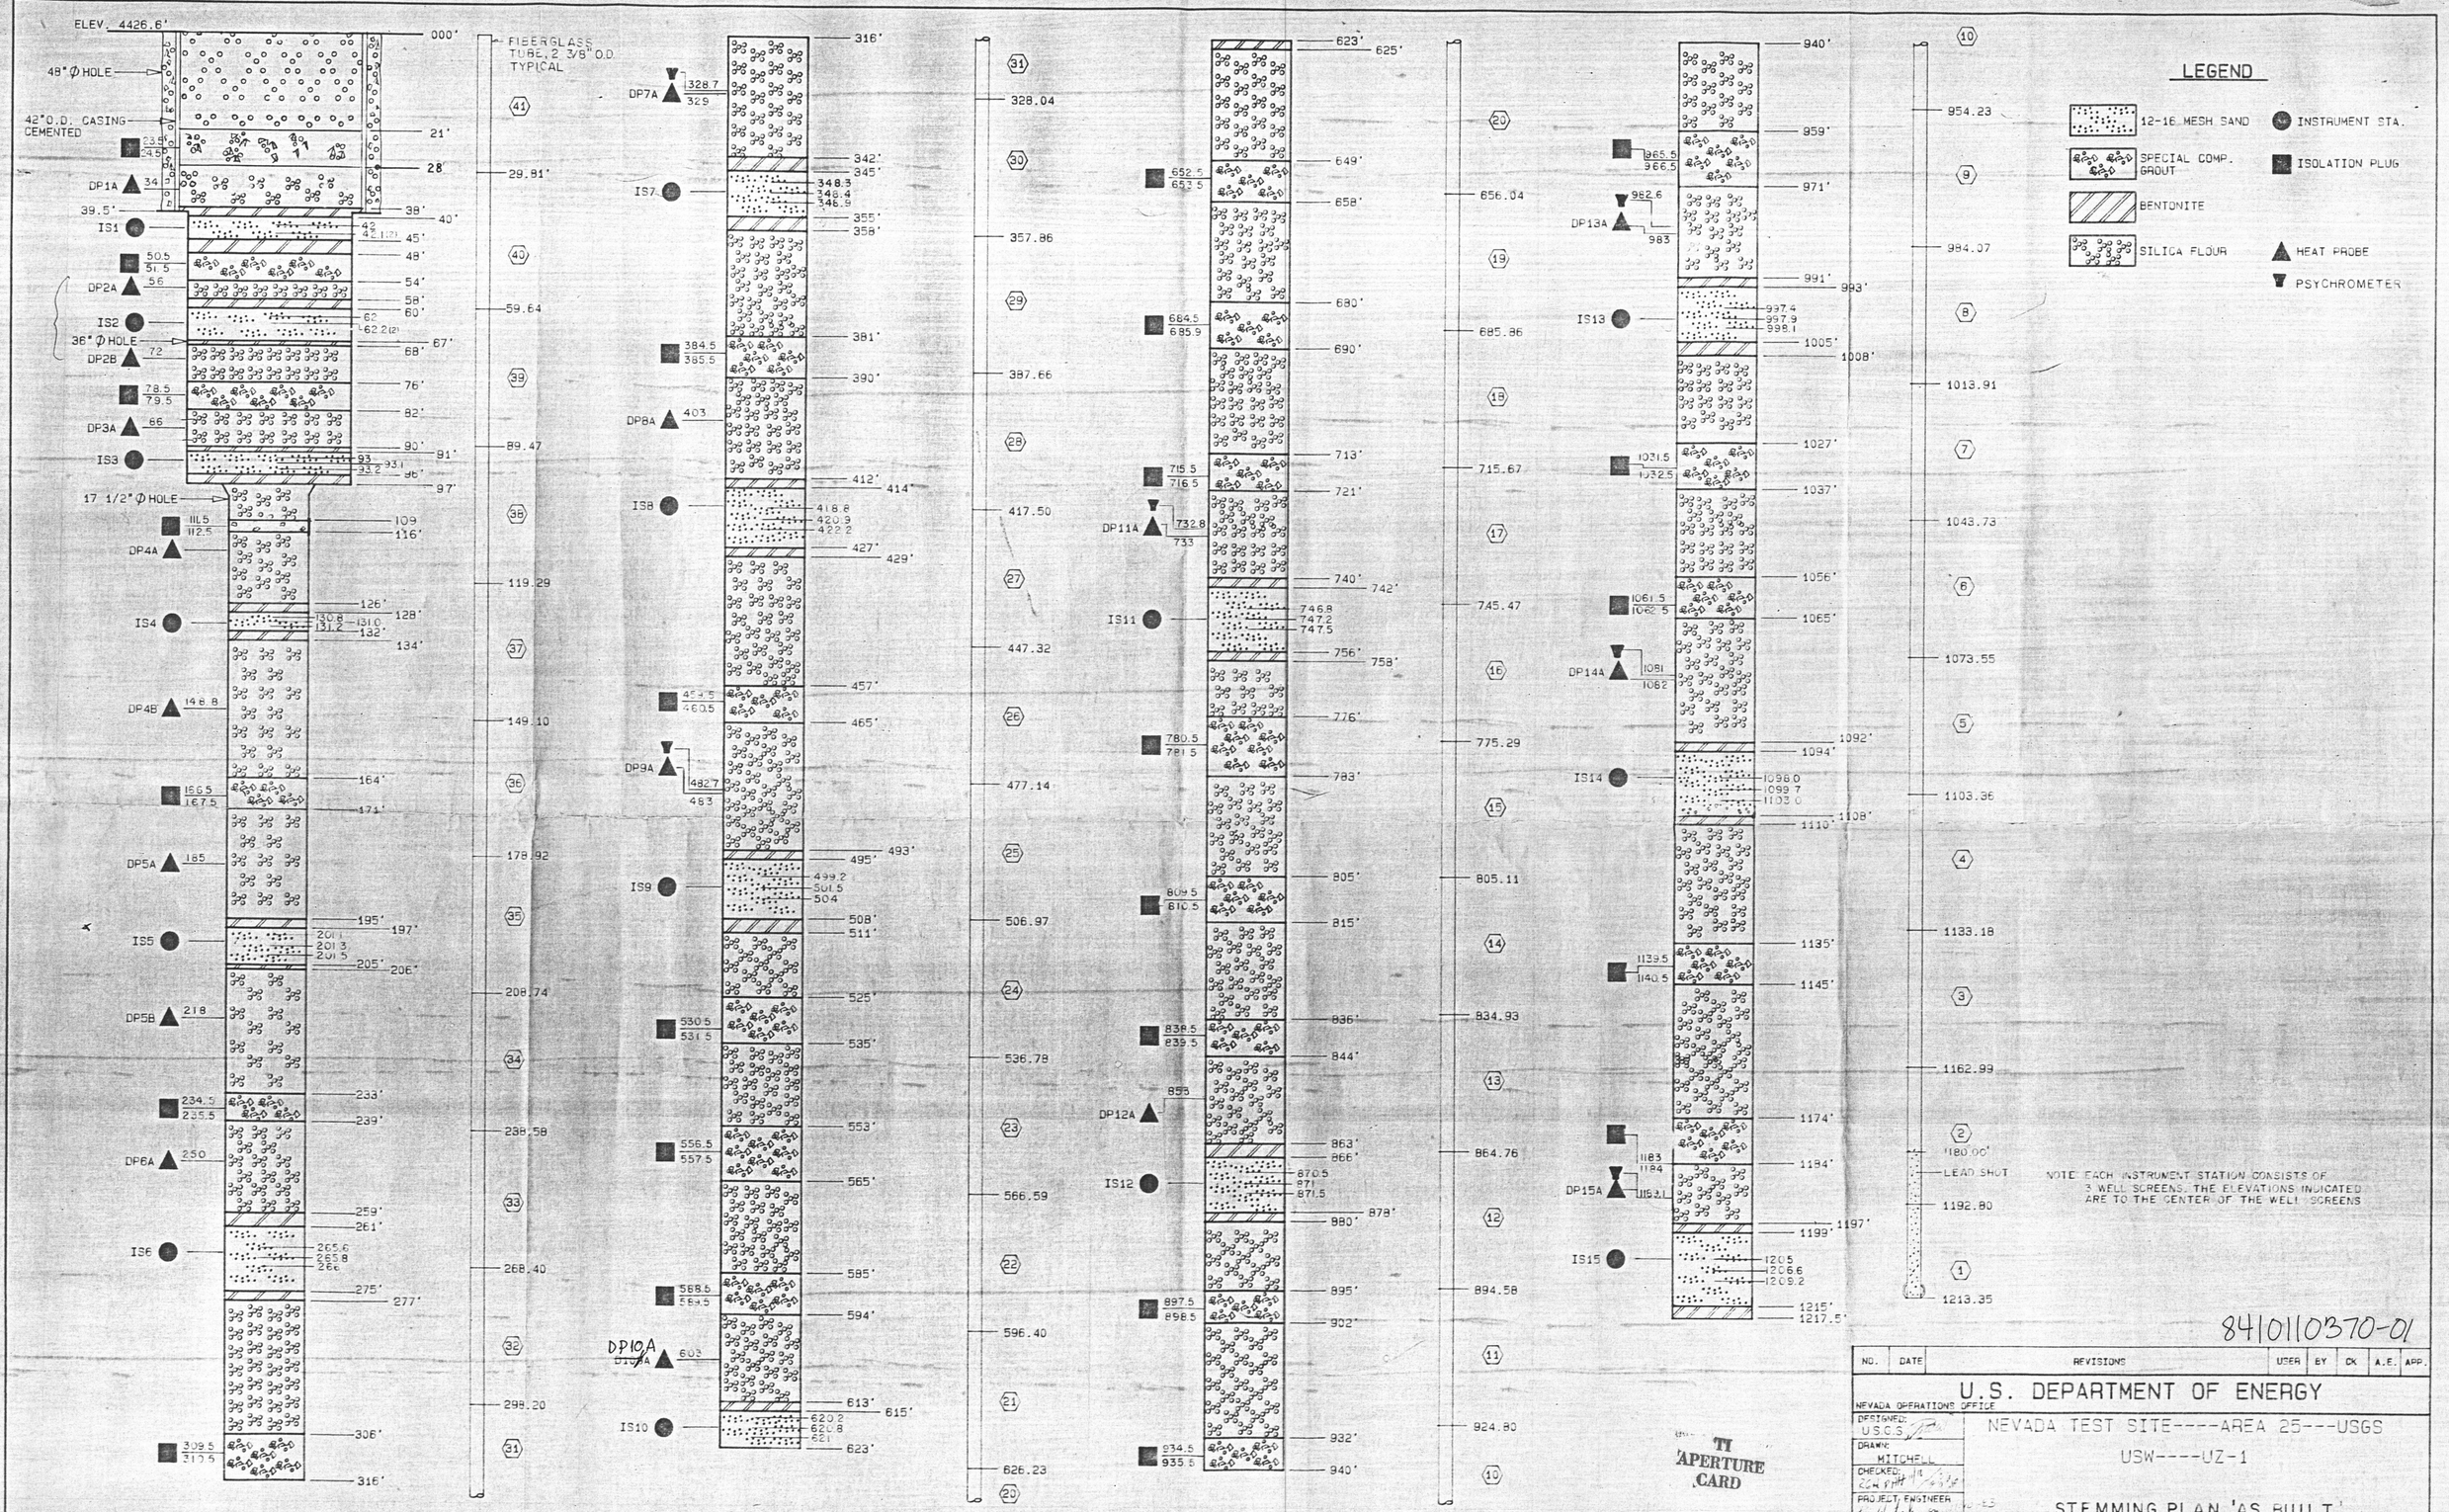

8410110370-01

NO.	DATE	REVISIONS	USER	BY	CK	A.E.	APP.

U.S. DEPARTMENT OF ENERGY

NEVADA OPERATIONS OFFICE

DESIGNED: U.S.G.S.

DRAWN: MITCHELL

CHECKED:

PROJECT ENGINEER

NEVADA TEST SITE----AREA 25---USGS

USW----UZ-1

STEMMING PLAN, 'AS BUILT'

SUBMITTED: HOLMES & NARVER INC.

AGENCY APPROVAL

DOE APPROVAL

DATE:

HOLMES & NARVER INC.
ENGINEERS-CONSTRUCTORS
ENERGY SUPPORT DIVISION
2753 SOUTH HIGHLAND DRIVE LAS VEGAS, NEVADA

I.D. NO. 50037A

P000581 10/27/83

DRAWING NUMBER JS-025-UZ1-C1

SHEET ___ OF ___

TI APERTURE CARD

D02

D02