# MORTGAGE REPORT

**TRAVERSE CITY PLANT**

PART OF THE NE 1/4 OF SEC. 4, T 26 N, R 11 W, BLAIR TWP. AND
PART OF SEC. 33, T 27 N, R 11 W, GARFIELD TWP.
GRAND TRAVERSE CO., MICHIGAN

Elmer's
CONSTRUCTION
ENGINEERING, INC.

SCALE: 1" = 200'

0' 200' 400' 600'

**LEGEND**

- LIGHT POLE
- POWER POLE
- ELECTRIC BOX
- WATER VALVE
- FENCE
- PROPERTY LINE
- IRON SET
- IRON FOUND
- MONUMENT SET
- MONUMENT FOUND
- (R) RECORD
- (M) MEASURED
- NAIL SET
- NAIL FOUND

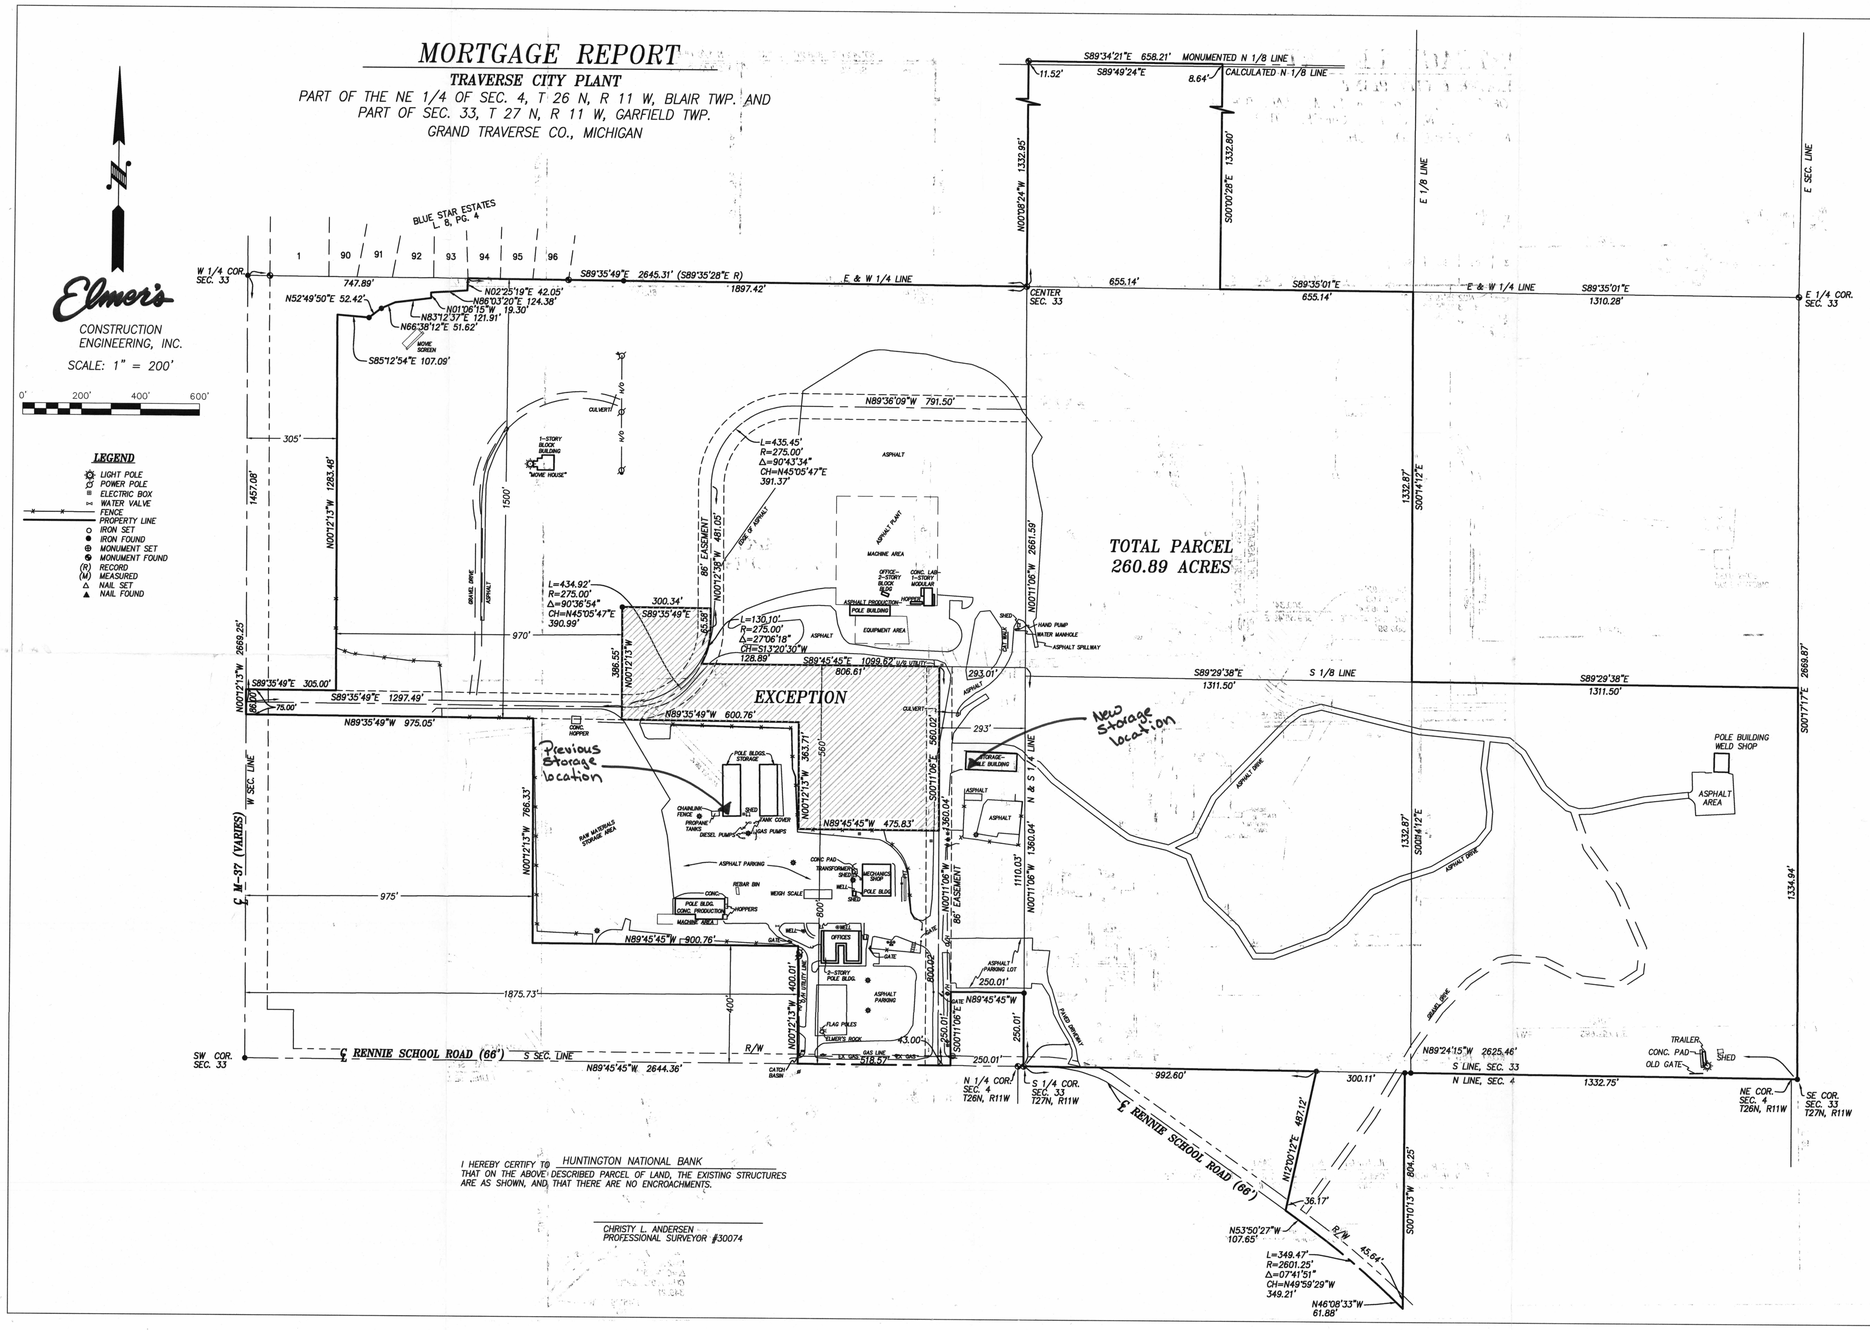


I HEREBY CERTIFY TO HUNTINGTON NATIONAL BANK
THAT ON THE ABOVE DESCRIBED PARCEL OF LAND, THE EXISTING STRUCTURES ARE AS SHOWN, AND THAT THERE ARE NO ENCROACHMENTS.

CHRISTY L. ANDERSEN
PROFESSIONAL SURVEYOR #30074

PREPARED FOR:
ELMER'S CRANE & DOZER
3600 RENNIE SCHOOL RD
TRAVERSE CITY, MI 49684


Elmer's
CONSTRUCTION ENGINEERING, INC.
ENGINEERING - SURVEYING - INSPECTION - TESTING
3600 RENNIE SCHOOL ROAD
P.O. BOX 6130
TRAVERSE CITY, MI 49696-6130
(231) 943-5454
FAX (231) 943-5599


- ☐ PRELIMINARY
- ☐ CONSTRUCTION
- ☐ AS-BUILT

FIELD CHK: ***
DSGN. BY: ***
DRN. BY: SAK/TAM
CKD. BY: CLA
DATE: 10-23-02
REV.

FILE: T:\...\Elmer's Mortgage.dwg

207546

SHEET 1 OF 2

K:\2007\0007\2074617\Elmer's Mortgage.dwg, 4/20/2004 3:53:28 PM, 1:200

D01