SCALING RULES

01-P-CTF-701

PLANT NORTH

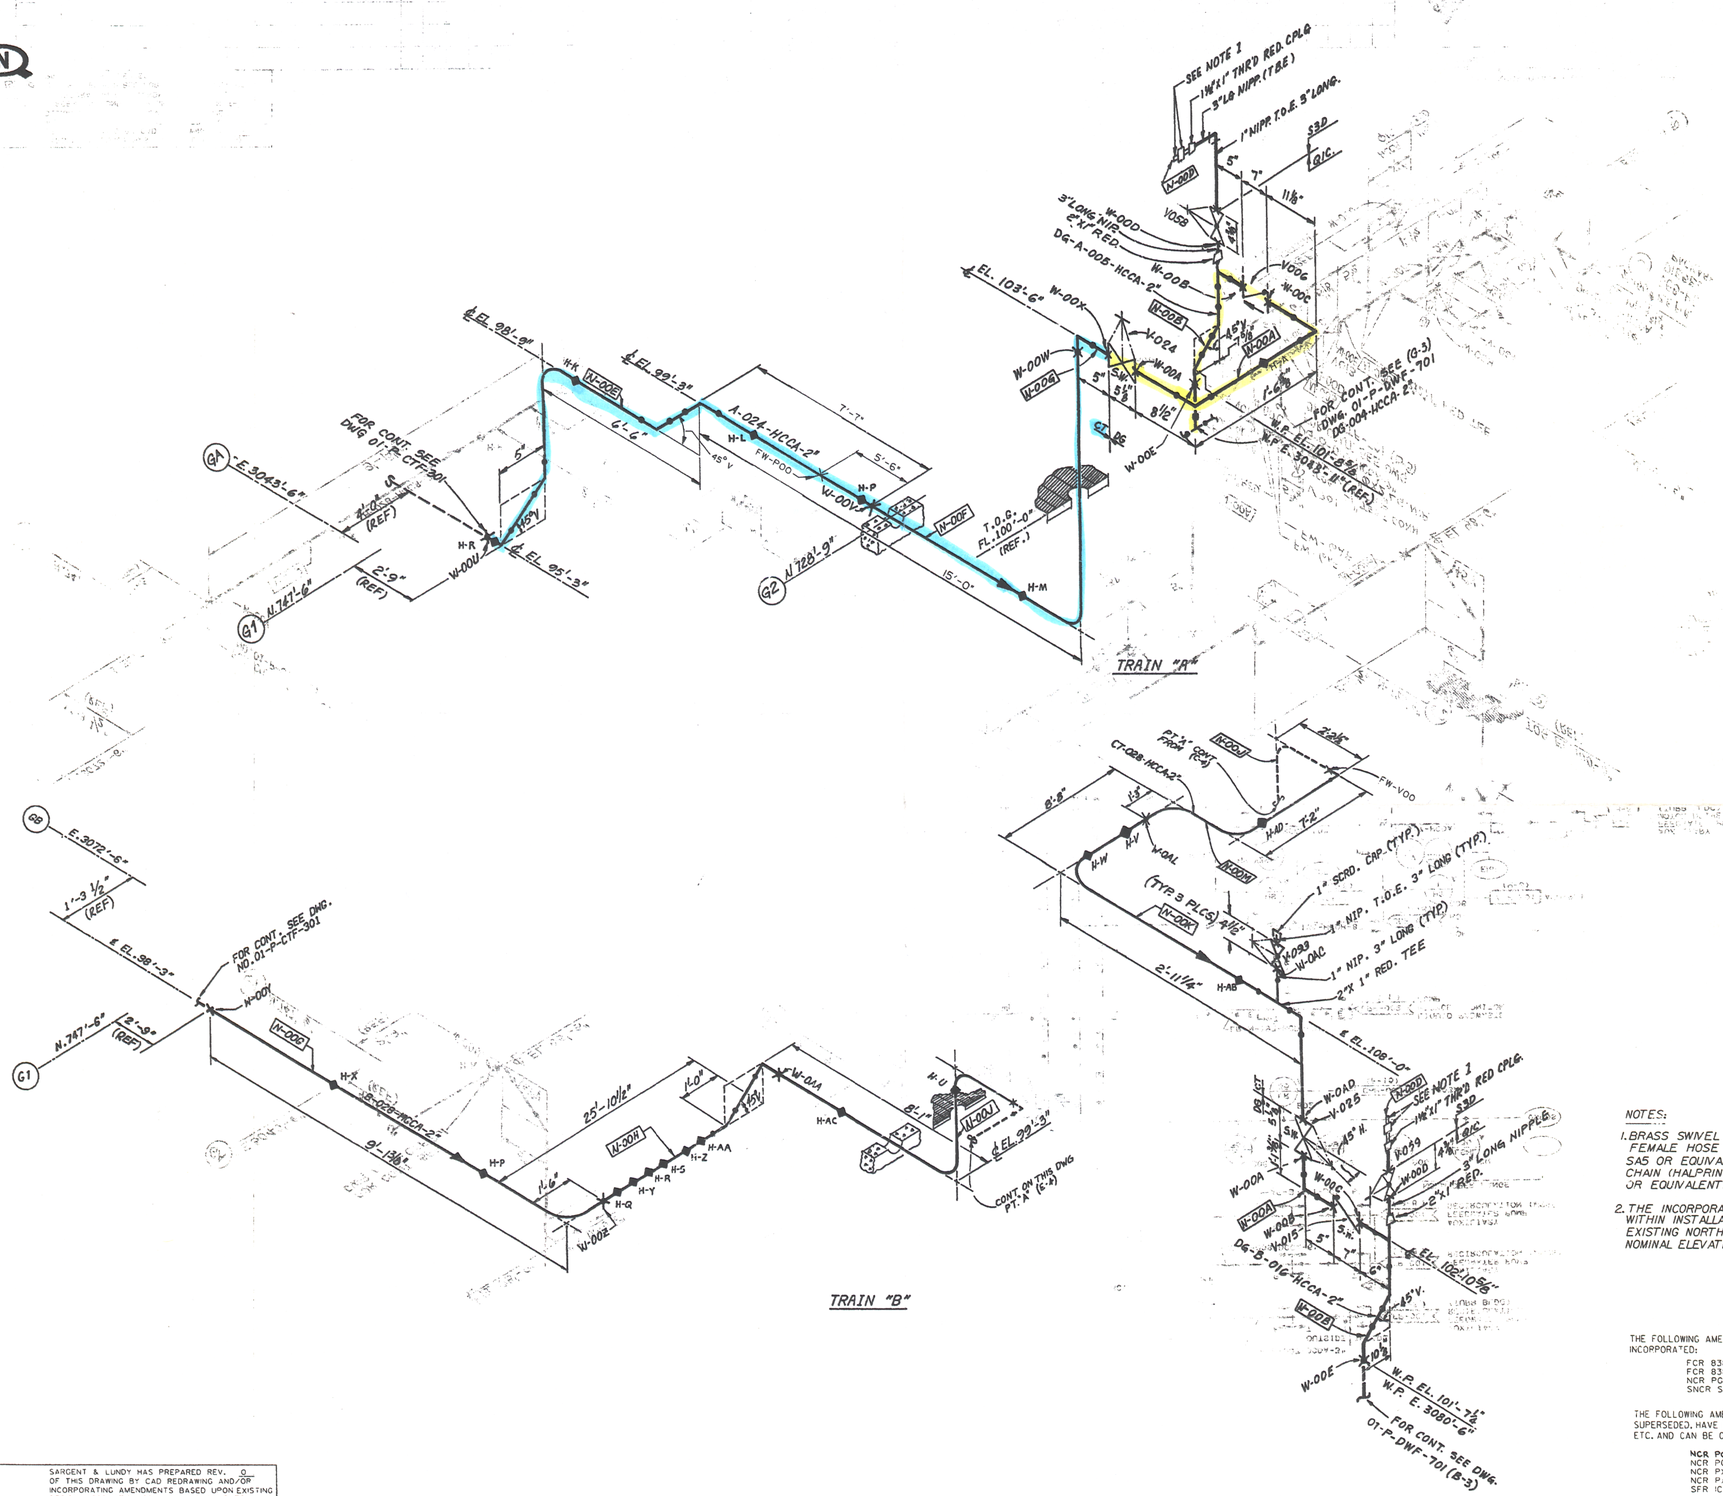

NOTES:

1. BRASS SWIVEL ADAPTER-1½" MALE N.P.T. X 1½" FEMALE HOSE THD (HALPRIN SUPPLY CO. CAT. NO. SA5 OR EQUIVALENT) AND A 1½" BRASS PLUG WITH CHAIN (HALPRIN SUPPLY CO. CAT. NO. B40 OR EQUIVALENT.)
2. THE INCORPORATION OF AS BUILT AMENDMENTS WITHIN INSTALLATION TOLERANCE MAY AFFECT EXISTING NORTH & EAST COORDINATES. NOMINAL ELEVATIONS & OVERALL DIMENSIONS.

THE FOLLOWING AMENDMENTS HAVE BEEN INCORPORATED:

FCR 8380-
FCR 83805-P
NCR PG-3751
SNCR SM-3835

THE FOLLOWING AMENDMENTS HAVE BEEN SUPERSEDED, HAVE NO PHYSICAL IMPACT OR ETC. AND CAN BE CLOSED OUT:

NCR PG-2687
NCR PG-3810
NCR PX-9457
NCR PX-9460
SFR ICT-001

SARGENT & LUNDY ENGINEERS

PREPARED: DATE: 11-10-90

REVIEWED: DATE: 11-14-90

SARGENT & LUNDY HAS PREPARED REV. 0 OF THIS DRAWING BY CAD REDRAWING AND/OR INCORPORATING AMENDMENTS BASED UPON EXISTING DESIGN INFORMATION FROM ANPP DOCUMENTS. SARGENT & LUNDY IS RESPONSIBLE FOR THE INCORPORATION OF AMENDMENTS & SHALL NOT BE RESPONSIBLE FOR THE ADEQUACY OR PROPRIETY OF THE DESIGN DEPICTED.

SEE MICROFILM FOR ACTUAL SIGNATURES

ALL DCNS INCORPORATED ON THIS DRAWING ARE THOSE ISSUED AGAINST THE CORRESPONDING 13 DRAWING.

TRAIN "A" & "B"

DWG.NO.	REFERENCE	NO.	DATE	REVISIONS	DR	CH'K	ENG	DS	QAE	RS
		0	9/6/91	UNITIZED FROM REV. 9 OF '13' DWG. AND INC. AMENDS.						

Arizona Nuclear Power Project

DIESEL GENERATOR BLDG. ISO CONDENSATE TRANSFER SYSTEM

SCALE	JOB NO.	DRAWING NO.	REV.
NONE		01-P-CTF-701	0

34X44 "E" SIZE

01PCTF701.DGN

D-04

This drawing has been produced by ANPP and is the property of the PARTICIPANTS in the ARIZONA NUCLEAR POWER PROJECT. Use of the drawing and the specific design depicted thereon for any purpose other than that related to the Arizona Nuclear Power Project is not authorized by the owners.

I certify that the image contained on this film was made in the normal and regular course of business, on the date stated below, and that it is an accurate reproduction of the document photographed.