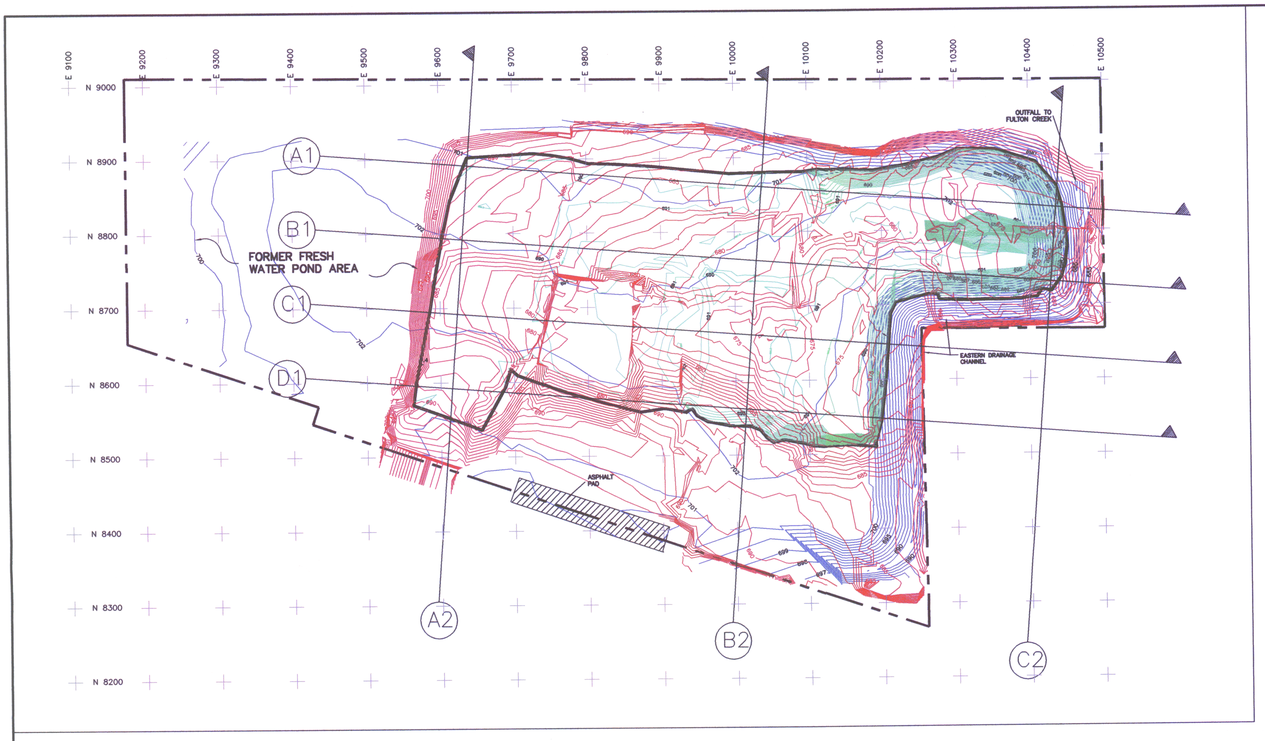

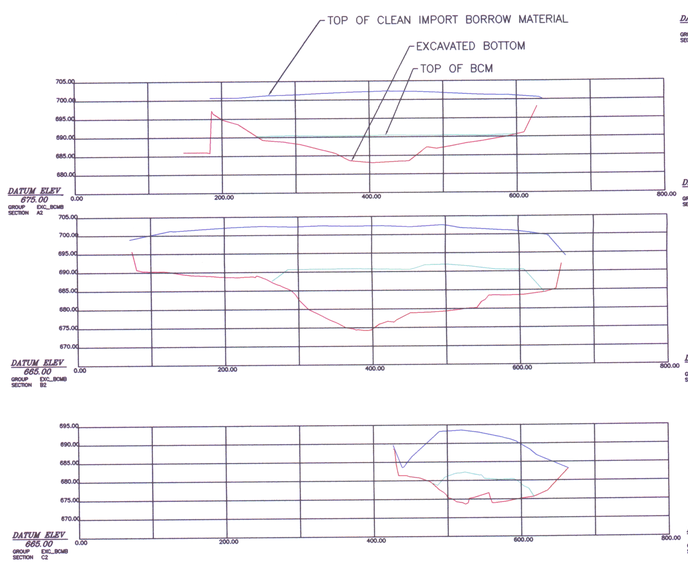

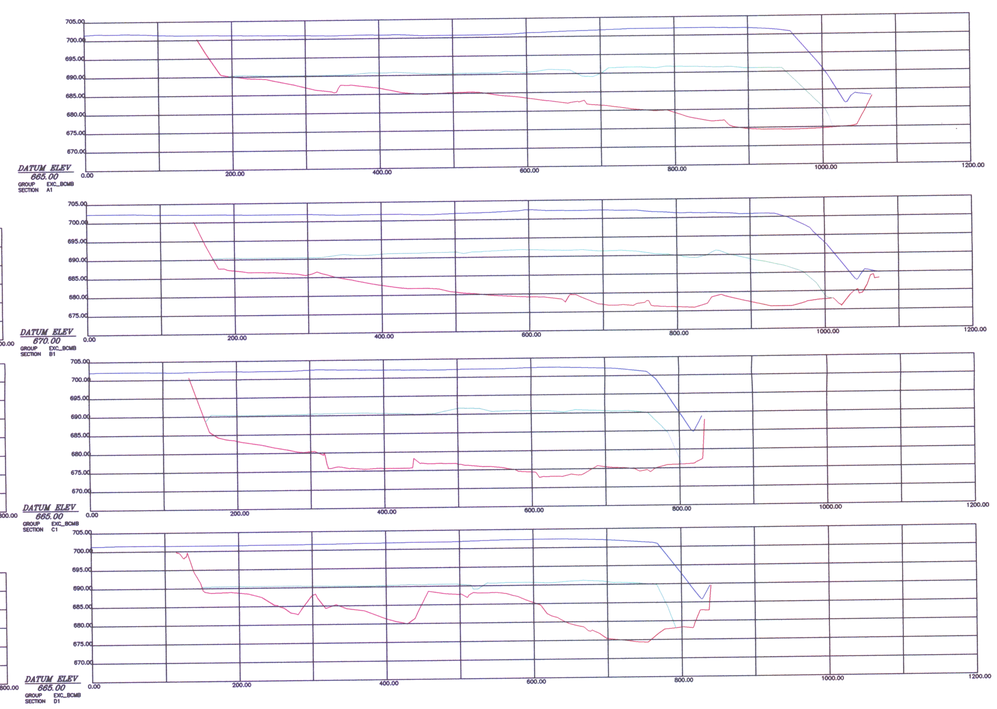

REFERENCE
RECON DRAWING "AS-BUILT OF EXCAVATED BOTTOM, BCM, FINAL GRADE, AND TOP CROSS SECTIONS", DATED 9-14-06.

N

LEGEND

- FINAL GRADE AS-BUILT
- EXCAVATION BOTTOM AS-BUILT
- TOP OF BCM AS-BUILT
- LATERAL EXTENT OF BCM PLACEMENT
- PROPERTY LINE
- (A1) POND PARCEL EXCAVATION/BACKFILL CROSS SECTION LOCATION

D-03

SCALE - FEET
0 100 200 300

REVISION	DATE	DESCRIPTION

FIGURE G-3
CROSS SECTIONS
POND PARCEL
THORIUM REMEDIATION PROJECT
TULSA, OKLAHOMA FACILITY

PREPARED FOR
KAISER ALUMINUM & CHEMICAL CORPORATION
TULSA, OKLAHOMA

APPROVED	RFD 9-14-06
CHECKED	RFD 9-14-06
DRAWN	DEB 9-13-06

DRAWING NUMBER
PA4072406

Penn E&R
Environmental & Remediation, Inc.