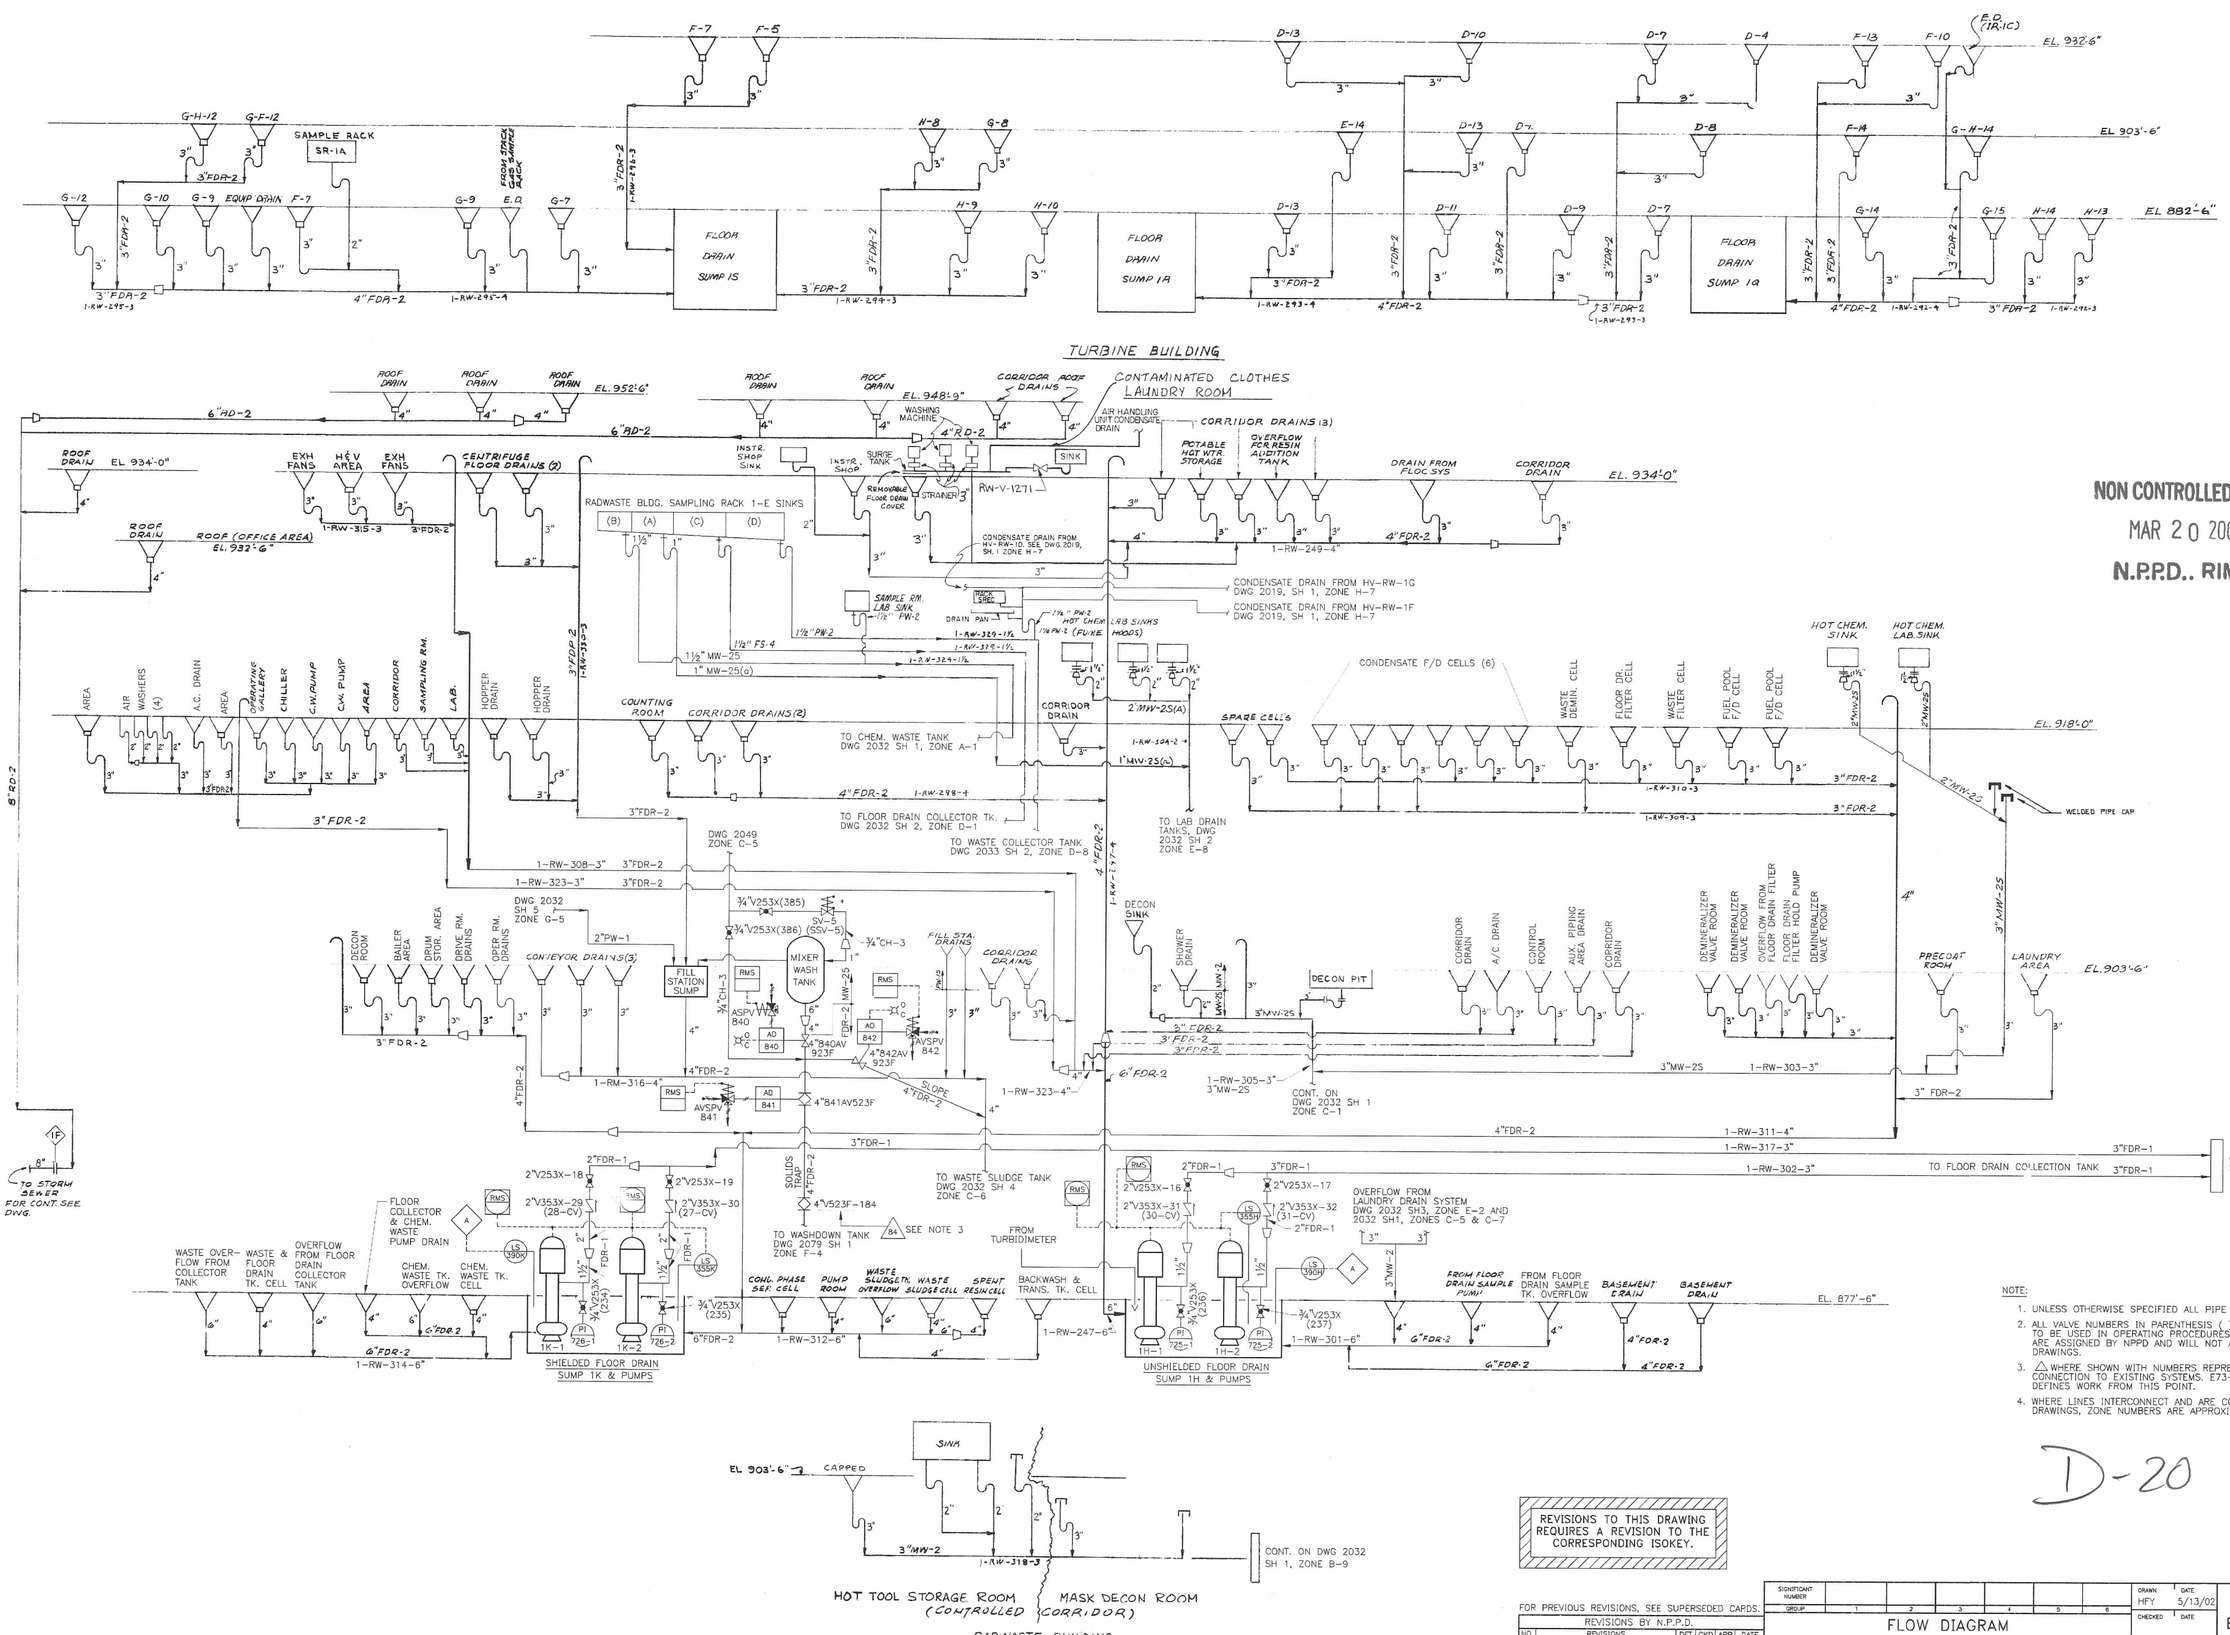

NON CONTROLLED PRINT
MAR 20 2007
N.P.P.D.. RIMS

NOTE:

1. UNLESS OTHERWISE SPECIFIED ALL PIPE SHALL BE FDR-2
2. ALL VALVE NUMBERS IN PARENTHESIS ( ) ARE NUMBERS TO BE USED IN OPERATING PROCEDURES. THESE NUMBERS ARE ASSIGNED BY NPPD AND WILL NOT APPEAR ON PIPING DRAWINGS.
3. △ WHERE SHOWN WITH NUMBERS REPRESENT POINTS OF CONNECTION TO EXISTING SYSTEMS. E73-58 SPECIFICATION DEFINES WORK FROM THIS POINT.
4. WHERE LINES INTERCONNECT AND ARE CONTINUED ON OTHER DRAWINGS, ZONE NUMBERS ARE APPROXIMATE ONLY.

D-20

REVISIONS TO THIS DRAWING REQUIRES A REVISION TO THE CORRESPONDING ISOKEY.

FOR PREVIOUS REVISIONS, SEE SUPERSEDED CARDS.

REVISIONS BY N.P.P.D.

NO.	REVISIONS	DFT	CKD	APP	DATE
N11	DCR 3-40217 DCN 02-0365	HFY	RGA	KG	6/19/02
N12	NOT. 10244841 (DCN 03-0689)	KG	KG	RGA	6/6/03
N13	DCN 05-0954	KG	RGA	DLR	9/9/05

SIGNIFICANT NUMBER | GROUP 1 2 3 4 5 6

DRAWN HFY DATE 5/13/02 | CHECKED DATE | APPROVED DATE SEE SUPERSEDED CARDS | FILMED

FLOW DIAGRAM
TURB. & RADWASTE BLDG. CONTAMINATED
FL. DRAIN & RADWASTE ROOF DRAIN SYS.
COOPER NUCLEAR STATION

BURNS & ROE

2017

REVISION N13

CARD TITLE: C0017917

AS BUILT
454003605
SCAN/CADD DWG
DO NOT REVISE MANUALLY