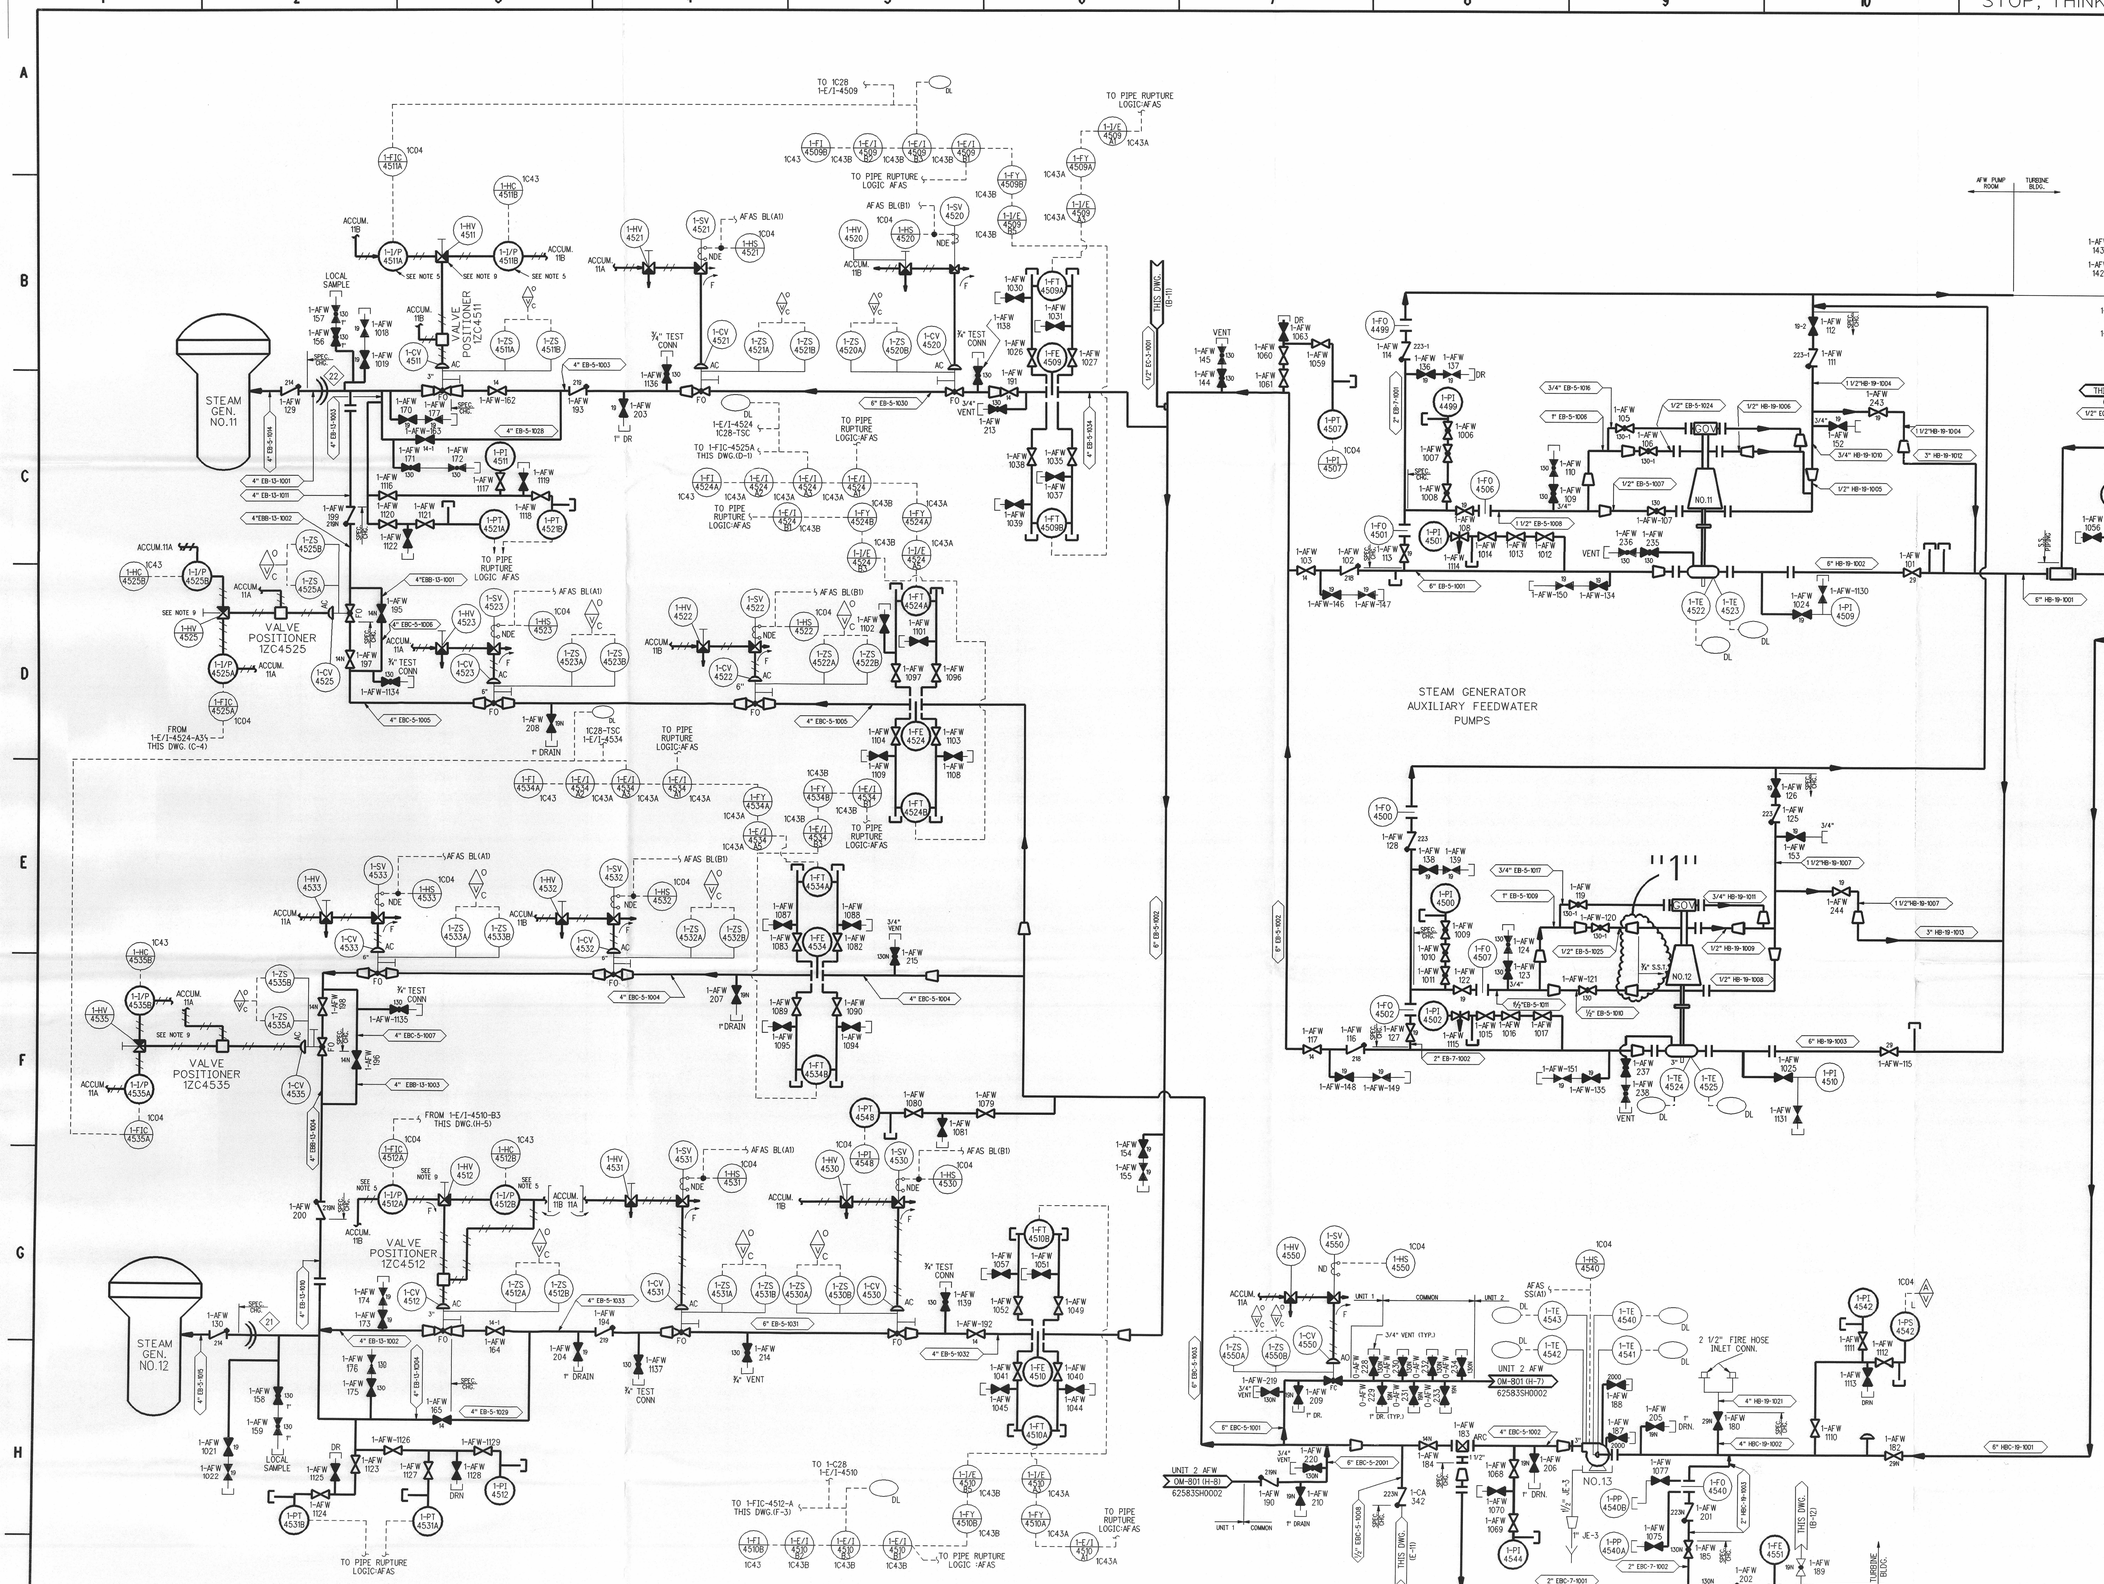

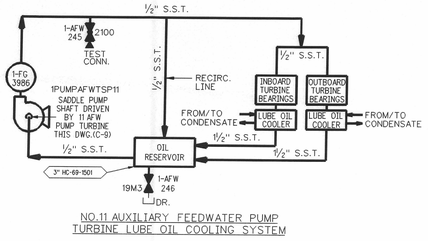

NO.11 AUXILIARY FEEDWATER PUMP TURBINE LUBE OIL COOLING SYSTEM

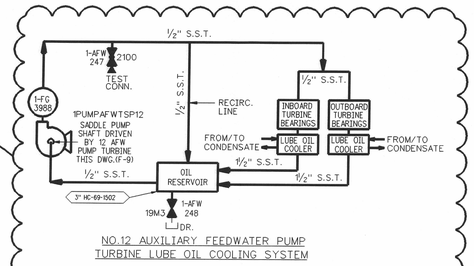

NO.12 AUXILIARY FEEDWATER PUMP TURBINE LUBE OIL COOLING SYSTEM

GENERAL NOTES

1. FOR P.&I.D. LEGEND SEE DRAWING 6750-M-80, (B.G.&E. NO. 60-263-E)
2. FOR INSTRUMENT DATA SHEETS SEE DRAWING 6750-M-500, (B.G.&E. NO. 92-401-A THRU 92-422-B)
3. FOR EQUIPMENT LIST SEE 6750-M-603,(B.G.&E. NO. 92-722-A).
4. EQUIPMENT NUMBERS FOR UNIT NO.1 ARE PREFIXED BY THE NUMBER 1 (EXAMPLE NO. 11, 12, 13, ETC.) EQUIPMENT NUMBERS FOR UNIT NO.2 ARE PREFIXED BY THE NUMBER 2 (EXAMPLE NO. 21, 22, 23, ETC.). EQUIPMENT COMMON TO BOTH UNITS IS NUMBERED AS FOR UNIT NO.1.
5. ELECTRO-PNEUMATIC TRANSDUCERS 1-I/P 4511 AND 4512 ARE LOCATED IN ENCLOSURES FOR ENVIRONMENTAL PROTECTION PURPOSES.
6. FOR DEFINITIONS OF LINE DESIGNATIONS SEE PIPING CLASS AND SUMMARY SHEETS M-600, M-601, M-600B.
7. FOR INSTRUMENT DATA SHEETS SEE M-500.
8. FOR AFW ALARMS REFER TO ELECTRICAL ANNUNCIATOR DRAWINGS.
9. TRANSFER HAND VALVES, 1-HV-4511, 4512, 4525 & 4535 ARE LOCATED IN ENCLOSURES FOR ENVIRONMENTAL PROTECTION PURPOSES.
10. THE Q-LIST INFORMATION PROVIDED ON THIS DRAWING IDENTIFIES THE SAFETY RELATED PRESSURE BOUNDARIES (SR-PB). EQUIPMENT WITHIN THE BOUNDARIES IS ALSO CLASSIFIED SR-PB, AS A MINIMUM. THE NUCLEIS MASTER EQUIPMENT LIST MUST BE USED FOR IDENTIFYING SPECIFIC OR ADDITIONAL SAFETY CLASSIFICATION INFORMATION, INCLUDING COMPONENT CLASSIFICATIONS AND ASSOCIATED REQUIREMENTS.
11. PIPING WHICH CONTINUES BEYOND THE SAFETY RELATED (SR-PB) BOUNDARY INDICATED ON THIS DRAWING, IS CLASSIFIED SR-PB UP TO AND INCLUDING THE FIRST SEISMIC ANCHOR.
12. ——— DENOTES SAFETY RELATED PRESSURE BOUNDARIES.
    ——— DENOTES NON-SAFETY RELATED PRESSURE BOUNDARIES.

THIS DRAWING WAS CREATED FROM OPERATIONS DRAWING 60583 (OM-800), REV. 59, DATED 10/7/04.
SEE DRAWING 60583SH0001 FOR AUXILIARY FEEDWATER SYSTEM (STEAM)

REV	DATE	DESCRIPTION	DWN	DSGN	DE	IR	APPROVED
0	2/18/05	ADMIN CHANGE ONLY	WHR WB	—	—	—	RKI
1	5/9/06	AS BUILT DCN 60583SH0002-2001SH0001 & 60583-2004SH0002 REV. C ES200100565-002	WHR RKI	—	—	—	RKI

AUXILIARY FEEDWATER SYSTEM (CONDENSATE)

CALVERT CLIFFS NUCLEAR POWER PLANT
ENGINEERING SERVICES DEPARTMENT
CALVERT CLIFFS UNIT 1

SIZE: E | CAT. C
SCALE: NONE | VENDOR DWG. NO. OM-800SH0002 | REV. 1
DWG. NO. 60583SH0002

D-02