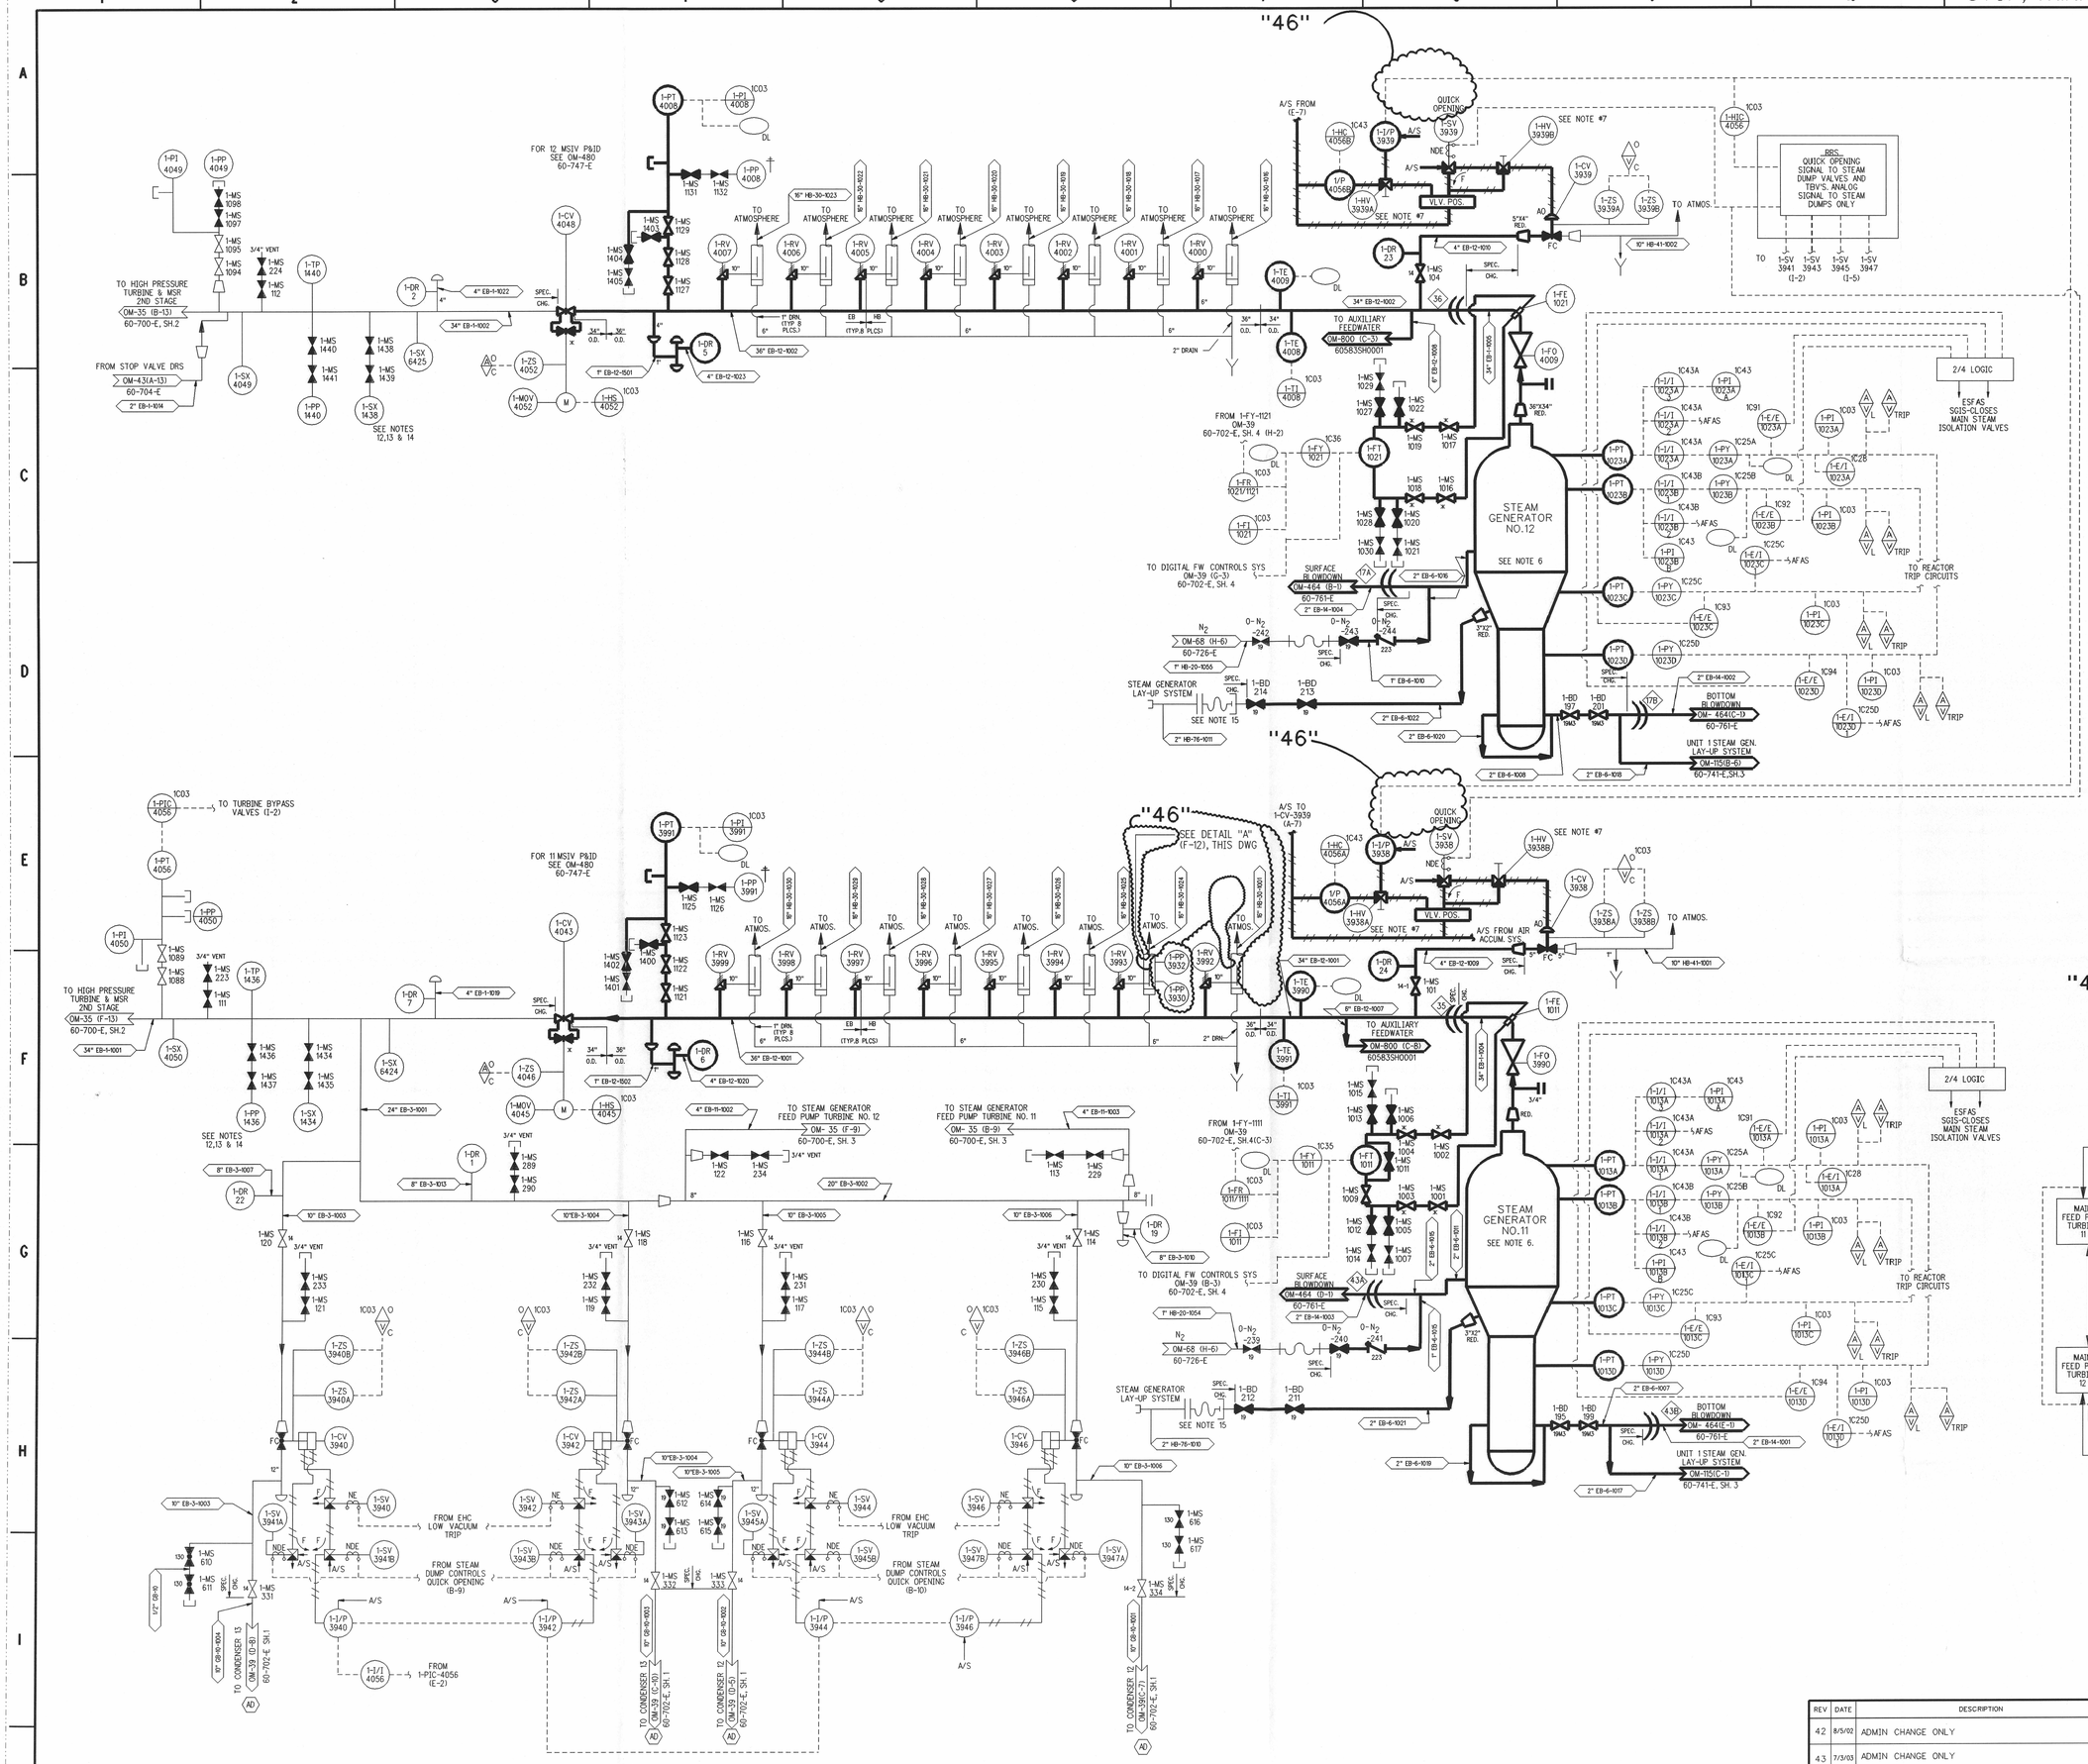

GENERAL NOTES:

1. FOR P&ID LEGEND SEE DRAWING 6750-M-80. (BG&E NO.60-263-E)
2. FOR EQUIPMENT LIST SEE 6750-M-603. (BG&E NO.92-772-A)
3. FOR INSTRUMENT DATA SHEETS SEE 6750-M-500. (BG&E NO.92-401-A THRU 92-422-B)
4. EQUIPMENT NUMBERS FOR UNIT NO.1 ARE PREFIXED BY THE NUMBER 1 (EXAMPLE: NO.11, 12, 13, ETC.). EQUIPMENT NUMBERS FOR UNIT NO.2 ARE PREFIXED BY THE NUMBER 2 (EXAMPLE: NO.21, 22, 23, ETC.). EQUIPMENT COMMON TO BOTH UNITS IS NUMBERED AS FOR UNIT NO.1.
5. REFER TO OM-114 SH.1 & 2 (60-740-E) FOR DRAIN PIPING.
6. REF. OM-39 60-702-E SH.4 FOR THE PIPING DETAIL OF THE S/G INSTRUMENTS.
7. TRANSFER HANDVALVES 1-HV-3938A & B AND 1-HV-3939A & B ARE LOCATED IN TAMPERPROOF ENCLOSURES WHICH ARE PROVIDED WITH A SECURITY ALARM TO PROVIDE AN ANNUNCIATION ALARM IN THE MAIN CONTROL ROOM.
8. FOR DEFINITION OF LINE DESIGNATIONS SEE PIPING CLASS AND SUMMARY SHTS. 6750-M-600, 6750-M-601 (BG&E NO.92-767-A THRU 92-769-A).
9. THE Q-LIST INFORMATION PROVIDED ON THIS DRAWING IDENTIFIES THE SAFETY RELATED PRESSURE BOUNDARIES (SR-PB). EQUIPMENT WITHIN THE BOUNDARIES IS ALSO CLASSIFIED SR-PB, AS A MINIMUM. THE NUCLEIS MASTER EQUIPMENT LIST MUST BE USED FOR IDENTIFYING SPECIFIC OR ADDITIONAL SAFETY CLASSIFICATION INFORMATION, INCLUDING COMPONENT CLASSIFICATIONS AND ASSOCIATED REQUIREMENTS.
10. PIPING WHICH CONTINUES BEYOND THE SAFETY RELATED (SR-PB) BOUNDARY INDICATED ON THIS DRAWING, IS CLASSIFIED SR-PB UP TO AND INCLUDING THE FIRST SEISMIC ANCHOR.
11. ▬▬▬ DENOTES SAFETY RELATED PRESSURE BOUNDARIES.
    ——— DENOTES NON-SAFETY RELATED PRESSURE BOUNDARIES.
12. STEAM SAMPLE PROBE MAY BE REMOVED AND A BLIND FLANGE INSTALLED.
13. FOR DETAILS SEE DRAWING 12629A-0020
14. INSULATION ON 34" LINE IS 7" THICK FROM 68" DOWNSTREAM OF 1-TP-1436 AND 1-TP-1440 TO 68" UPSTREAM OF 1-SX-1434 AND 1-SX-1438.
15. FLEX HOSE REMOVED DURING NORMAL OPERATIONS.

✳ HERMETICALLY SEALED VALVE REDUCED STEM TRAVEL

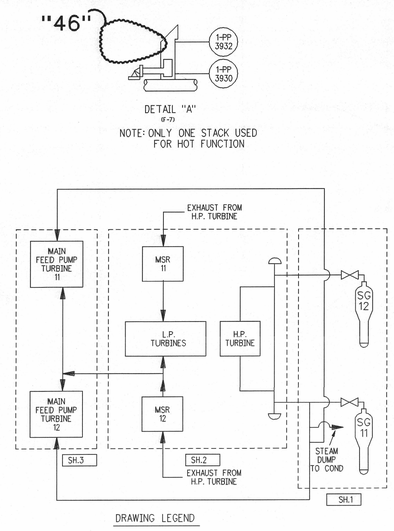

DRAWING LEGEND

THIS DRAWING CREATED FROM OPERATIONS DRAWING 60-700-E SH.1 (OM-35), REV. 31, DATED 05-17-1994 & P&ID 60-225-E SH.1 (M-35), REV. 51, DATED 9-15-1992.

REV	DATE	DESCRIPTION	DWN	DSGN	DE	IR	APPROVED
42	8/5/02	ADMIN CHANGE ONLY	WHR RKL	—	—	—	RKL
43	7/3/03	ADMIN CHANGE ONLY	EAM RKL	—	—	—	RKL
44	2/23/04	AS BUILT DCN 60700SH0001-2002SH0001 ES199900681-000	EAM RKL	—	—	—	RKL
45	2/22/05	EDITORIAL CHANGE ONLY	WHR RKL	—	—	—	RKL
46	1/17/06	AS BUILT DCN 60700SH0001-2007SH0001 ES200500648-000 & 60700SH0001-2006SH0001 ES199900691-000	WHR RKL	—	—	—	RKL

MAIN STEAM AND REHEAT

CALVERT CLIFFS NUCLEAR POWER PLANT
ENGINEERING SERVICES DEPARTMENT

CALVERT CLIFFS UNIT 1 | SIZE E | CAT. C
SCALE: NONE | VENDOR DWG. NO. OM-035SH0001 | REV. 46
DWG. NO. 60700SH0001

D-03