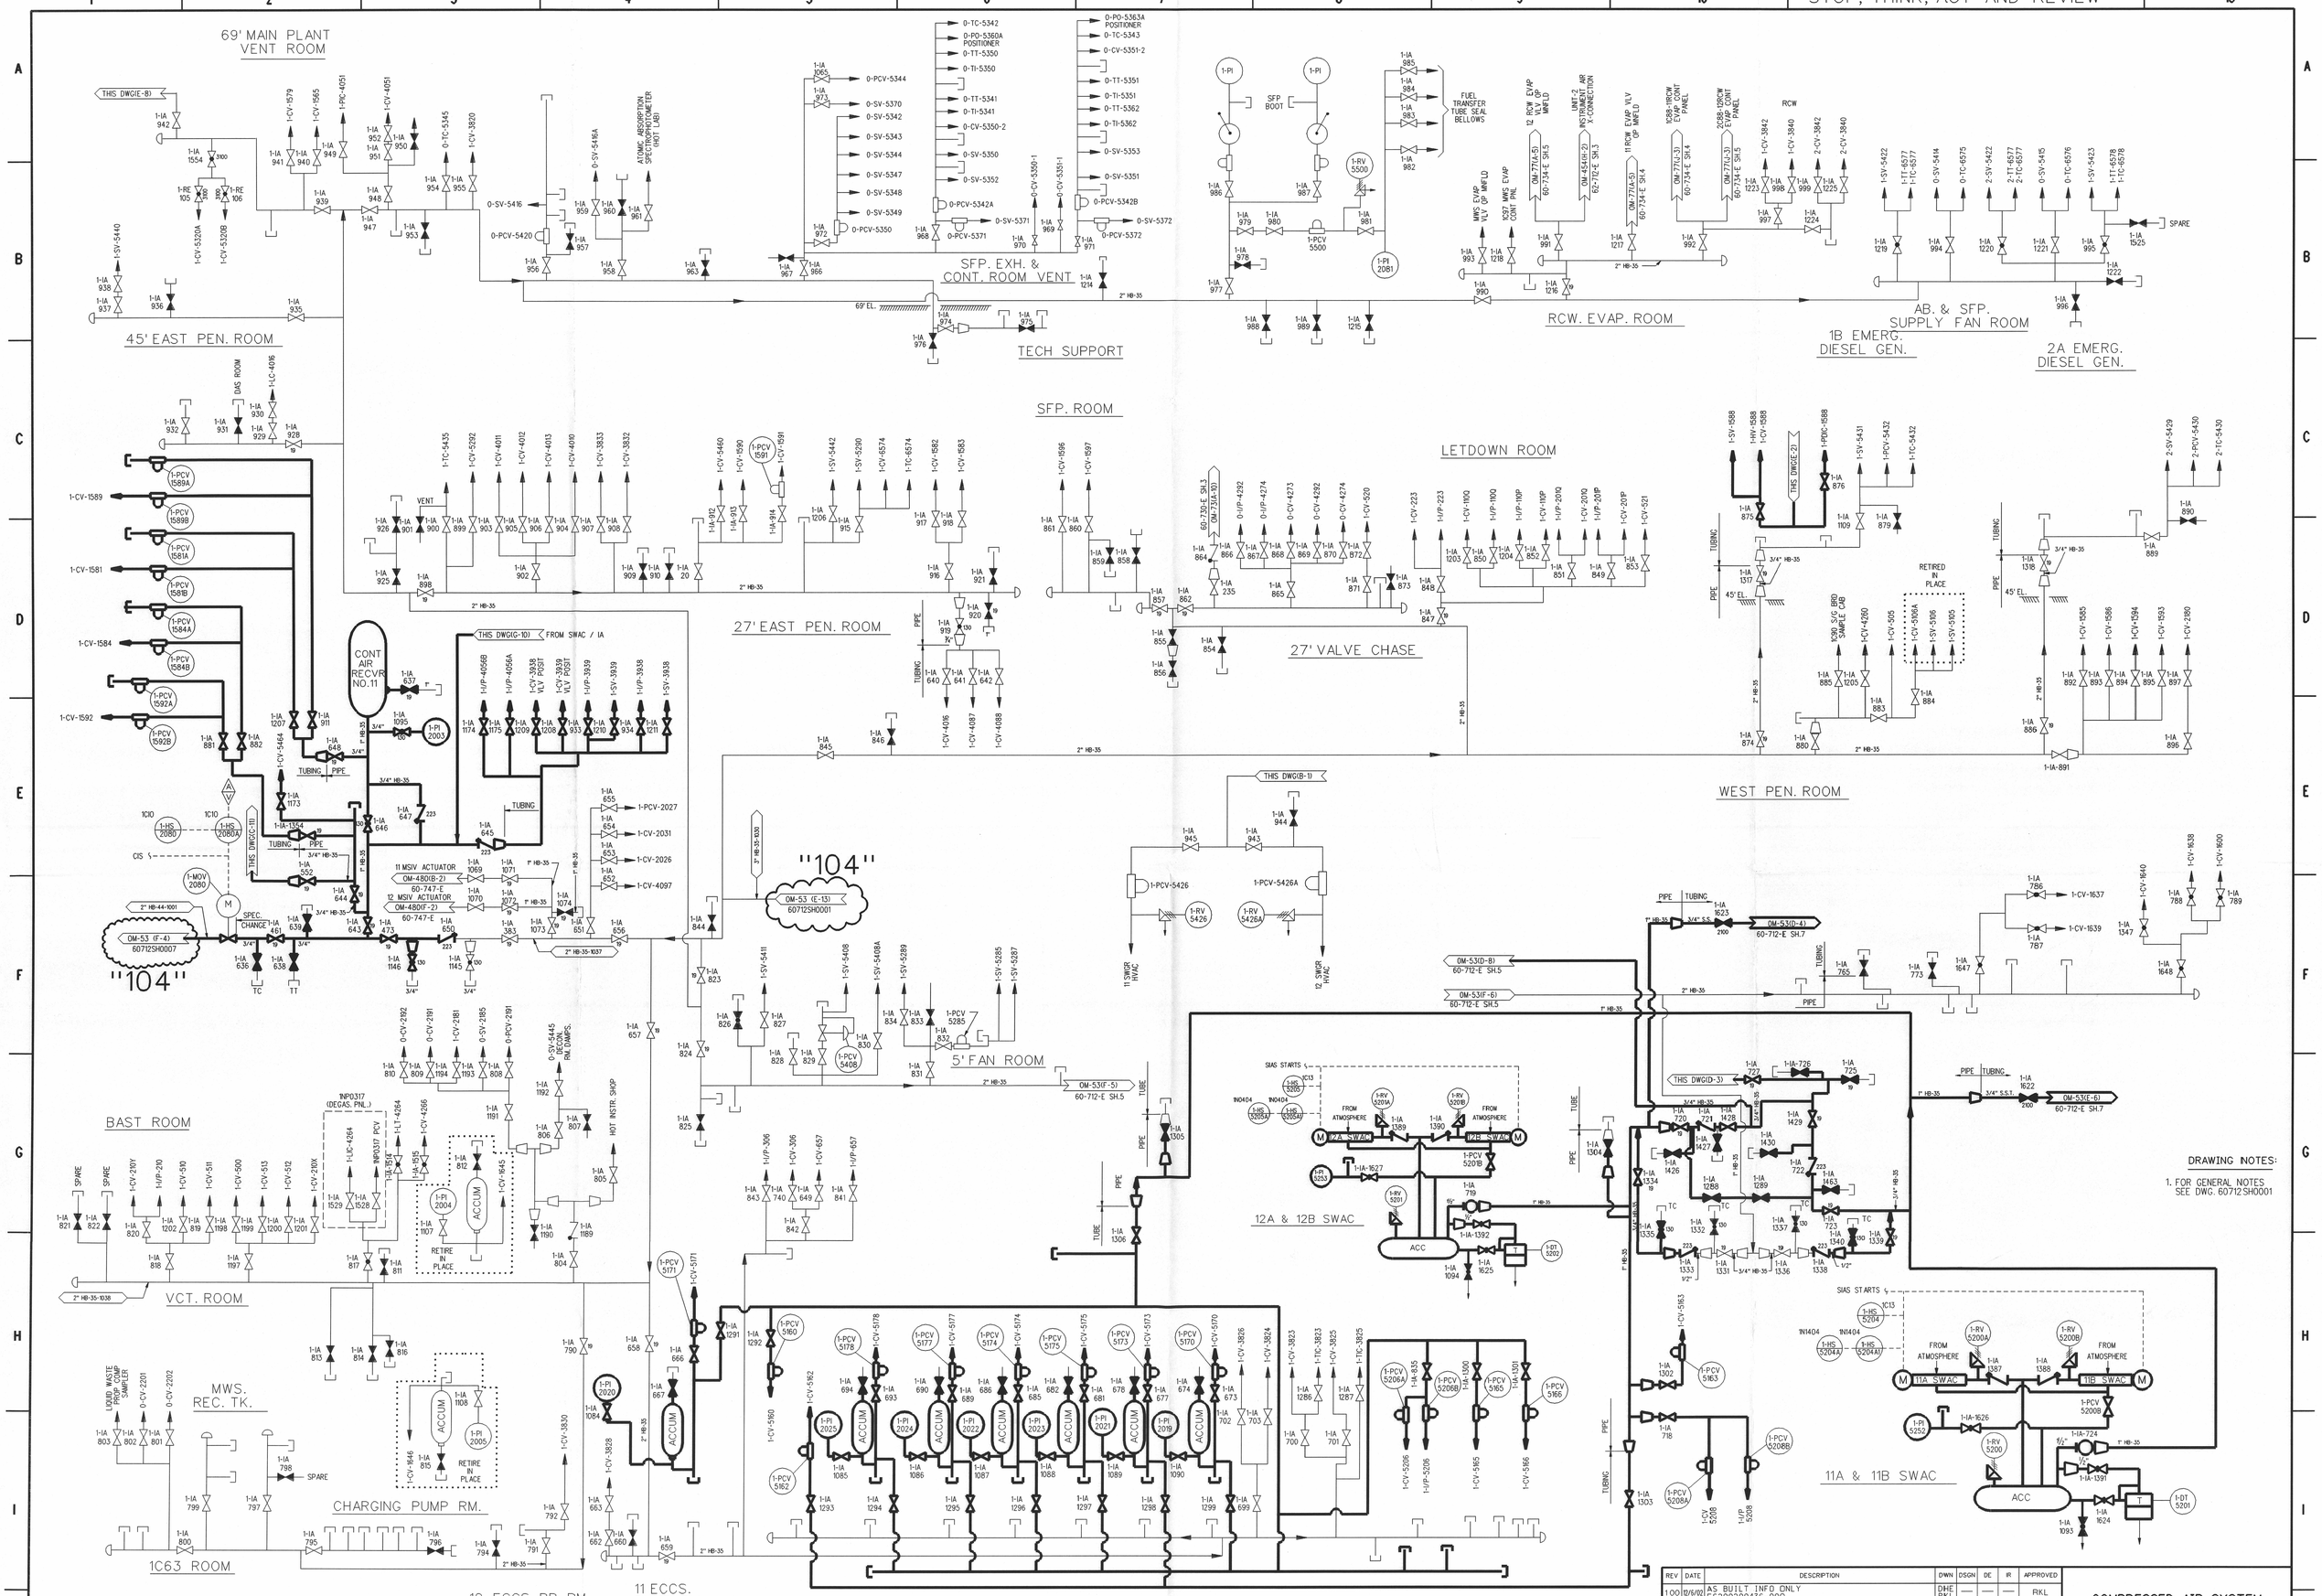

DRAWING NOTES:

1. FOR GENERAL NOTES SEE DWG. 60712SH0001

REV	DATE	DESCRIPTION	DWN	DSGN	DC	IR	APPROVED
100	10/6/02	AS BUILT INFO ONLY ES200200436-000	DHE RKL	—	—	—	RKL
101	2/10/03	AS BUILT INFO ONLY ES199990687-000	WHR RKL	—	—	—	RKL
102	7/30/03	AS BUILT DCN 60712SH0003-2023SH0001 ES199702144-007	DHE RWM	—	—	—	CPM
103	4/30/04	AS BUILT DCN 60712SH0003-2024SH0001, 0002 ES200300306-000	WHR RKL	—	—	—	RKL
104	1/30/07	EDITORIAL CHANGE ONLY	EAM WB	—	EEE	—	CPM

THIS DRAWING CREATED FROM OPERATIONS DRAWING 60-712-E SH.3 (OM-53), REV. 56, DATED 06-14-1994 & P&ID 60-237-E SH.3 (M-53), REV. 45, DATED 04-08-1994.

COMPRESSED AIR SYSTEM
INSTRUMENT AIR & PLANT AIR

CALVERT CLIFFS NUCLEAR POWER PLANT
ENGINEERING SERVICES DEPARTMENT
CALVERT CLIFFS UNIT 1

SCALE: NONE | VENDOR DWG. NO. OM-053SH0003 | SEQ. E | CAT. C | REV. 104
DWG. NO. 60712SH0003

D-11