STOP, THINK, ACT AND REVIEW

GENERAL NOTES

1. FOR P&ID LEGEND SEE M-80 (60263)
2. FOR INSTRUMENT DATA SHEETS SEE M-500 (92401-92422).
3. FOR EQUIPMENT LIST SEE M-603 (92722).
4. EQUIPMENT NUMBERS FOR UNIT NO.1 ARE PREFIXED BY THE NUMBER 1. (EXAMPLE:NO.11,12,13,ETC...) EQUIPMENT NUMBERS FOR UNIT NO.2 ARE PREFIXED BY THE NUMBER 2. (EXAMPLE: NO.21,22,23,ETC...) EQUIPMENT COMMON TO BOTH UNITS IS NUMBERED AS FOR UNIT NO.1.
5. ONE MOVABLE RESIN ADDITION TANK (OTKRESINADD) SERVICES BOTH UNITS. FOUR (2/UNIT) DEMIN. WATER HOSE CONNECTIONS ARE FURNISHED IN VICINITY OF HATCHES.
6. FOR DEFINITION OF LINE DESIGNATIONS SEE PIPING CLASS AND SUMMARY SHEETS M-600 & 601. (92767, 92768 & 92769.

GENERAL NOTES CONT.

7. THE Q-LIST INFORMATION PROVIDED ON THIS DRAWING IDENTIFIES THE SAFETY RELATED PRESSURE BOUNDARIES (SR-PB). EQUIPMENT WITHIN THE BOUNDARIES IS ALSO CLASSIFIED SR-PB, AS A MINIMUM. THE NUCLEIS MASTER EQUIPMENT LIST MUST BE USED FOR IDENTIFYING SPECIFIC OR ADDITIONAL SAFETY CLASSIFICATION INFORMATION, INCLUDING COMPONENT CLASSIFICATIONS AND ASSOCIATED REQUIREMENTS.
8. PIPING WHICH CONTINUES BEYOND THE SAFETY RELATED (SR-PB) BOUNDARY INDICATED ON THIS DRAWING, IS CLASSIFIED SR-PB UP TO AND INCLUDING THE FIRST SEISMIC ANCHOR.
9. ——— DENOTES SAFETY RELATED PRESSURE BOUNDARIES.
   ——— DENOTES NON-SAFETY RELATED PRESSURE BOUNDARIES.
10. WHEN NITROGEN SPARGING IS IN OPERATION, THIS VALVE IS FUNCTIONALLY DISABLED AND CANNOT BE SHUT.

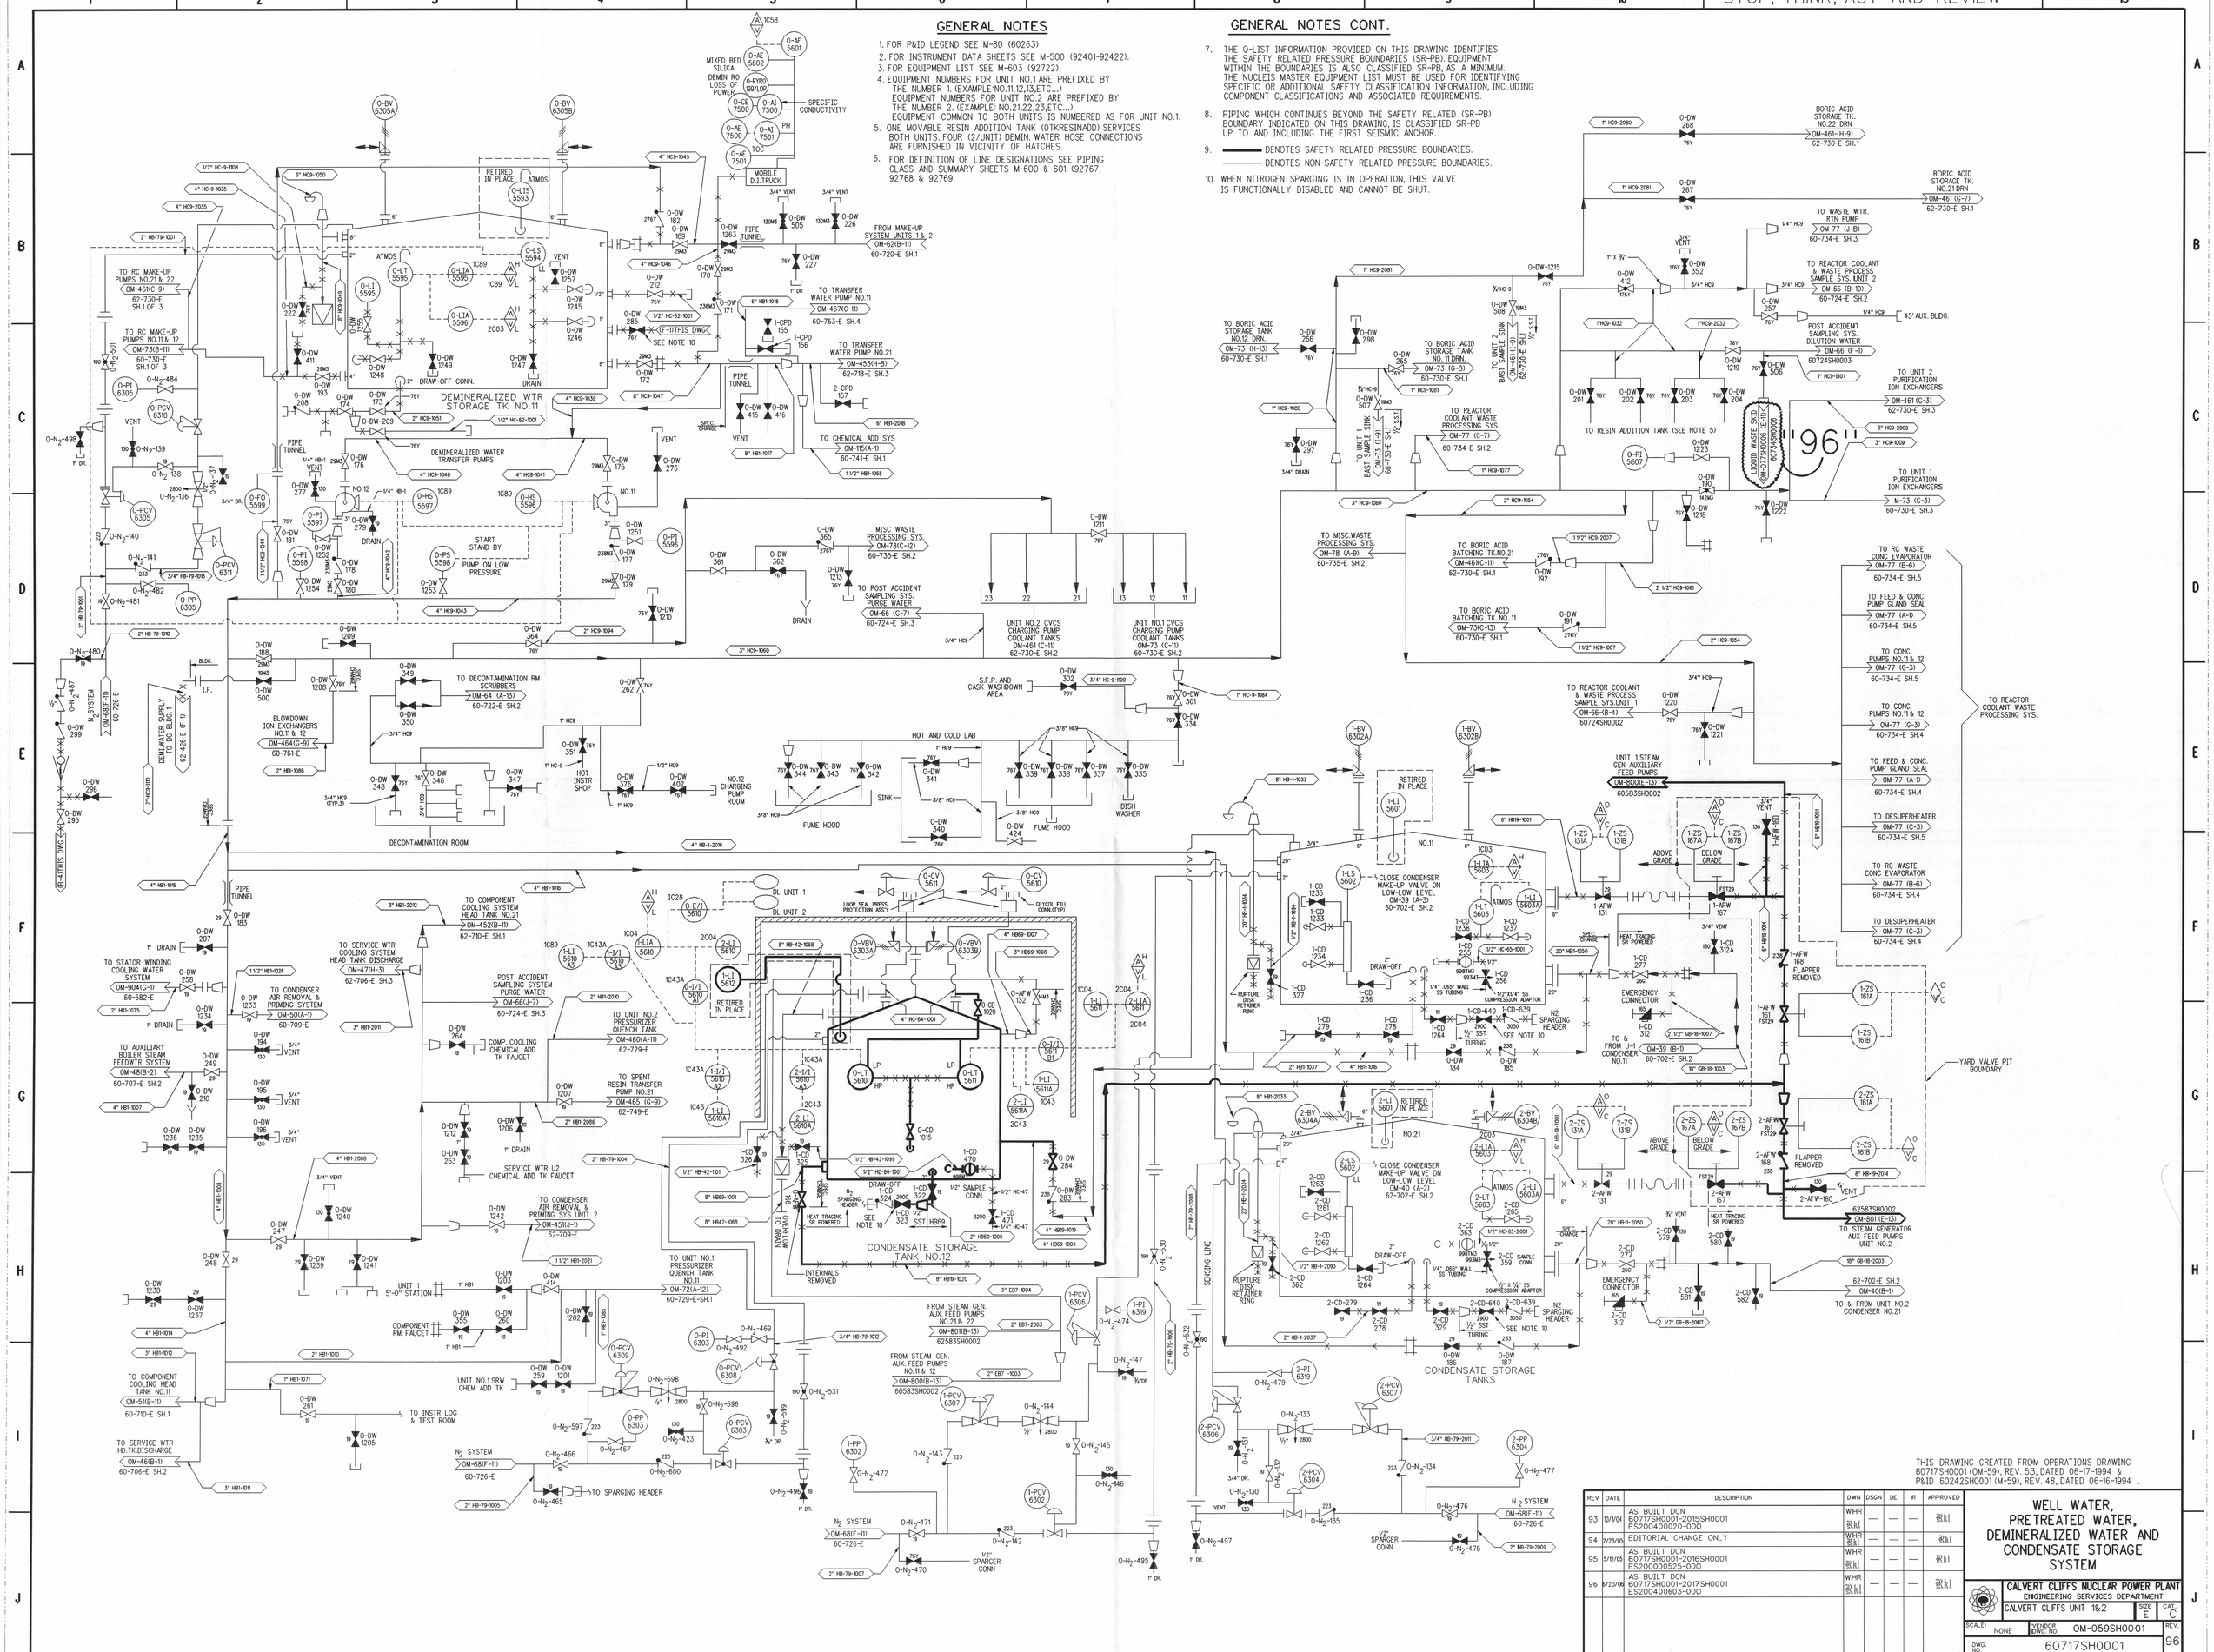

THIS DRAWING CREATED FROM OPERATIONS DRAWING 60717SH0001 (OM-59), REV. 53, DATED 06-17-1994 & P&ID 60242SH0001 (M-59), REV. 48, DATED 06-16-1994 .

REV	DATE	DESCRIPTION	DWN	DSGN	DE	IR	APPROVED
93	10/1/04	AS BUILT DCN 60717SH0001-2015SH0001 ES200400020-000	WHR	—	—	—	
94	2/23/05	EDITORIAL CHANGE ONLY	WHR	—	—	—	
95	5/12/05	AS BUILT DCN 60717SH0001-2016SH0001 ES200000525-000	WHR	—	—	—	
96	6/20/06	AS BUILT DCN 60717SH0001-2017SH0001 ES200400603-000	WHR	—	—	—	

WELL WATER, PRETREATED WATER, DEMINERALIZED WATER AND CONDENSATE STORAGE SYSTEM

CALVERT CLIFFS NUCLEAR POWER PLANT
ENGINEERING SERVICES DEPARTMENT

CALVERT CLIFFS UNIT 1&2 | SIZE E | CAT. C

SCALE: NONE | VENDOR DWG. NO. OM-059SH0001 | REV. 96

DWG. NO. 60717SH0001

D-15