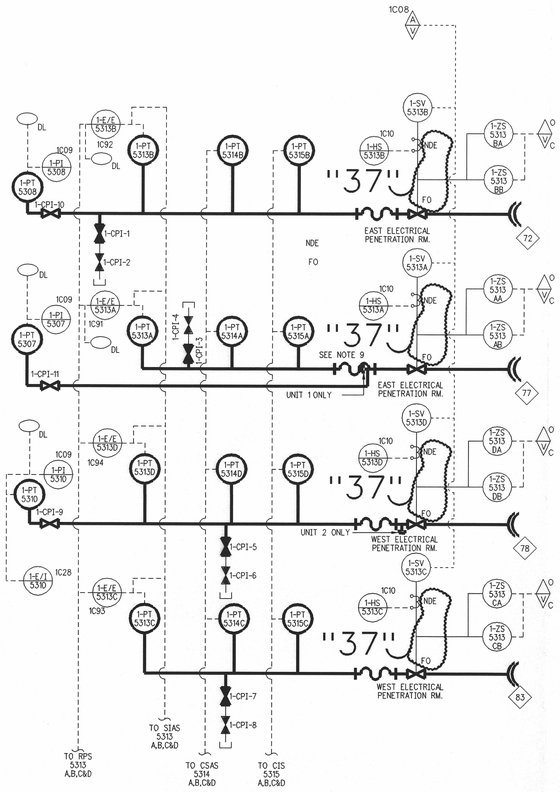

CONTAINMENT PRESSURE INSTR.

UNIT NO. 1 SHOWN
UNIT NO.2 SAME (SEE NOTE 5)

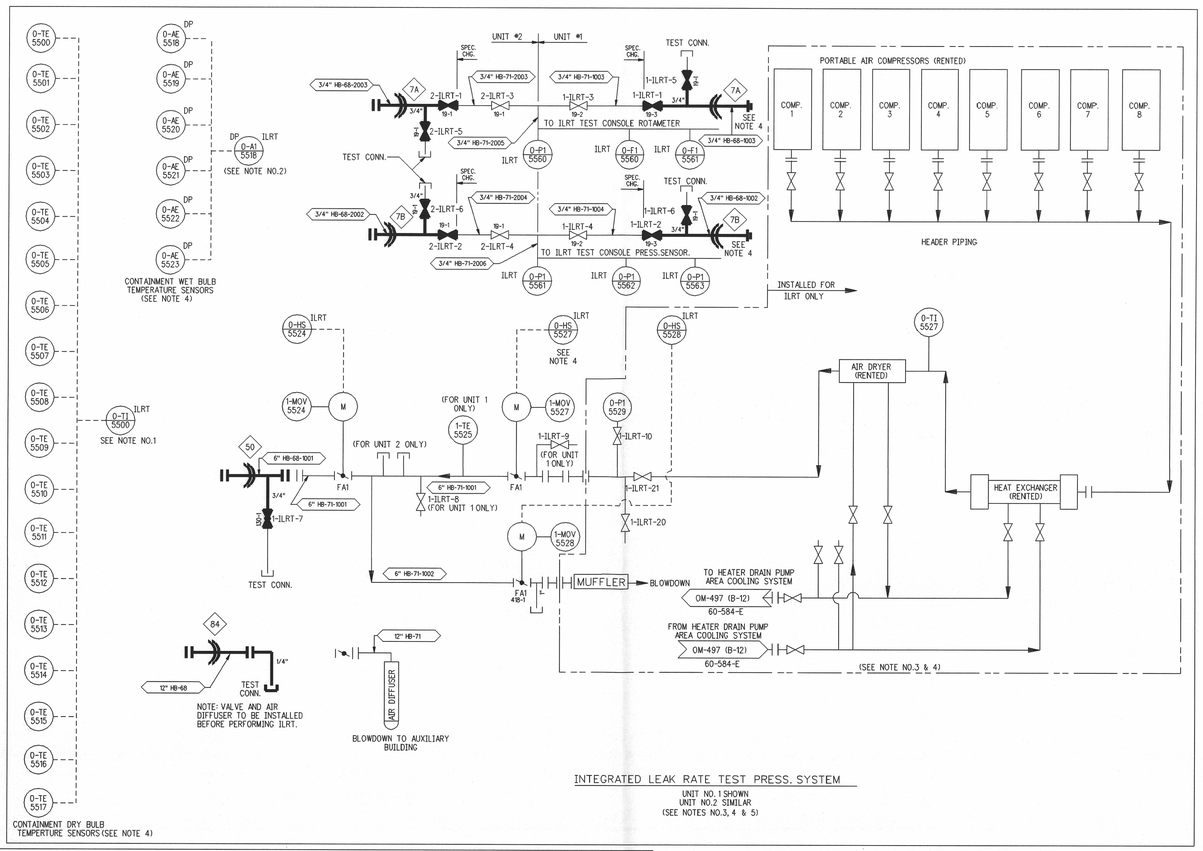

INTEGRATED LEAK RATE TEST PRESS. SYSTEM

UNIT NO. 1 SHOWN
UNIT NO.2 SIMILAR
(SEE NOTES NO.3, 4 & 5)

GENERAL NOTES

1. TEMPERATURE ELEMENTS AND INDICATOR ARE FOR USE IN UNIT NO.1 AND NO.2. WIRING IN EACH UNIT FOR THE TEMPERATURE ELEMENTS WILL BE PERMANENT.
2. DEW POINT DETECTORS AND INDICATOR ARE FOR USE IN UNIT NO.1 AND NO.2. WIRING FOR DEW POINT INDICATOR SYSTEM WILL BE PERMANENT.
3. PORTABLE EQUIPMENT FOR USE ON UNIT NO.1 AND NO.2.
4. COMPONENTS ARE FIELD PURCHASED.
5. EQUIPMENT NUMBERS FOR UNIT NO.1 ARE PREFIXED BY THE NUMBER 1 (EXAMPLE NO.11,12,13 ETC).
   EQUIPMENT NUMBERS FOR UNIT NO.2 ARE PREFIXED BY THE NUMBER 2 (EXAMPLE NO.21,22,23 ETC).
   EQUIPMENT COMMON TO BOTH UNITS IS NUMBERED AS FOR UNIT NO.1
6. PENETRATION ROOM EXHAUST FILTER UNIT & CONTAINMENT VENT/ HYDROGEN PURGE SYSTEM FOR UNIT NO.2 IS THE SAME AS FOR UNIT NO.1, EXCEPT PREFIXED BY THE NO.2.
7. FOR EQUIPMENT LIST SEE 6750-M-603 (B.G.&E. NO.92-772-A).
8. FOR INSTRUMENT DATA SHEETS SEE 6750-M-500 (B.G.&E NO.92-401-A THRU 92-422-B).
9. FOR UNIT 2, FLEX. TUBING IS INSTALLED TO INCLUDE TAKEOFF FOR 2-PT-5307.
10. FOR P&ID LEGEND SEE DRAWING 6750-M-BO(B.G.&E. NO.60-263-E).
11. THE Q-LIST INFORMATION PROVIDED ON THIS DRAWING IDENTIFIES THE SAFETY RELATED PRESSURE BOUNDARIES (SR-PB). EQUIPMENT WITHIN THE BOUNDARIES IS ALSO CLASSIFIED SR-PB, AS A MINIMUM. THE NUCLEIS MASTER EQUIPMENT LIST MUST BE USED FOR IDENTIFYING SPECIFIC OR ADDITIONAL SAFETY CLASSIFICATION INFORMATION, INCLUDING COMPONENT CLASSIFICATIONS AND ASSOCIATED REQUIREMENTS.
12. PIPING WHICH CONTINUES BEYOND THE SAFETY RELATED (SR-PB) BOUNDARY INDICATED ON THIS DRAWING, IS CLASSIFIED SR-PB UP TO AND INCLUDING THE FIRST SEISMIC ANCHOR.
13. ——— DENOTES SAFETY RELATED PRESSURE BOUNDARIES.
    ——— DENOTES NON-SAFETY RELATED PRESSURE BOUNDARIES.
14. BLIND FLANGE IS ONLY INSTALLED DURING LOCAL LEAK RATE TESTING.

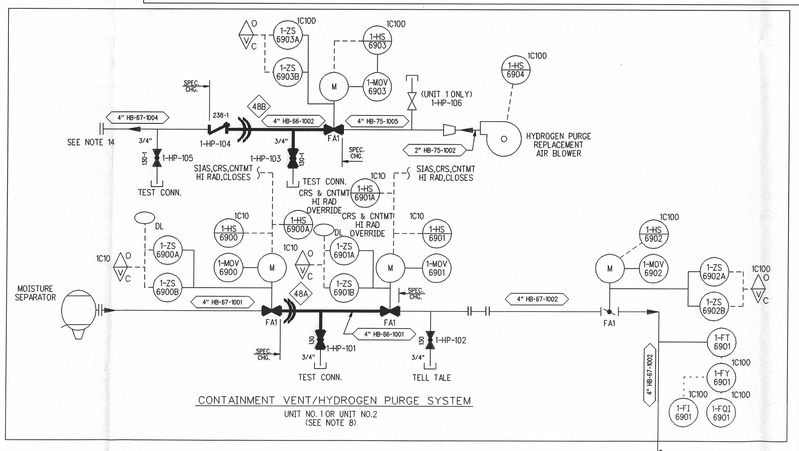

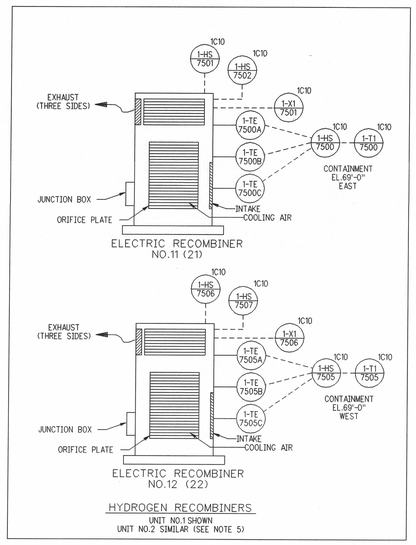

HYDROGEN RECOMBINERS

UNIT NO.1 SHOWN
UNIT NO.2 SIMILAR (SEE NOTE 5)

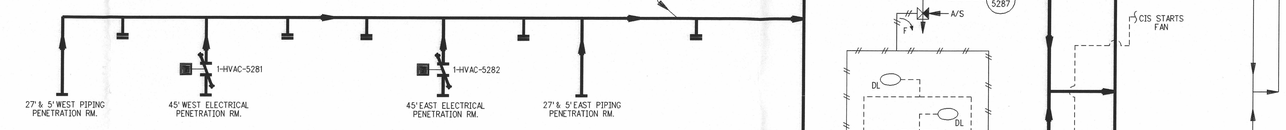

PENETRATION ROOM EXHAUST SYSTEM

UNIT NO.1 SHOWN
UNIT NO.2 SIMILAR (SEE NOTE 6)

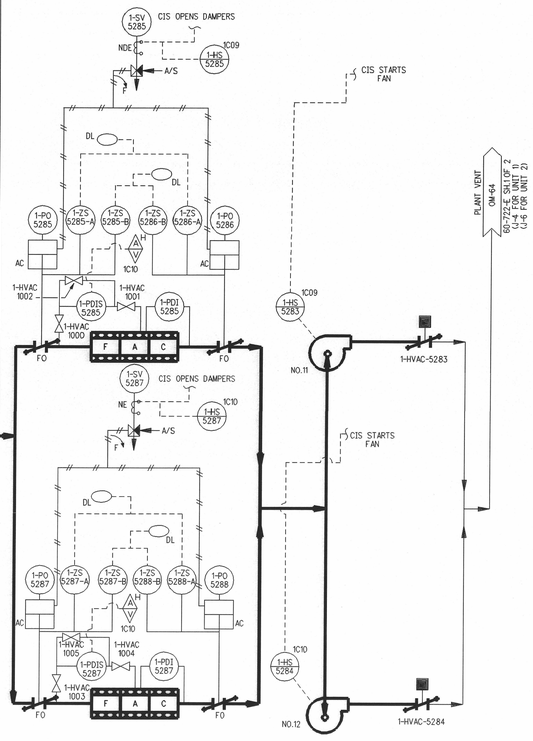

PENETRATION ROOM EXHAUST FILTER UNIT

UNIT NO. 1 SHOWN
UNIT NO.2 SIMILAR (SEE NOTE 5)

FSAR FIG.NO.9-20A

THIS DRAWING CREATED FROM OPERATIONS DRAWING 60-723-E SH.2 (OM-65), REV. 25, DATED 11-29-1993 & P&ID 60-248-E SH.2 (M-65), REV. 27, DATED 11-29-1993.

REV	DATE	DESCRIPTION	DWN	DSGN	DE	IR	APPROVED
34	7/27/01	AS BUILT INFO ONLY ES200100590-000	JH	—	—	—	RKL
35	5/1/02	AS BUILT DCN 60723SH0002-2004SH0001 ES20001058-000	JH RKL	—	—	—	RKL
36	8/20/02	AS BUILT INFO ONLY ES200200043-000	WHR RKL	—	—	—	RKL
37	10/3/05	AS BUILT DCN 60723SH0002-2005SH0001 ES200500396-000	WHR	—	—	—	

VENTILATION SYSTEMS: CONTAINMENT TURBINE AND PENETRATION ROOMS

CALVERT CLIFFS NUCLEAR POWER PLANT
ENGINEERING SERVICES DEPARTMENT

CALVERT CLIFFS UNIT 1&2 | SIZE E | CAT C

SCALE: NONE | VENDOR DWG. NO. OM-065SH0002 | REV. 37

DWG. NO. 60723SH0002