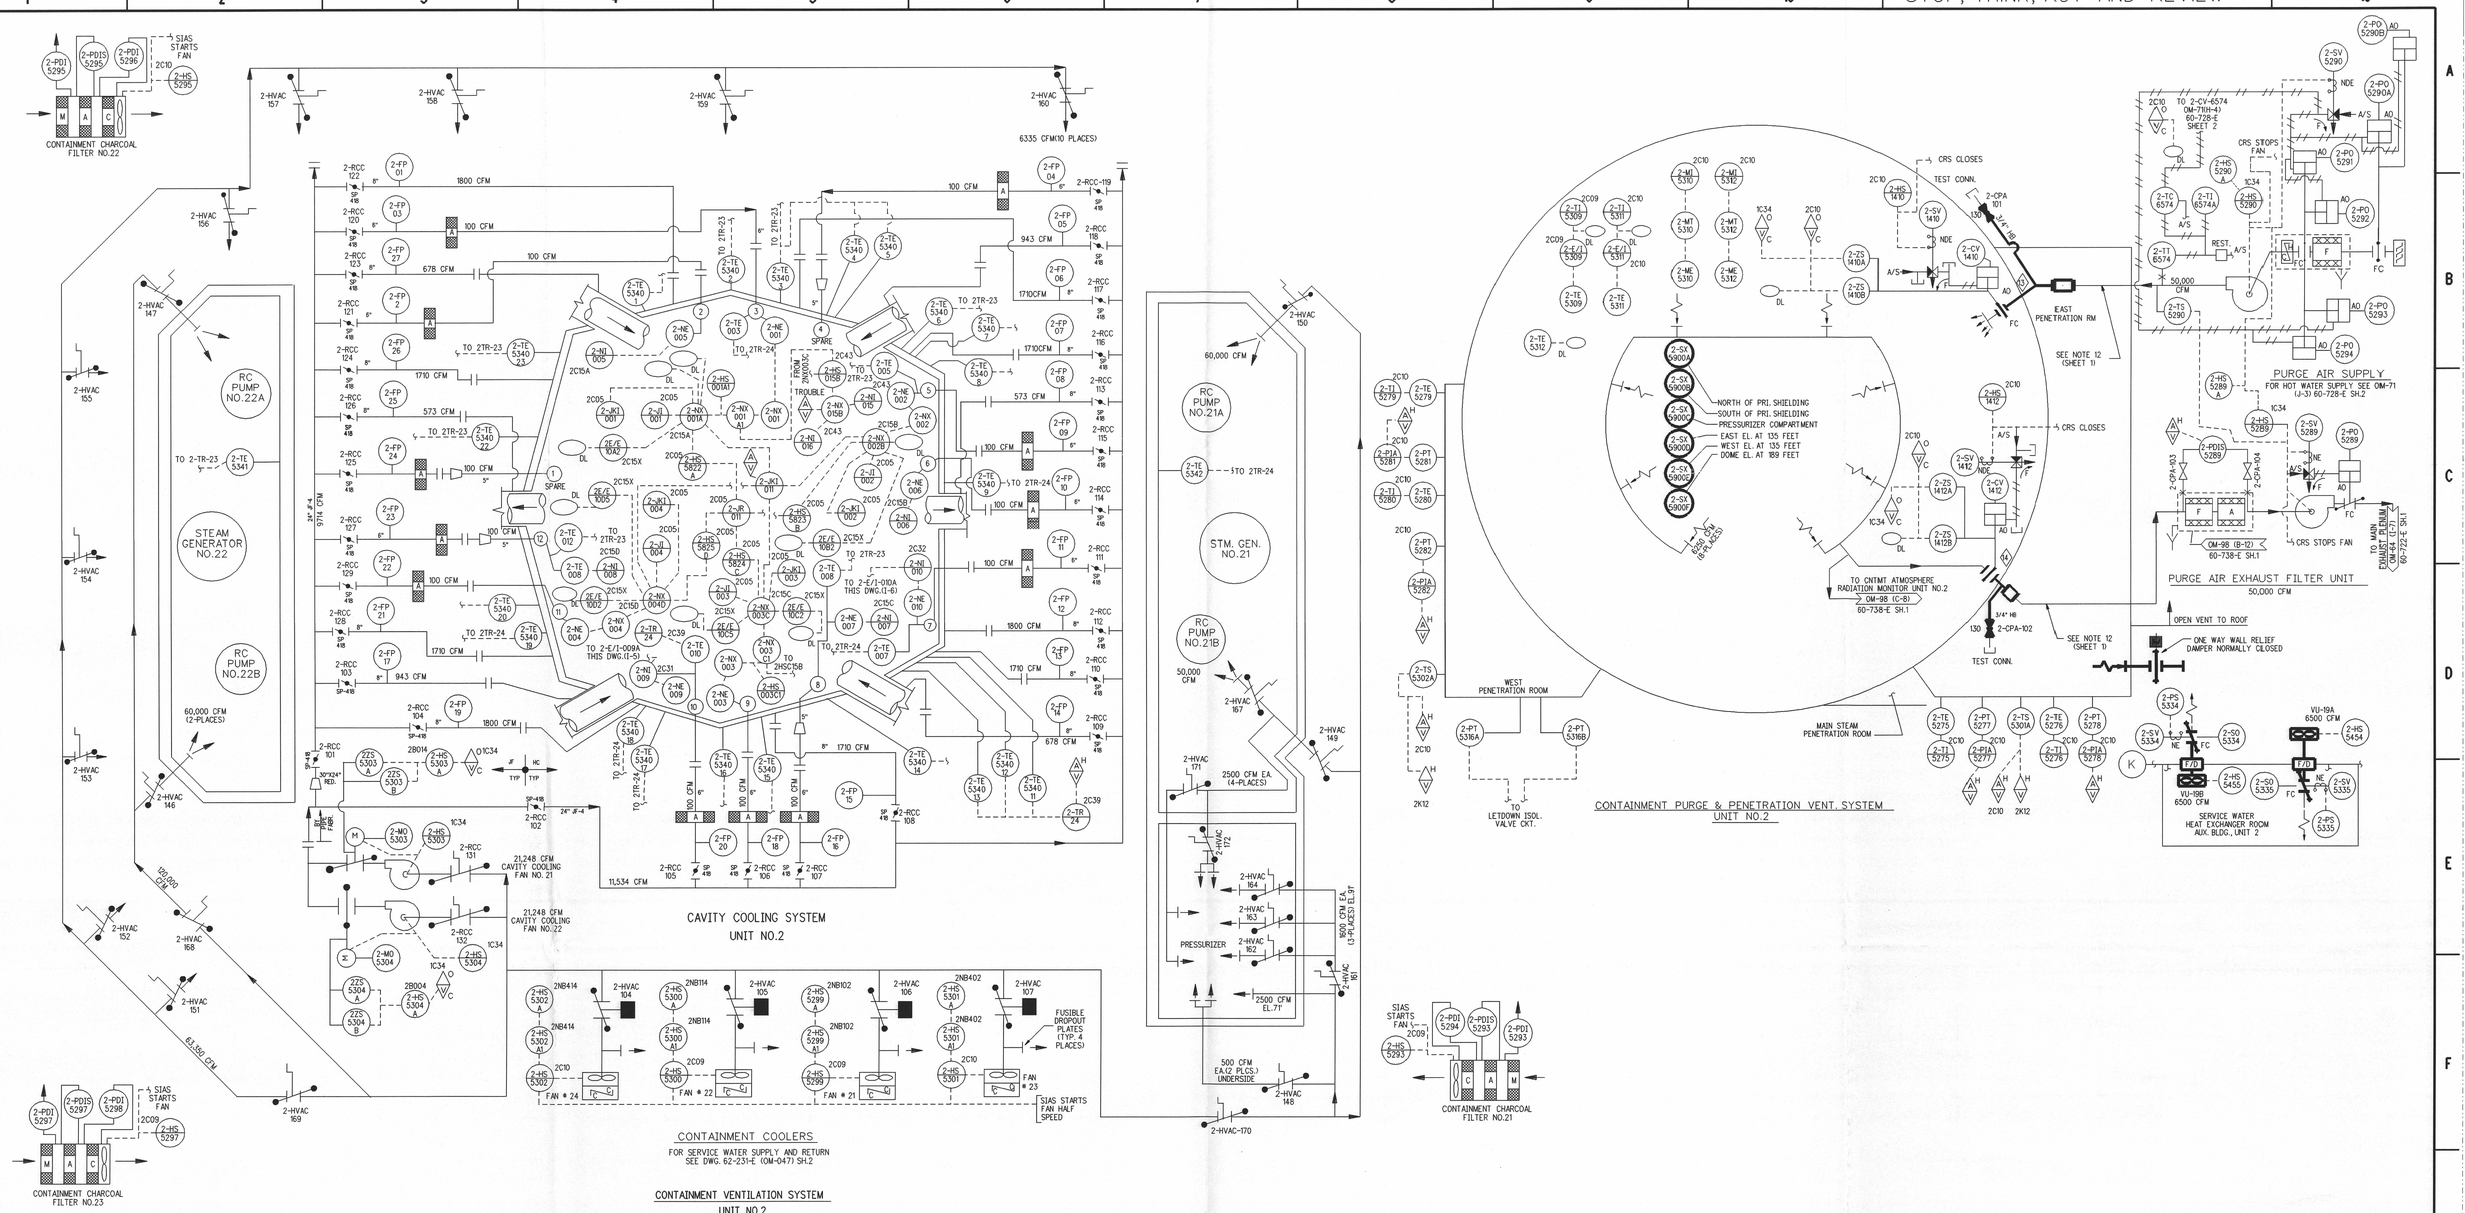

GENERAL NOTES

SEE SHEET 1

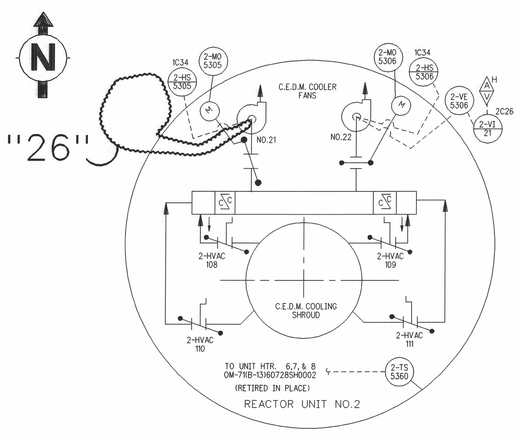

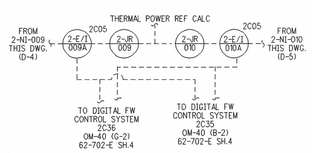

THIS DRAWING CREATED FROM OPERATIONS DRAWING 60-723-E SH.3 (OM-65), REV. 12, DATED 10-6-1993 & P&ID 60-248-E SH.3 (M-65), REV. 10, DATED 06-15-1993.

REV	DATE	DESCRIPTION	DWN	DSGN	DE	IR	APPROVED
24	3/25/03	AS BUILT DCN 60723SH0003-2003SH0001 ES200000239-000	WHR RKL	—	—	—	RKL
25	12/14/04	AS BUILT DCN 60723SH0003-2005SH0001 ES200400733-000	WHR RKL	—	—	—	RKL
26	1/31/06	AS BUILT DCN 60723SH0003-2002SH0001 ES199601487-000	WHR RKL	—	—	—	RKL

VENTILATION SYSTEMS CONTAINMENT

CALVERT CLIFFS NUCLEAR POWER PLANT
ENGINEERING SERVICES DEPARTMENT

CALVERT CLIFFS UNIT 2 | SIZE E | CAT. C

SCALE: NONE | VENDOR DWG. NO. OM-065SH0003 | REV. 26

DWG. NO. 60723SH0003

D-18