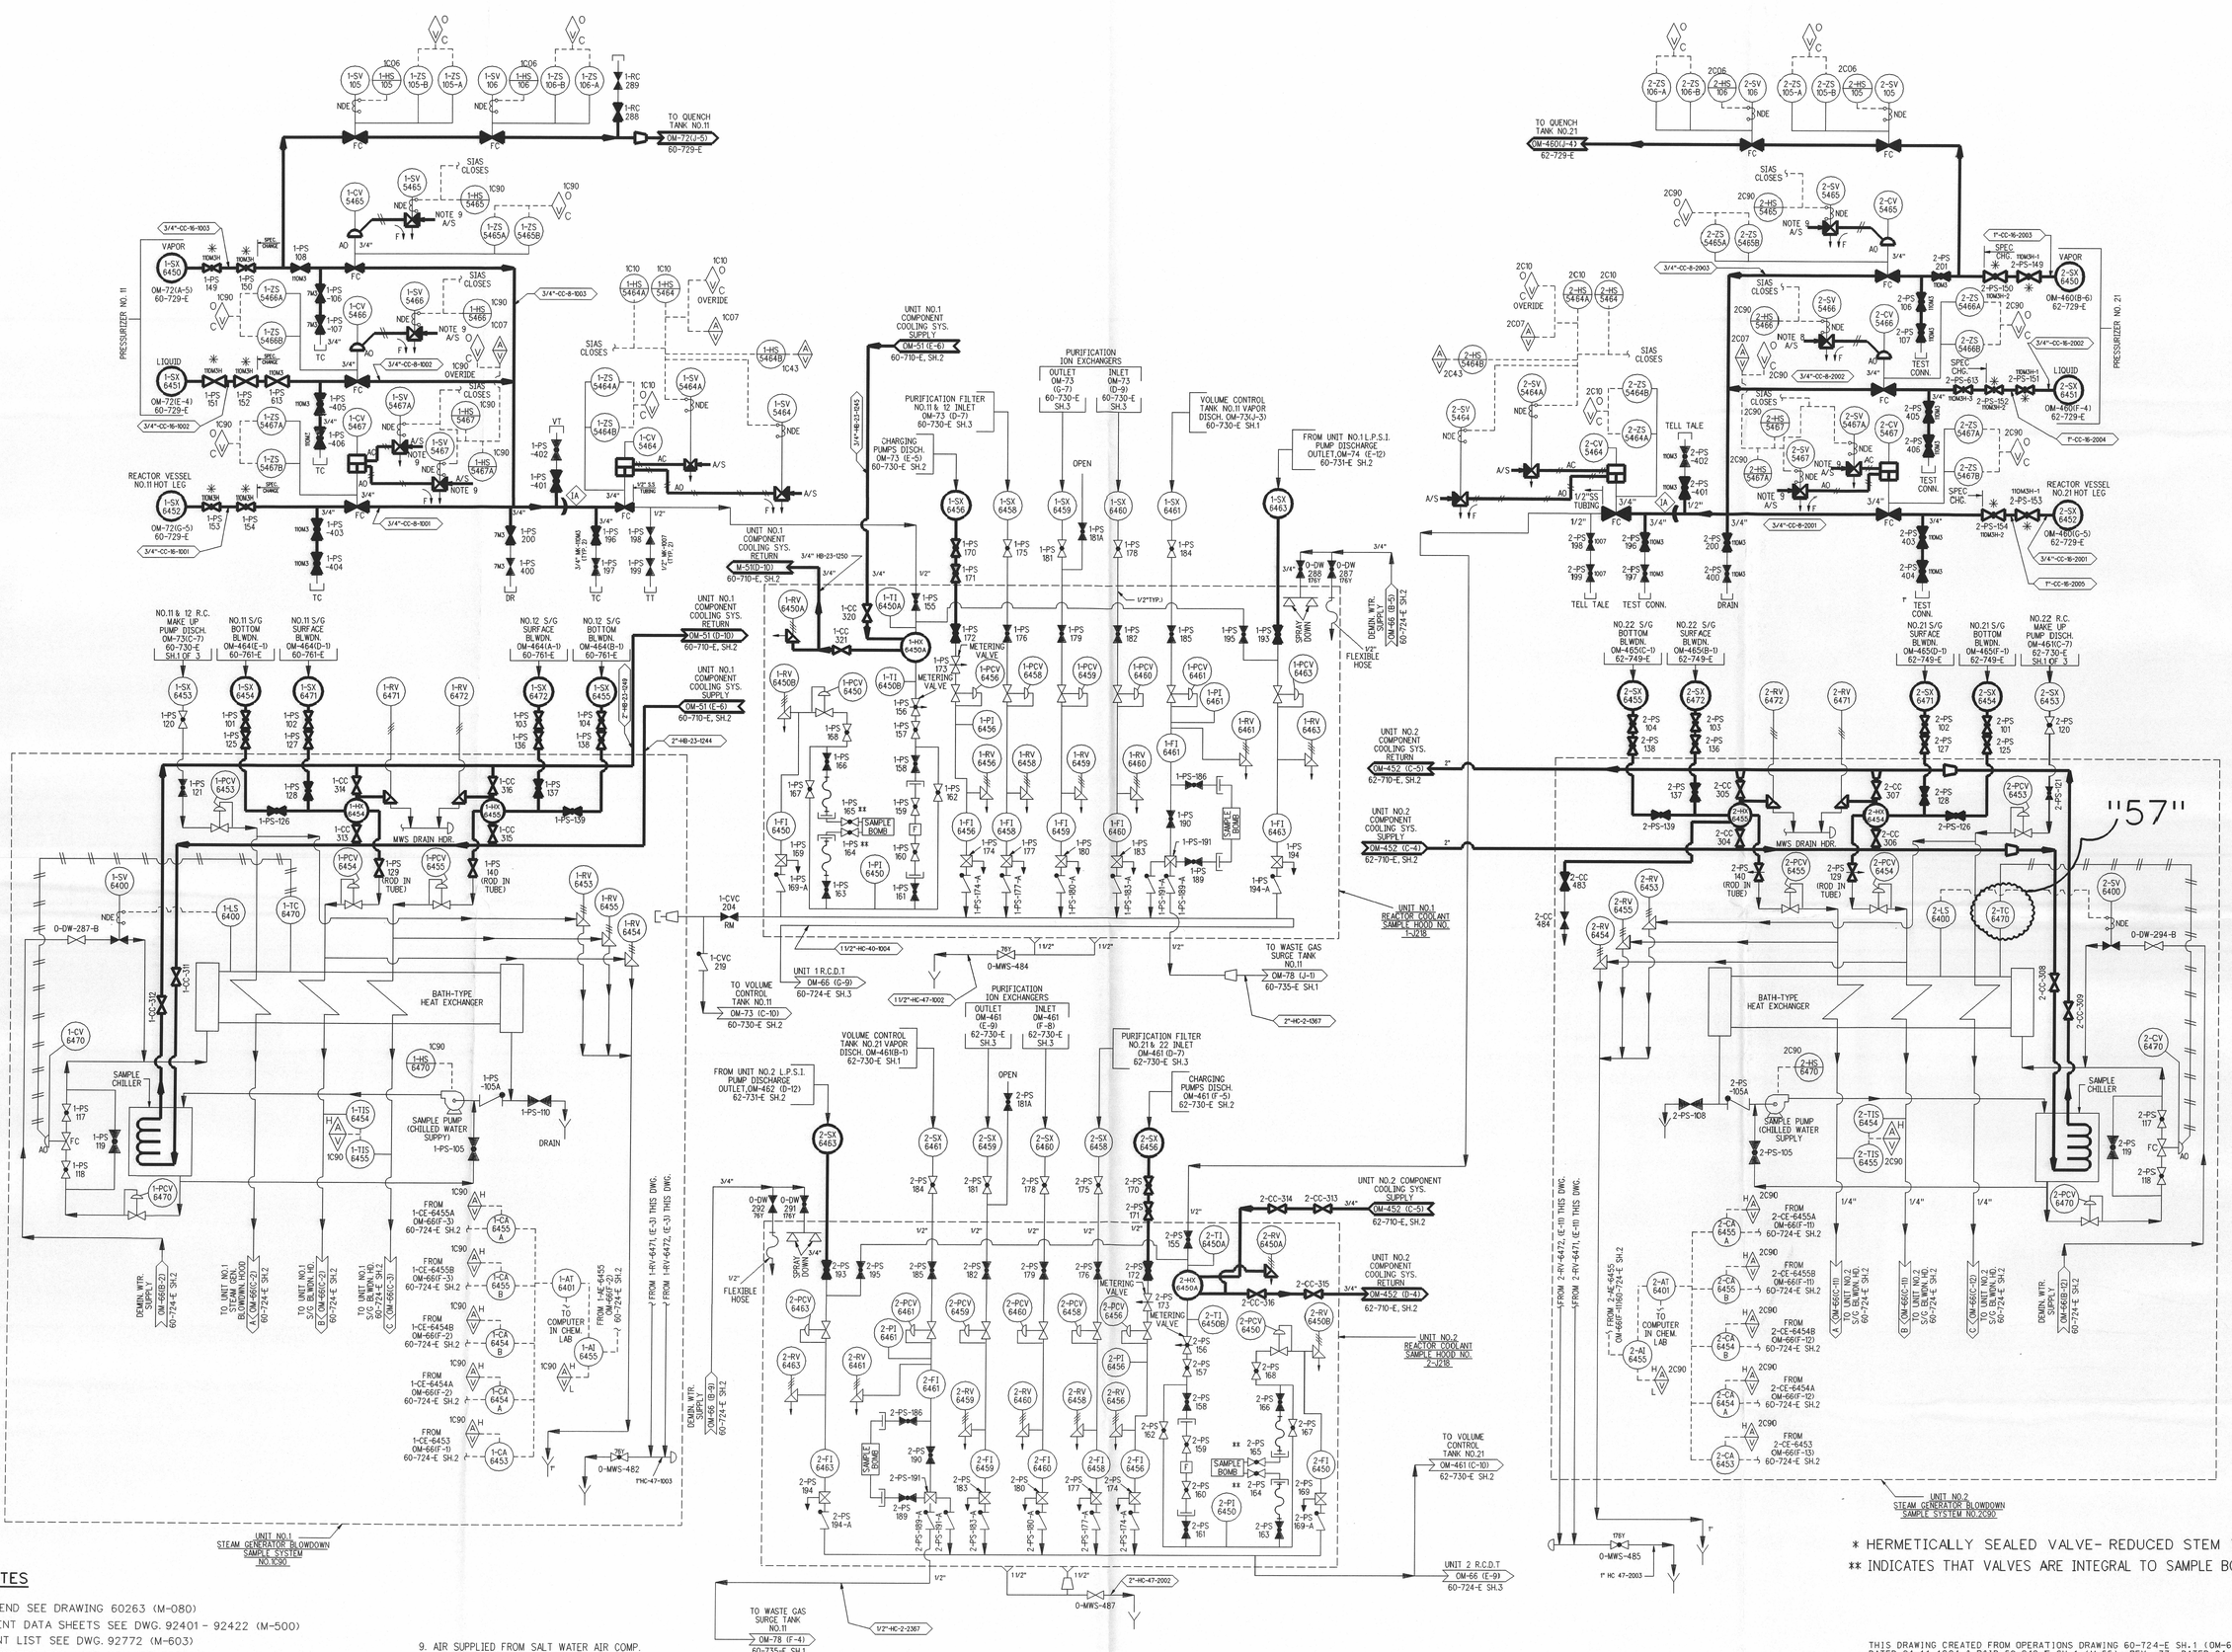

* HERMETICALLY SEALED VALVE- REDUCED STEM TRAVEL

** INDICATES THAT VALVES ARE INTEGRAL TO SAMPLE BOMB

GENERAL NOTES

1. FOR P&ID LEGEND SEE DRAWING 60263 (M-080)
2. FOR INSTRUMENT DATA SHEETS SEE DWG. 92401 - 92422 (M-500)
3. FOR EQUIPMENT LIST SEE DWG. 92772 (M-603)
4. EQUIPMENT NUMBERS FOR UNIT NO.1 ARE PREFIXED BY THE NUMBER 1 (EXAMPLE NO. 11, 12, 13, ETC.). EQUIPMENT NUMBERS FOR UNIT NO.2 ARE PREFIXED BY THE NUMBER 2 (EXAMPLE NO. 21, 22, 23, ETC.). EQUIPMENT COMMON TO BOTH UNITS IS NUMBERED AS FOR UNIT NUMBER 1.
5. AIR SUPPLIED FROM DWG. OM-53 (UNIT NO.1), AND OM-454 (UNIT NO.2).
6. FOR DEFINITION OF LINE DESIGNATIONS SEE PIPING CLASS AND SUMMARY SHEETS M-600 & 601
7. REF. DWGS: (A) R.C. SYS: 6750-M-374-18 (VENDOR DWG. NO. 01122)
   (B) STM. GEN. BLDN. AND MISC. WASTE SYSTEM UNIT NO. 1: 6750-M-374-7 (VENDOR DWG. NO. 01121)
   (C) STM. GEN. BLDN. SYS. UNIT NO. 2 6750-M-374-11 (VENDOR DWG. NO. 01123)
8. EQUIPMENT, INSTR. VALVES ETC, SHOWN INSIDE THE DASH LINE ARE FURNISHED BY OTHERS
9. AIR SUPPLIED FROM SALT WATER AIR COMP. SYSTEM (P. & I. D. OM-049 UNIT 1, OM-450 UNIT 2)
10. DELETED
11. THE Q-LIST INFORMATION PROVIDED ON THIS DRAWING IDENTIFIES THE SAFETY RELATED PRESSURE BOUNDARIES (SR-PB). EQUIPMENT WITHIN THE BOUNDARIES IS ALSO CLASSIFIED SR-PB, AS A MINIMUM. THE NUCLEIS MASTER EQUIPMENT LIST MUST BE USED FOR IDENTIFYING SPECIFIC OR ADDITIONAL SAFETY CLASSIFICATION INFORMATION, INCLUDING COMPONENT CLASSIFICATIONS AND ASSOCIATED REQUIREMENTS.
12. PIPING WHICH CONTINUES BEYOND THE SAFETY RELATED (SR-PB) BOUNDARY INDICATED ON THIS DRAWING, IS CLASSIFIED SR-PB UP TO AND INCLUDING THE FIRST SEISMIC ANCHOR.
13. ——— DENOTES SAFETY RELATED PRESSURE BOUNDARIES.
    ——— DENOTES NON-SAFETY RELATED PRESSURE BOUNDARIES.
14. WHEN MODIFYING THIS DRAWING, VERIFY AGAINST 60729SH0003 & 62729SH0003 FOR POSSIBLE ADDITIONAL CHANGES. SOME COMPONENTS ON THIS DRAWING ARE ALSO SHOWN ON THOSE DRAWINGS TO BE USED FOR REACTOR COOLANT VACUUM REFILL BOUNDARIES.

THIS DRAWING CREATED FROM OPERATIONS DRAWING 60-724-E SH.1 (OM-66). REV. 38. DATED 04-11-1994 & P&ID 60-249-E SH.1 (M-66). REV. 37. DATED 04-11-1994.

REV	DATE	DESCRIPTION	DWN	DSGN	DE	IR	APPROVED
52	5/20/02	AS BUILT DCN 60724SH0001-2002SH0001 ES200000883-000	WB	—	—	—	KWJ
53	6/13/02	AS BUILT DCN 60724SH0001-2003SH0001 ES200000883-000	WHR RKL	—	—	—	RKL
54	8/11/04	AS BUILT DCN 60724SH0001-2005SH0001 ES200200075-000	WHR RKL	—	—	—	RKL
55	11/30/05	AS BUILT DCN 60724SH0001-2006SH0001,2 ES200000605-000	WHR RKL	—	—	—	RKL
56	5/9/06	AS BUILT DCN 60724SH0001-2007SH0001 ES200400040-000	WHR RKL	—	—	—	RKL
57	2/19/07	EDITORIAL CHANGE ONLY	EAM CPM	—	—	—	CPM

REACTOR COOLANT & WASTE PROCESS SAMPLE SYSTEM

POST ACCIDENT SAMPLING SYSTEM

CALVERT CLIFFS NUCLEAR POWER PLANT
ENGINEERING SERVICES DEPARTMENT
CALVERT CLIFFS UNIT 1&2

SIZE: E | CAT. C
SCALE: NONE | VENDOR DWG. NO. OM-066SH0001 | REV. 57
DWG. NO. 60724SH0001

D-19