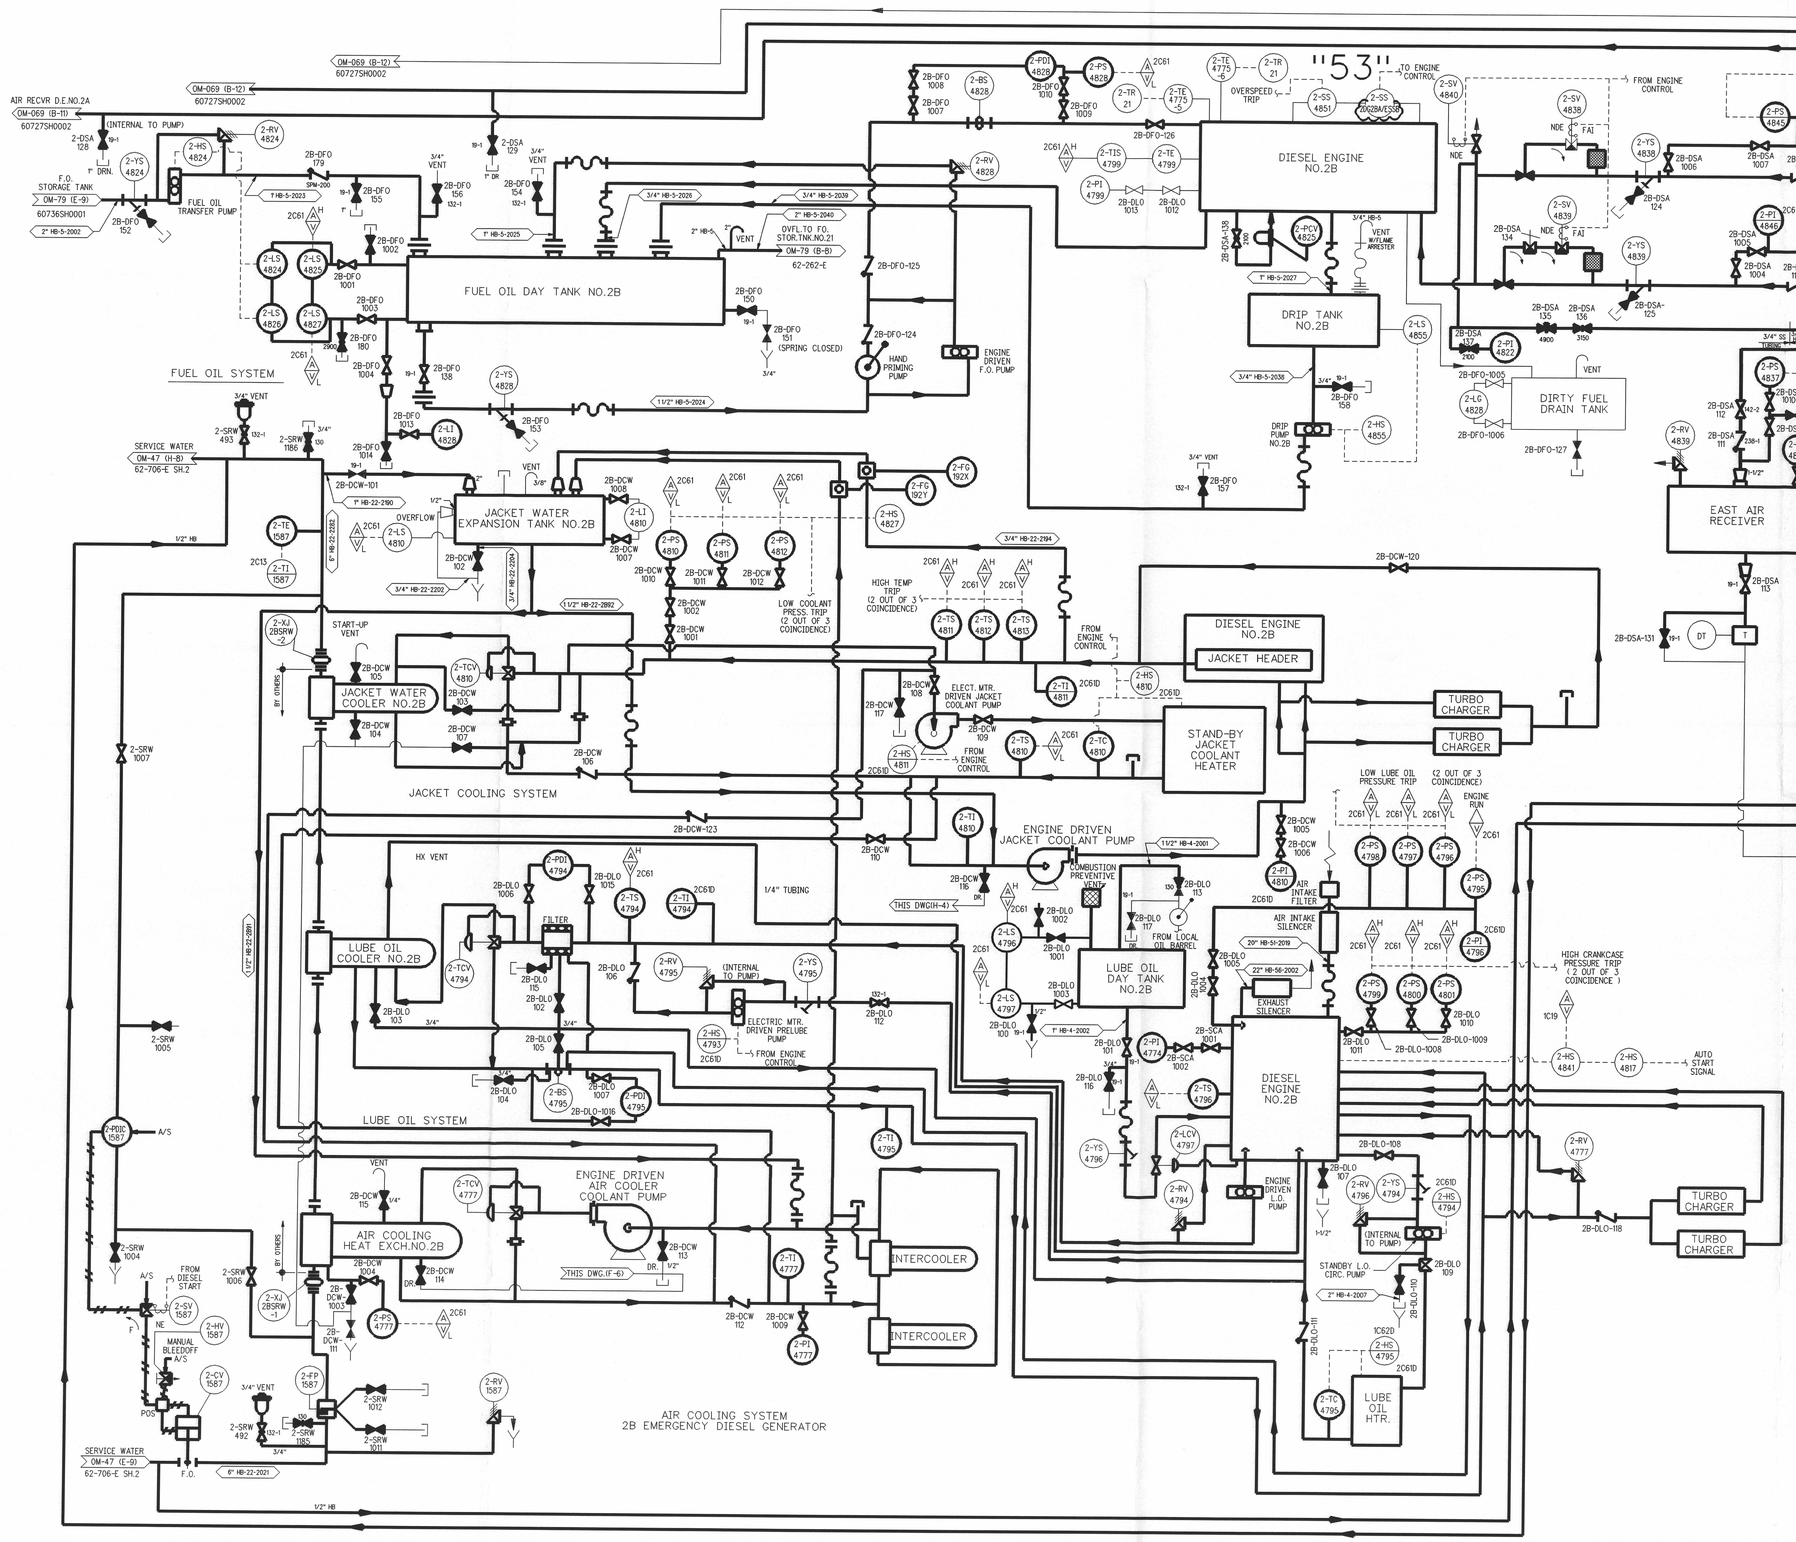

GENERAL NOTES

1. FOR P.&I.D. LEGEND SEE DRAWING 6750-M-80, (B.G.&E. NO.60-263-E).
2. FOR INSTRUMENT DATA SHEETS SEE 6750-M-500, (B.G.& E. NO. 92-401-A THRU 92-422-B).
3. FOR EQUIPMENT LIST SEE 6750-M-603, B.G.& E. NO.92-722-A)
4. EQUIPMENT NUMBERS FOR UNIT NO.1 ARE PREFIXED BY THE NUMBER 1 (EXAMPLES NO. 11, 12, 13, ETC.) EQUIPMENT NUMBERS FOR UNIT NO.2 ARE PREFIXED BY THE NUMBER 2 (EXAMPLE NO. 21, 22, 23, ETC.). EQUIPMENT COMMON TO BOTH UNITS IS NUMBERED AS FOR UNIT NO. 1.
5. FOR DEFINITION OF LINE DESIGNATIONS SEE PIPING CLASS AND SUMMARY SHEETS 6750-M-600 & M-601.
6. SR-PB FOR AIR COMPRESSOR INCLUDES THE COMPONENTS AND TUBING FOR THE COMPRESSOR'S UNLOADER SYSTEM.
7. THE Q-LIST INFORMATION PROVIDED ON THIS DRAWING IDENTIFIES THE SAFETY RELATED PRESSURE BOUNDARIES (SR-PB). EQUIPMENT WITHIN THE BOUNDARIES IS ALSO CLASSIFIED SR-PB, AS A MINIMUM. THE NUCLEIS MASTER EQUIPMENT LIST MUST BE USED FOR IDENTIFYING SPECIFIC OR ADDITIONAL SAFETY CLASSIFICATION INFORMATION, INCLUDING COMPONENT CLASSIFICATIONS AND ASSOCIATED REQUIREMENTS.
8. PIPING WHICH CONTINUES BEYOND THE SAFETY RELATED (SR-PB) BOUNDARY INDICATED ON THIS DRAWING, IS CLASSIFIED SR-PB UP TO AND INCLUDING THE FIRST SEISMIC ANCHOR.
9. ——— DENOTES SAFETY RELATED PRESSURE BOUNDARIES.
   ——— DENOTES NON-SAFETY RELATED PRESSURE BOUNDARIES.

THIS DRAWING CREATED FROM OPERATIONS DRAWING 60-727-E SH.3 (OM-69), REV. 30, DATED 04-21-1994 & P&ID 60-252-E SH.3 (M-69), REV. 23, DATED 04-21-1994.

REV	DATE	DESCRIPTION	DWN	DSGN	DE	IR	APPROVED
49	10/9/03	AS BUILT DCN 60727SH0003-2006SH0001 ES200200344-000	WHR KWJ	–	–	–	KWJ
50	10/6/04	ADMIN CHANGE ONLY	WHR RKL	–	–	–	RKL
51	10/31/05	AS BUILT DCN 60727SH0003-2007SH0001 ES200400676-000	WHR RKL	–	–	–	RKL
52	2/9/06	EDITORIAL CHANGE ONLY	WHR RKL	–	–	–	RKL
53	3/14/07	AS BUILT DCN 60727SH0003-2008SH0001 ES199701358-001	CPM	–	–	–	CPM

DIESEL GENERATOR COOLING WATER, STARTING AIR, FUEL, LUBE OIL DIESEL GENERATOR NO. 2B

CALVERT CLIFFS NUCLEAR POWER PLANT
ENGINEERING SERVICES DEPARTMENT
CALVERT CLIFFS UNIT 1&2

SCALE: NONE | VENDOR DWG. NO. OM-069SH0003 | SIZE E | CAT C | REV. 53
DWG. NO. 60727SH0003

D-25