GENERAL NOTES:

1. FOR P&ID LEGEND SEE DRAWING 6750-M-80 (60263)
2. FOR EQUIPMENT LIST SEE 6750-M-603 (92772)
3. FOR INSTRUMENT DATA SHEETS SEE 6750-M-500 (92401 TO 92422)
4. EQUIPMENT NUMBERS FOR UNIT NO.1 ARE PREFIXED BY THE NUMBER 1 (EXAMPLE NO.11,12,13, ETC.).
   EQUIPMENT NUMBERS FOR UNIT NO.2 ARE PREFIXED BY THE NUMBER 2 (EXAMPLE NO.21,22,23, ETC.).
   EQUIPMENT COMMON TO BOTH UNITS IS NUMBERED AS FOR UNIT NO.1.
5. FOR DEFINITION OF LINE DESIGNATIONS SEE PIPING CLASS AND SUMMARY SHEETS 6750-M-600 & 601 (92767-92769.)
6. THE Q-LIST INFORMATION PROVIDED ON THIS DRAWING IDENTIFIES THE SAFETY RELATED PRESSURE BOUNDARIES (SR-PB). EQUIPMENT WITHIN THE BOUNDARIES IS ALSO CLASSIFIED SR-PB, AS A MINIMUM. THE NUCLEIS MASTER EQUIPMENT LIST MUST BE USED FOR IDENTIFYING SPECIFIC OR ADDITIONAL SAFETY CLASSIFICATION INFORMATION, INCLUDING COMPONENT CLASSIFICATIONS AND ASSOCIATED REQUIREMENTS.
7. PIPING WHICH CONTINUES BEYOND THE SAFETY RELATED (SR-PB) BOUNDARY INDICATED ON THIS DRAWING, IS CLASSIFIED SR-PB UP TO AND INCLUDING THE FIRST SEISMIC ANCHOR.
8. ——— DENOTES SAFETY RELATED PRESSURE BOUNDARIES.
   ——— DENOTES NON-SAFETY RELATED PRESSURE BOUNDARIES.

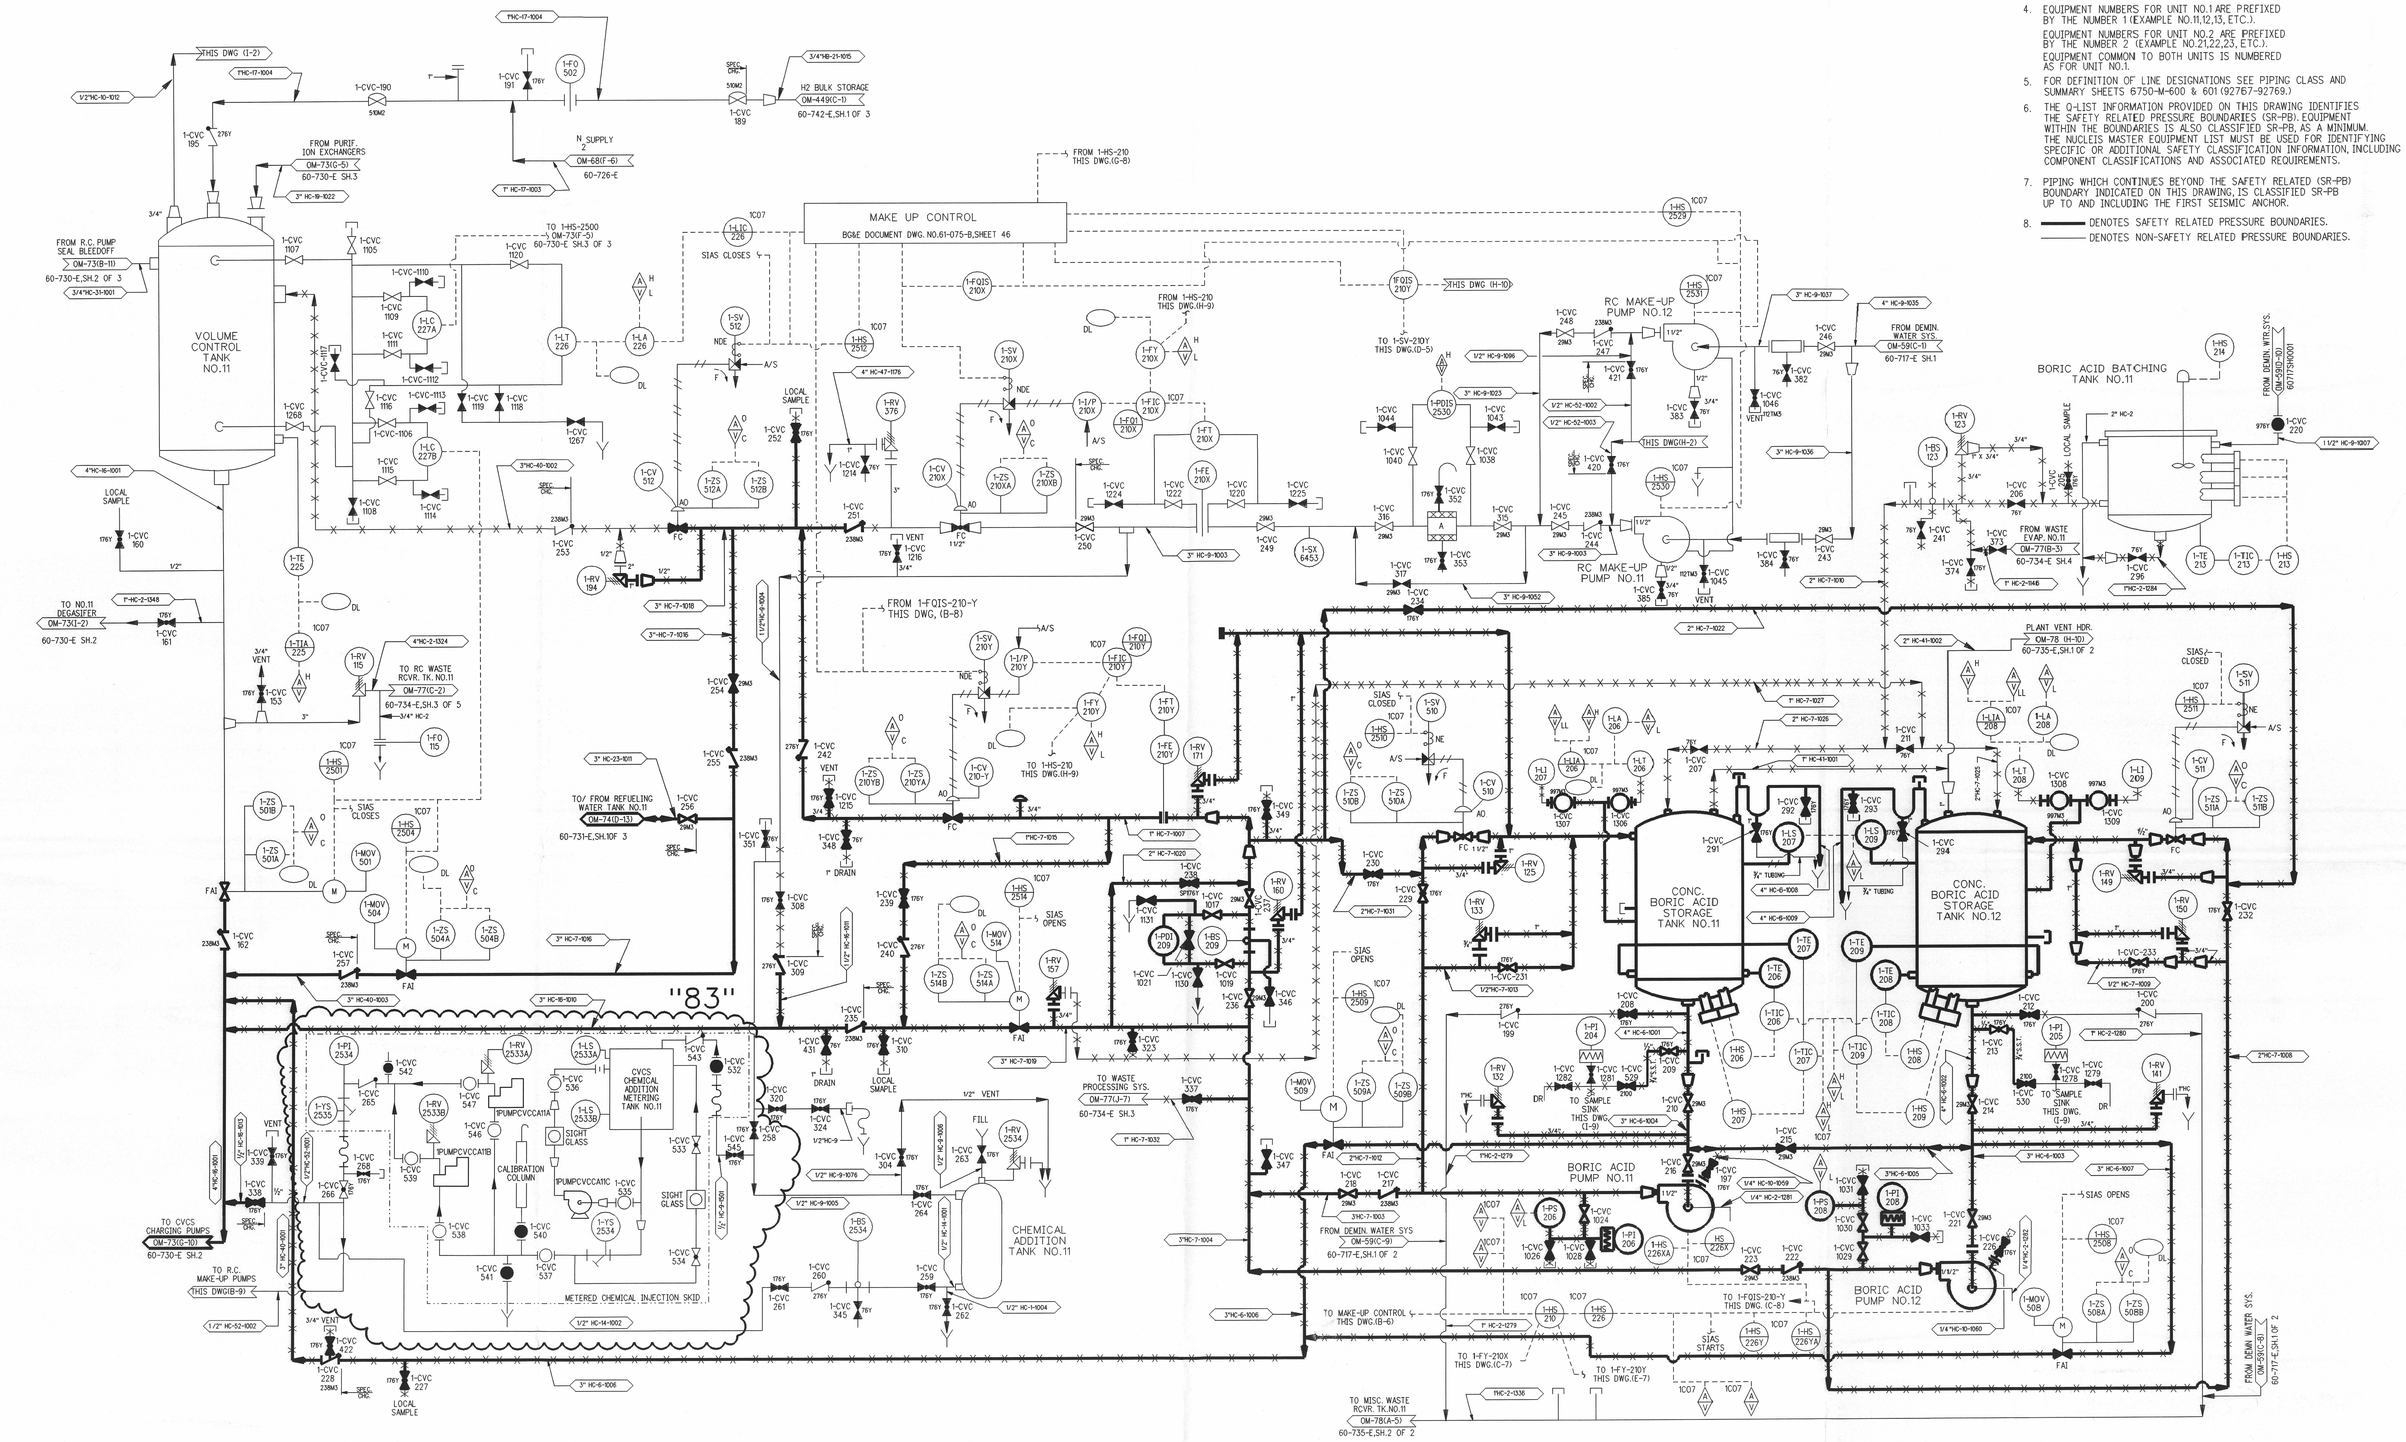

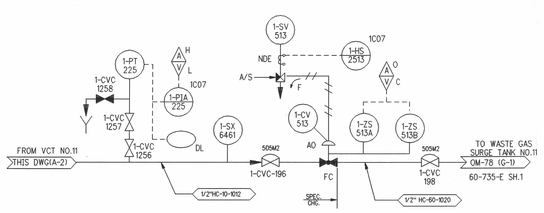

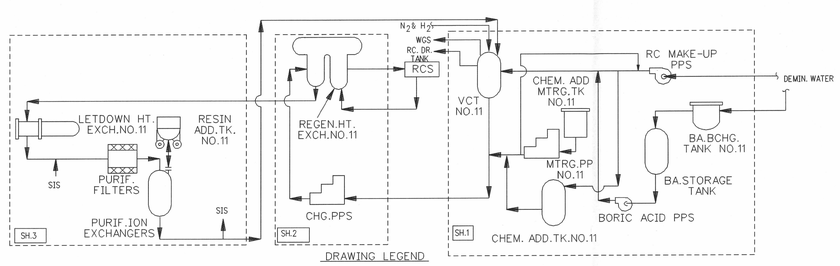

DRAWING LEGEND

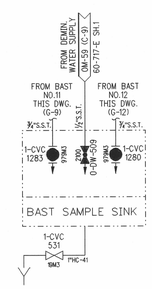

THIS DRAWING CREATED FROM OPERATIONS DRAWING 60-730-E SH.1 (OM-73). REV.54. DATED 3-31-1994 & P&ID 60-256-E SH.1 (M-73). REV.55. DATED 3-31-1994.

REV	DATE	DESCRIPTION	DWN	DSGN	DE	IR	APPROVED
79	5/5/04	AS BUILT DCN 60730SH0001-2015SH0002 REV. B. SH0004 ES200300306-000	WHR RKL	—	—	—	RKL
80	8/10/04	AS BUILT DCN 60730SH0001-2016SH0001 ES200300040-001	WHR RKL	—	—	—	RKL
81	8/25/06	AS BUILT DCN 60730SH0001-2017SH0001 ES200500369-000	WB RKL	—	—	—	RKL
82	1/31/07	AS BUILT DCN 60730SH0001-2018SH0002 REV.A ES200200753-000	WB KWJ	—	—	—	KWJ
83	6/5/07	AS BUILT DCN 60730SH0001-2018SH0001 REV.C ES200200753-000	KWJ	—	—	—	KWJ

CHEMICAL AND VOLUME CONTROL SYSTEM

CALVERT CLIFFS NUCLEAR POWER PLANT
ENGINEERING SERVICES DEPARTMENT
CALVERT CLIFFS UNIT 1

SIZE E | CAT. C
SCALE: NONE | VENDOR DWG. NO. OM-073SH0001 | REV.
DWG. NO. 60730SH0001 | 83

D-20