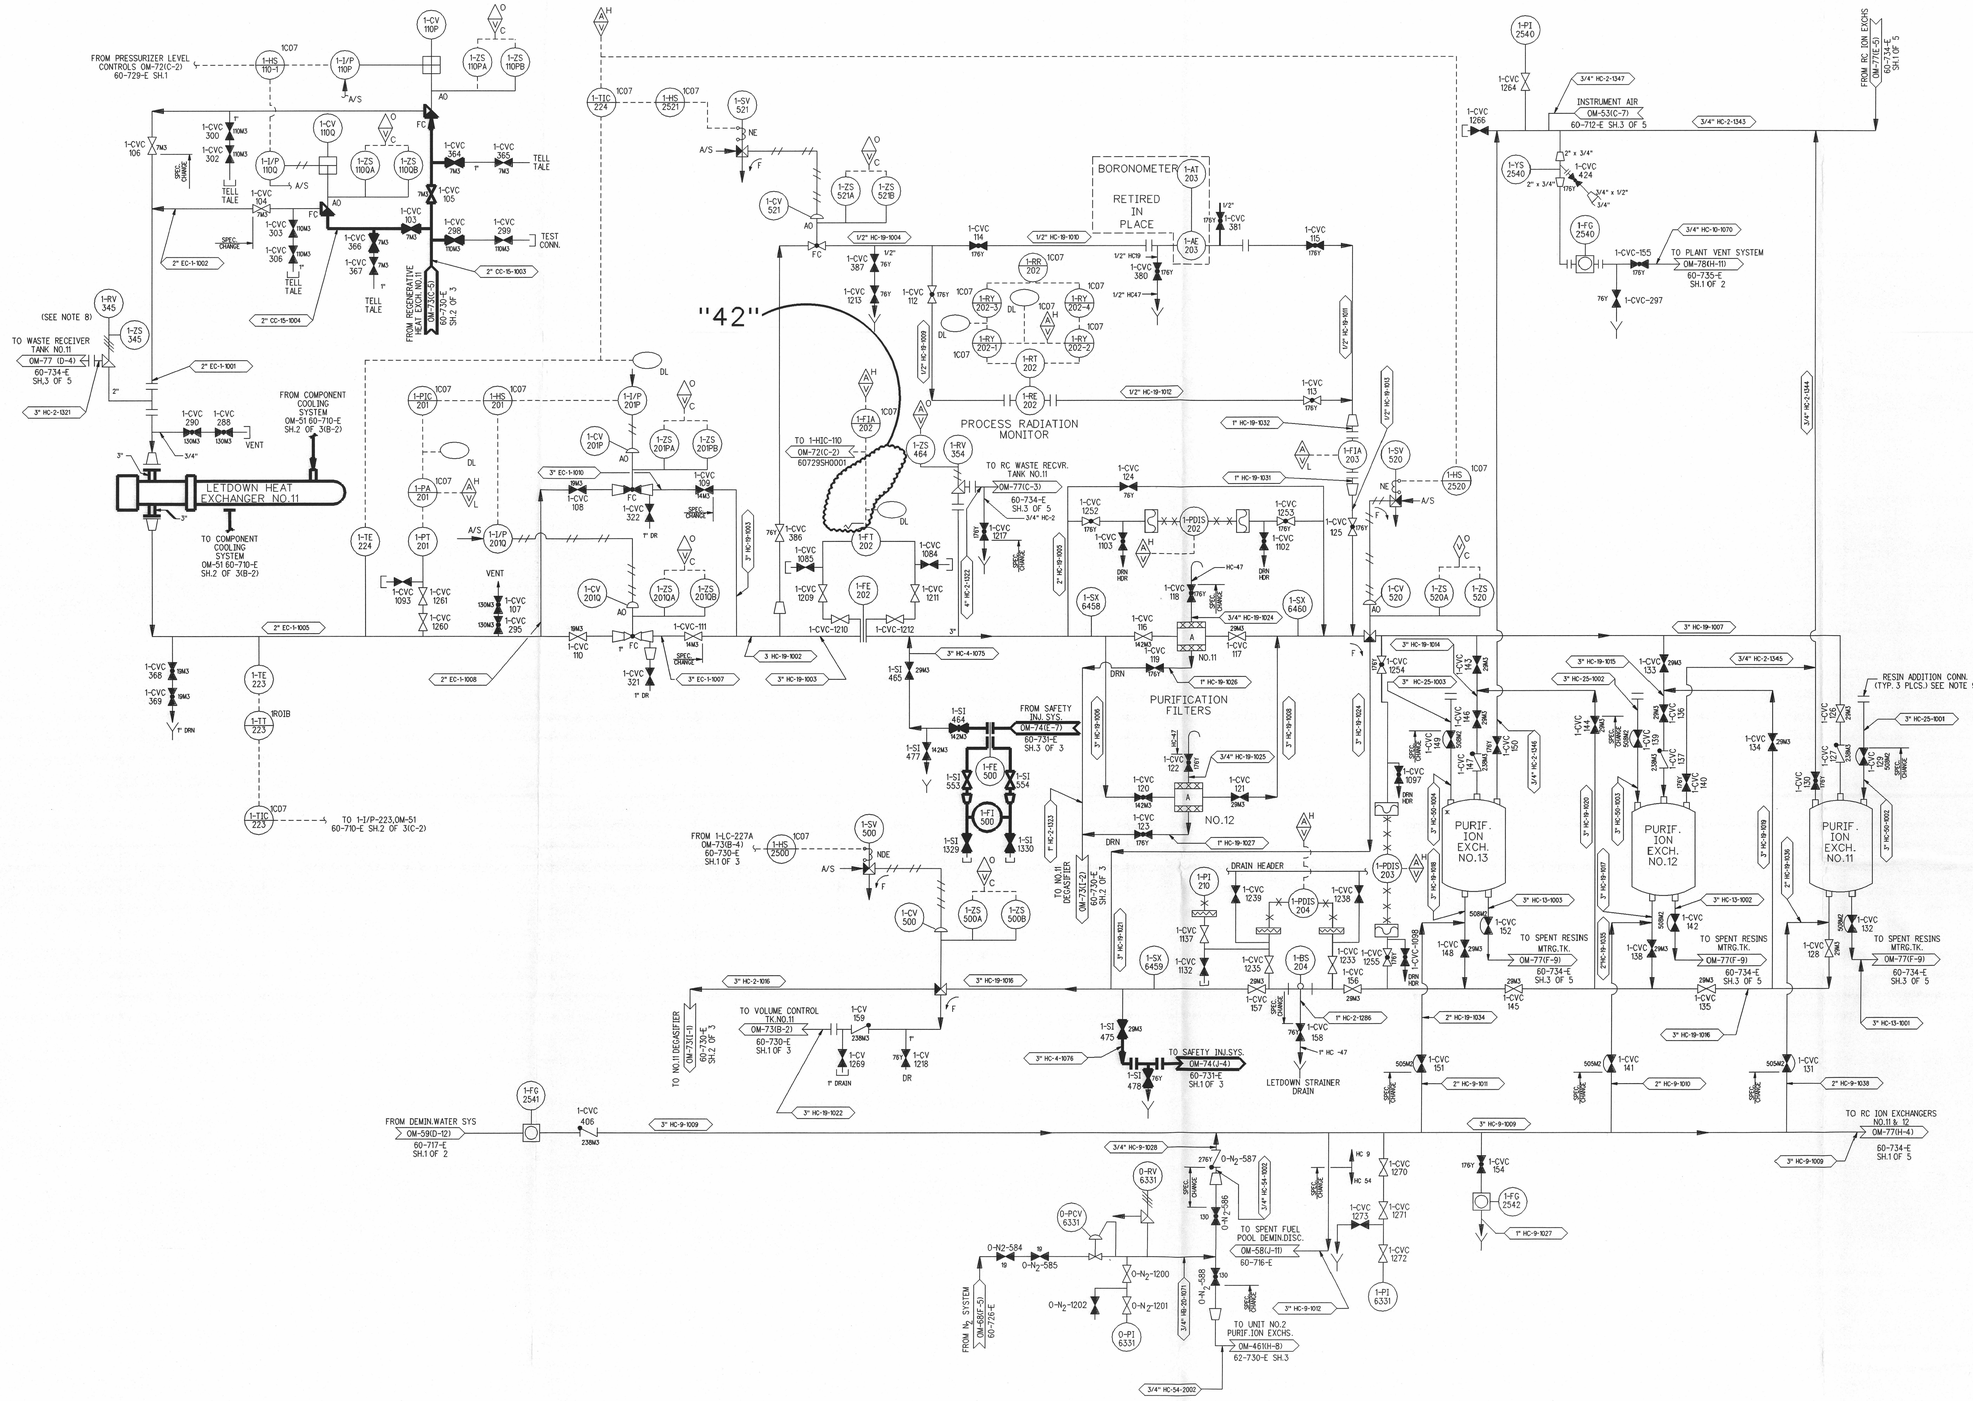

* FORMERLY TITLED DEBORONATING ION EXCHANGER

GENERAL NOTES:

1. FOR P & ID LEGEND SEE DRAWING 6750-M-80 (BG & E NO. 60-263-E).
2. FOR INSTRUMENT DATA SHEETS SEE DRAWING 6750-M-500 (BG & E NO.92-401-A THRU 92-422 B).
3. FOR EQUIPMENT LIST SEE DRAWING 6750-M-603 (BG & E 92-772-A).
4. EQUIPMENT NUMBERS FOR UNIT NO 1. ARE PREFIXED BY THE NUMBER 1 (EXAMPLE NO.11,12,13 ETC). EQUIPMENT NUMBERS FOR UNIT NO 2. ARE PREFIXED BY THE NUMBER 2 (EXAMPLE NO. 21,22,23 ETC). EQUIPMENT COMMON TO BOTH UNITS IS NUMBERED AS FOR UNIT 1.
5. THE Q-LIST INFORMATION PROVIDED ON THIS DRAWING IDENTIFIES THE SAFETY RELATED PRESSURE BOUNDARIES (SR-PB). EQUIPMENT WITHIN THE BOUNDARIES IS ALSO CLASSIFIED SR-PB, AS A MINIMUM. THE NUCLEIS MASTER EQUIPMENT LIST MUST BE USED FOR IDENTIFYING SPECIFIC OR ADDITIONAL SAFETY CLASSIFICATION INFORMATION, INCLUDING COMPONENT CLASSIFICATIONS AND ASSOCIATED REQUIREMENTS.
6. PIPING WHICH CONTINUES BEYOND THE SAFETY RELATED (SR-PB) BOUNDARY INDICATED ON THIS DRAWING, IS CLASSIFIED SR-PB UP TO AND INCLUDING THE FIRST SEISMIC ANCHOR.
7. ━━━━ DENOTES SAFETY RELATED PRESSURE BOUNDARIES.
   ─────── DENOTES NON-SAFETY RELATED PRESSURE BOUNDARIES.
8. FLANGES MAY BE ADDED TO THE INLET OF 1-RV-345.
9. FRESH RESIN IS TRANSFERRED VIA FLEXIBLE CONNECTION FROM A MOVABLE RESIN ADDITION TANK (ØTKRESINADD) THAT SERVICES BOTH UNITS. THE RESIN ADD. TANK IS CONNECTED TO THE DEMIN. WATER SYSTEM BY 1 OF 4 HOSE CONNECTIONS ON BGE. DWG. 60717SH0001 (C-10).

THIS DRAWING CREATED FROM OPERATIONS DRAWING 60-730-E SH.3 (OM-73), REV. 26, DATED 06-29-1994 & P&ID 60-256-E SH.3 (M-73), REV.19, DATED 03-12-1993.

REV	DATE	DESCRIPTION	DWN	DSGN	DE	IR	APPROVED
38		AS BUILT DCN 60730SH0003-2004SH0001 ES199900749-000					
39		AS BUILT INFO ONLY ES200000628-000					
40	7/20/01	AS BUILT DCN 60730SH0003-2005SH0001 ES199900907-000	JCH RKL	-	-	-	RKL
41	3/29/05	EDITORIAL CHANGE ONLY	WHR	-	-	-	
42	3/16/06	AS BUILT DCN 60730SH0003-2006SH0001 ES200200135-000	WHR	-	-	-	

CHEMICAL & VOLUME CONTROL SYSTEM

CALVERT CLIFFS NUCLEAR POWER PLANT
ENGINEERING SERVICES DEPARTMENT
CALVERT CLIFFS UNIT 1

SCALE:	VENDOR DWG. NO.	SIZE	CAT.	REV.
NONE	OM-073SH0003	E	C	42

DWG. NO. 60730SH0003

D-29