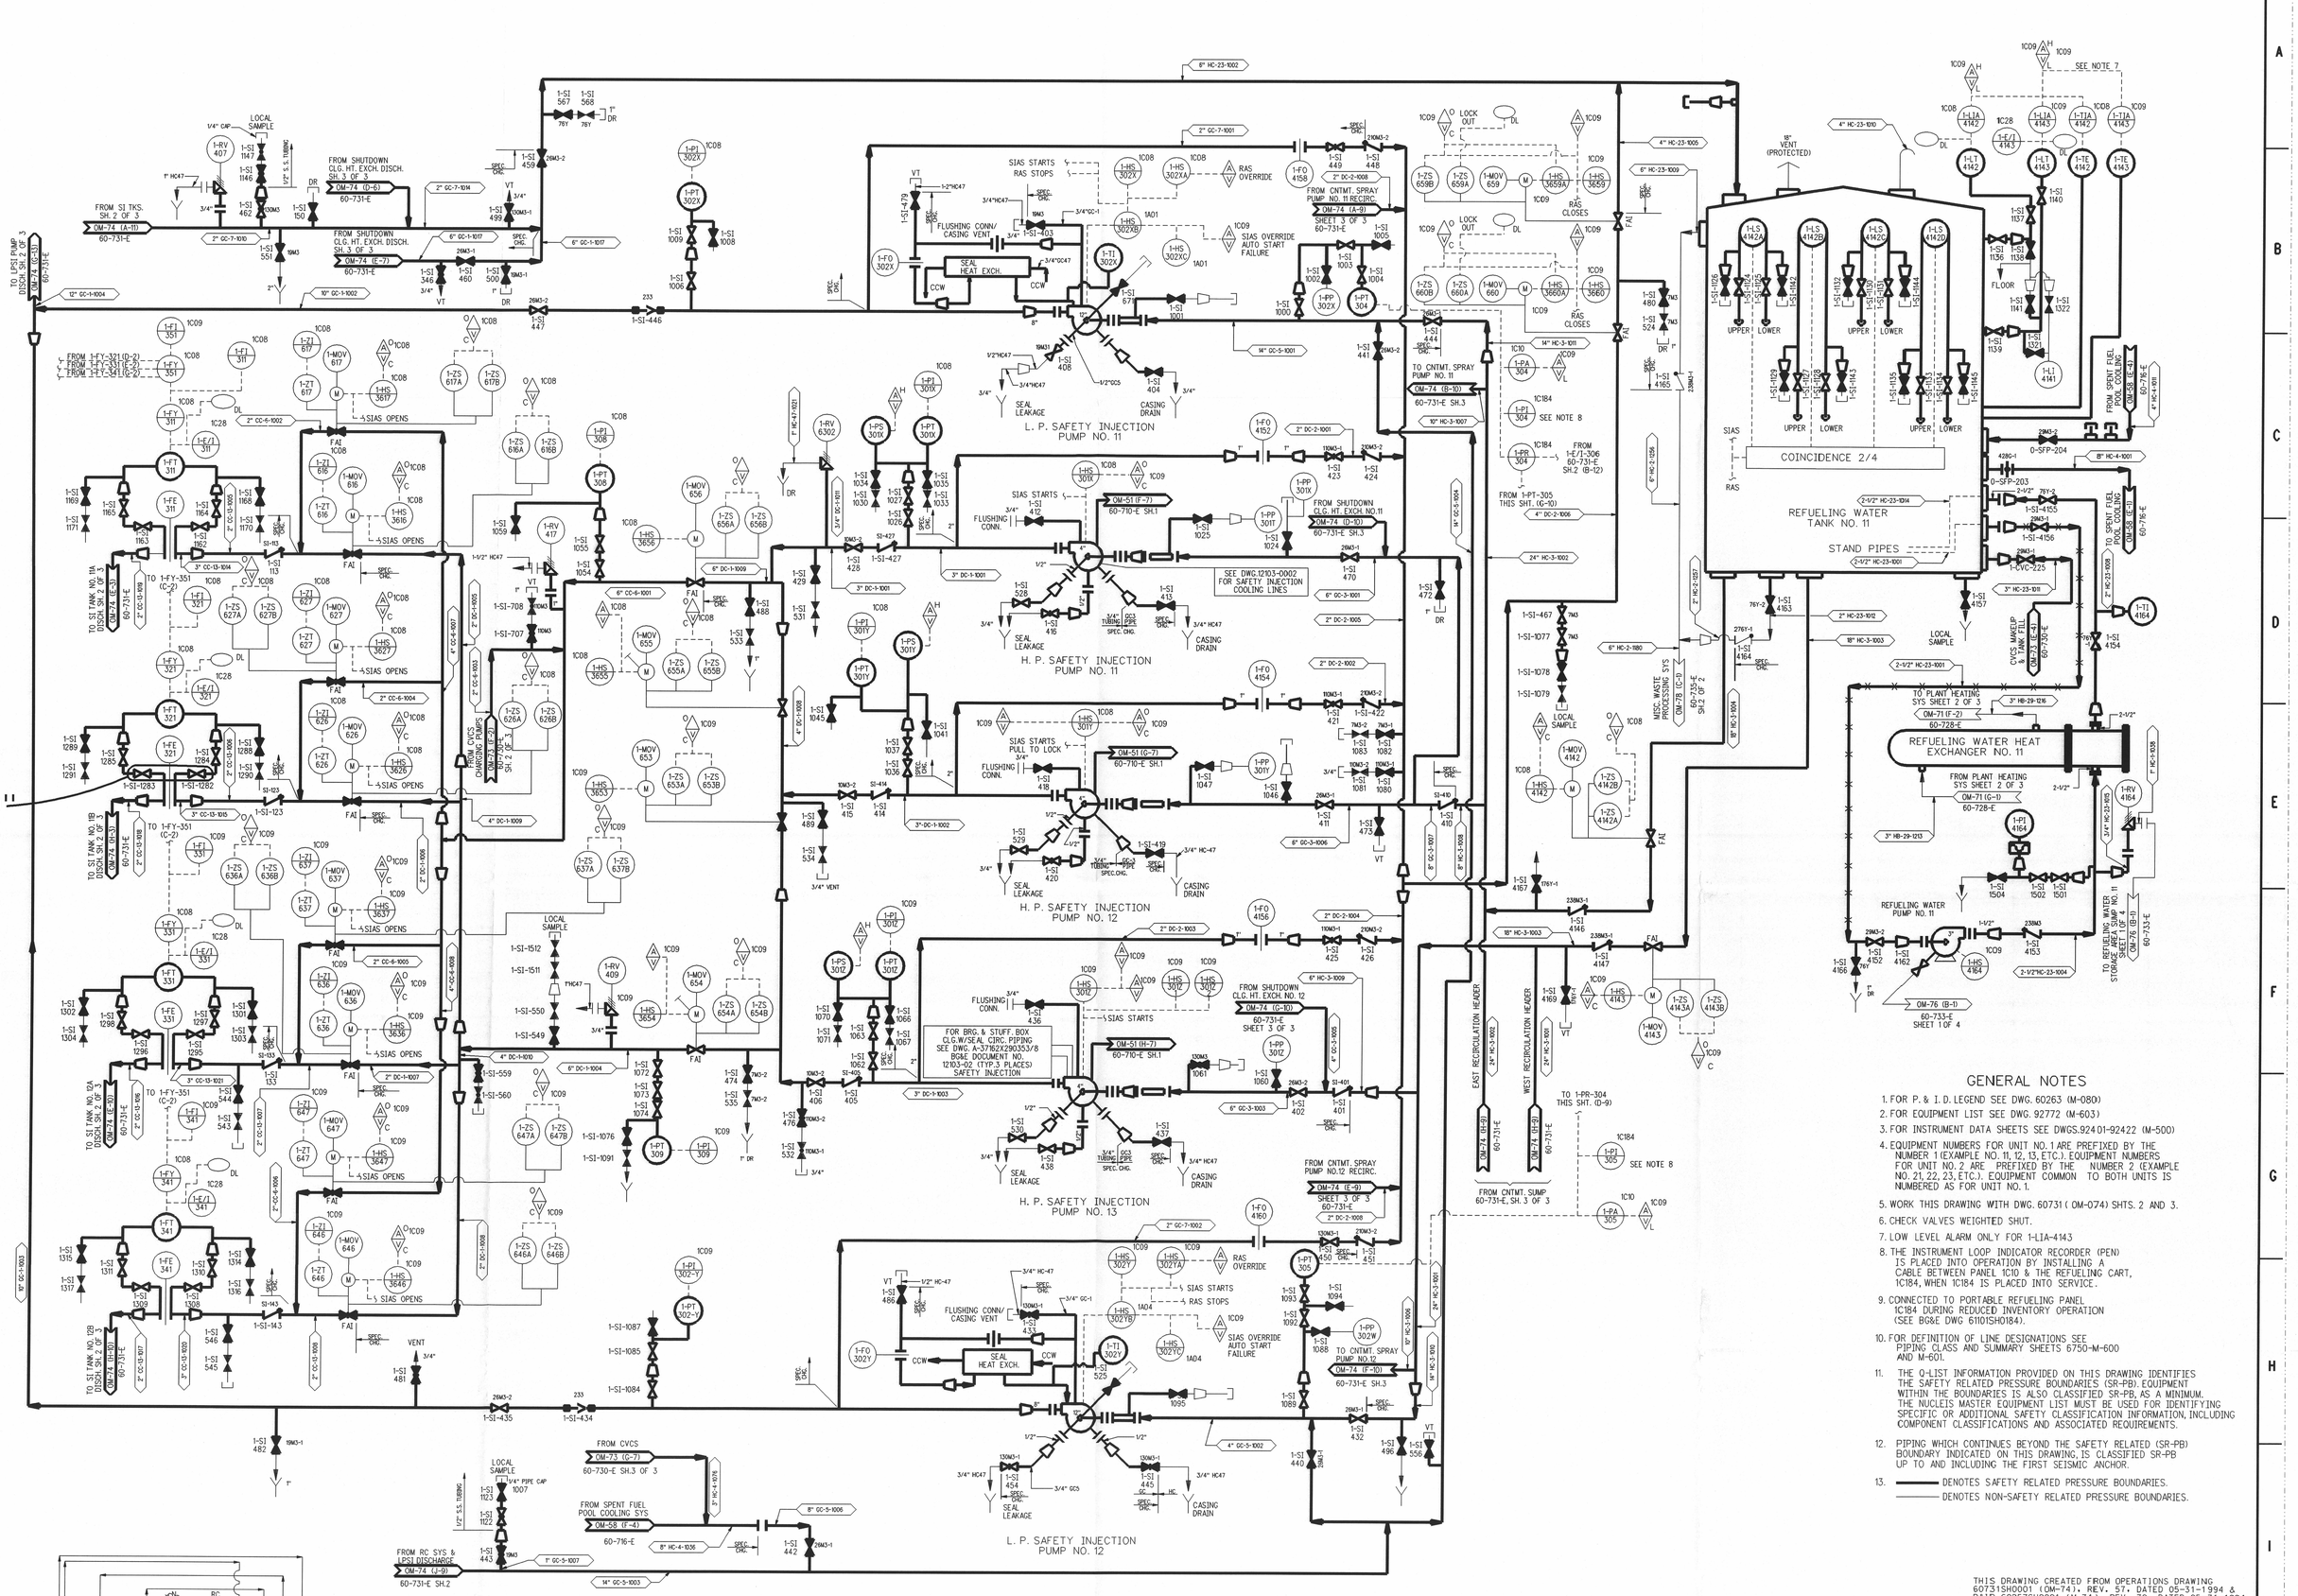

GENERAL NOTES

1. FOR P. & I. D. LEGEND SEE DWG. 60263 (M-080)
2. FOR EQUIPMENT LIST SEE DWG. 92772 (M-603)
3. FOR INSTRUMENT DATA SHEETS SEE DWGS.92401-92422 (M-500)
4. EQUIPMENT NUMBERS FOR UNIT NO. 1 ARE PREFIXED BY THE NUMBER 1 (EXAMPLE NO. 11, 12, 13, ETC.). EQUIPMENT NUMBERS FOR UNIT NO. 2 ARE PREFIXED BY THE NUMBER 2 (EXAMPLE NO. 21, 22, 23, ETC.). EQUIPMENT COMMON TO BOTH UNITS IS NUMBERED AS FOR UNIT NO. 1.
5. WORK THIS DRAWING WITH DWG. 60731 (OM-074) SHTS. 2 AND 3.
6. CHECK VALVES WEIGHTED SHUT.
7. LOW LEVEL ALARM ONLY FOR 1-LIA-4143
8. THE INSTRUMENT LOOP INDICATOR RECORDER (PEN) IS PLACED INTO OPERATION BY INSTALLING A CABLE BETWEEN PANEL 1C10 & THE REFUELING CART, 1C184, WHEN 1C184 IS PLACED INTO SERVICE.
9. CONNECTED TO PORTABLE REFUELING PANEL 1C184 DURING REDUCED INVENTORY OPERATION (SEE BG&E DWG 61101SH0184).
10. FOR DEFINITION OF LINE DESIGNATIONS SEE PIPING CLASS AND SUMMARY SHEETS 6750-M-600 AND M-601.
11. THE Q-LIST INFORMATION PROVIDED ON THIS DRAWING IDENTIFIES THE SAFETY RELATED PRESSURE BOUNDARIES (SR-PB). EQUIPMENT WITHIN THE BOUNDARIES IS ALSO CLASSIFIED SR-PB, AS A MINIMUM. THE NUCLEIS MASTER EQUIPMENT LIST MUST BE USED FOR IDENTIFYING SPECIFIC OR ADDITIONAL SAFETY CLASSIFICATION INFORMATION, INCLUDING COMPONENT CLASSIFICATIONS AND ASSOCIATED REQUIREMENTS.
12. PIPING WHICH CONTINUES BEYOND THE SAFETY RELATED (SR-PB) BOUNDARY INDICATED ON THIS DRAWING, IS CLASSIFIED SR-PB UP TO AND INCLUDING THE FIRST SEISMIC ANCHOR.
13. ——— DENOTES SAFETY RELATED PRESSURE BOUNDARIES.
    ——— DENOTES NON-SAFETY RELATED PRESSURE BOUNDARIES.

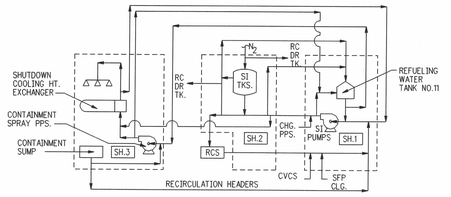

DRAWING LEGEND

THIS DRAWING CREATED FROM OPERATIONS DRAWING 60731SH0001 (OM-74), REV. 57, DATED 05-31-1994 & P&ID 60257SH0001 (M-74), REV. 70, DATED 05-31-1994.

REV	DATE	DESCRIPTION	DWN	DSGN	DE	IR	APPROVED
77	4/16/04	AS BUILT DCN 60731SH0001-2003SH0001, SH0003 ES199800942-000	WHR RKL	—	—	—	RKL
78	1/26/05	EDITORIAL CHANGE ONLY	WHR RKL	—	—	—	RKL
79	6/5/07	AS BUILT DCN 60731SH0001-2005SH0001 ES200600337-000	KWJ	—	—	—	KWJ

SAFETY INJECTION & CONTAINMENT SPRAY SYSTEMS

CALVERT CLIFFS NUCLEAR POWER PLANT
ENGINEERING SERVICES DEPARTMENT

CALVERT CLIFFS UNIT 1 — SIZE E — CAT. C

SCALE: NONE — VENDOR DWG. NO. OM-074SH0001 — REV.

DWG. NO. 60731SH0001 — 79

D-30