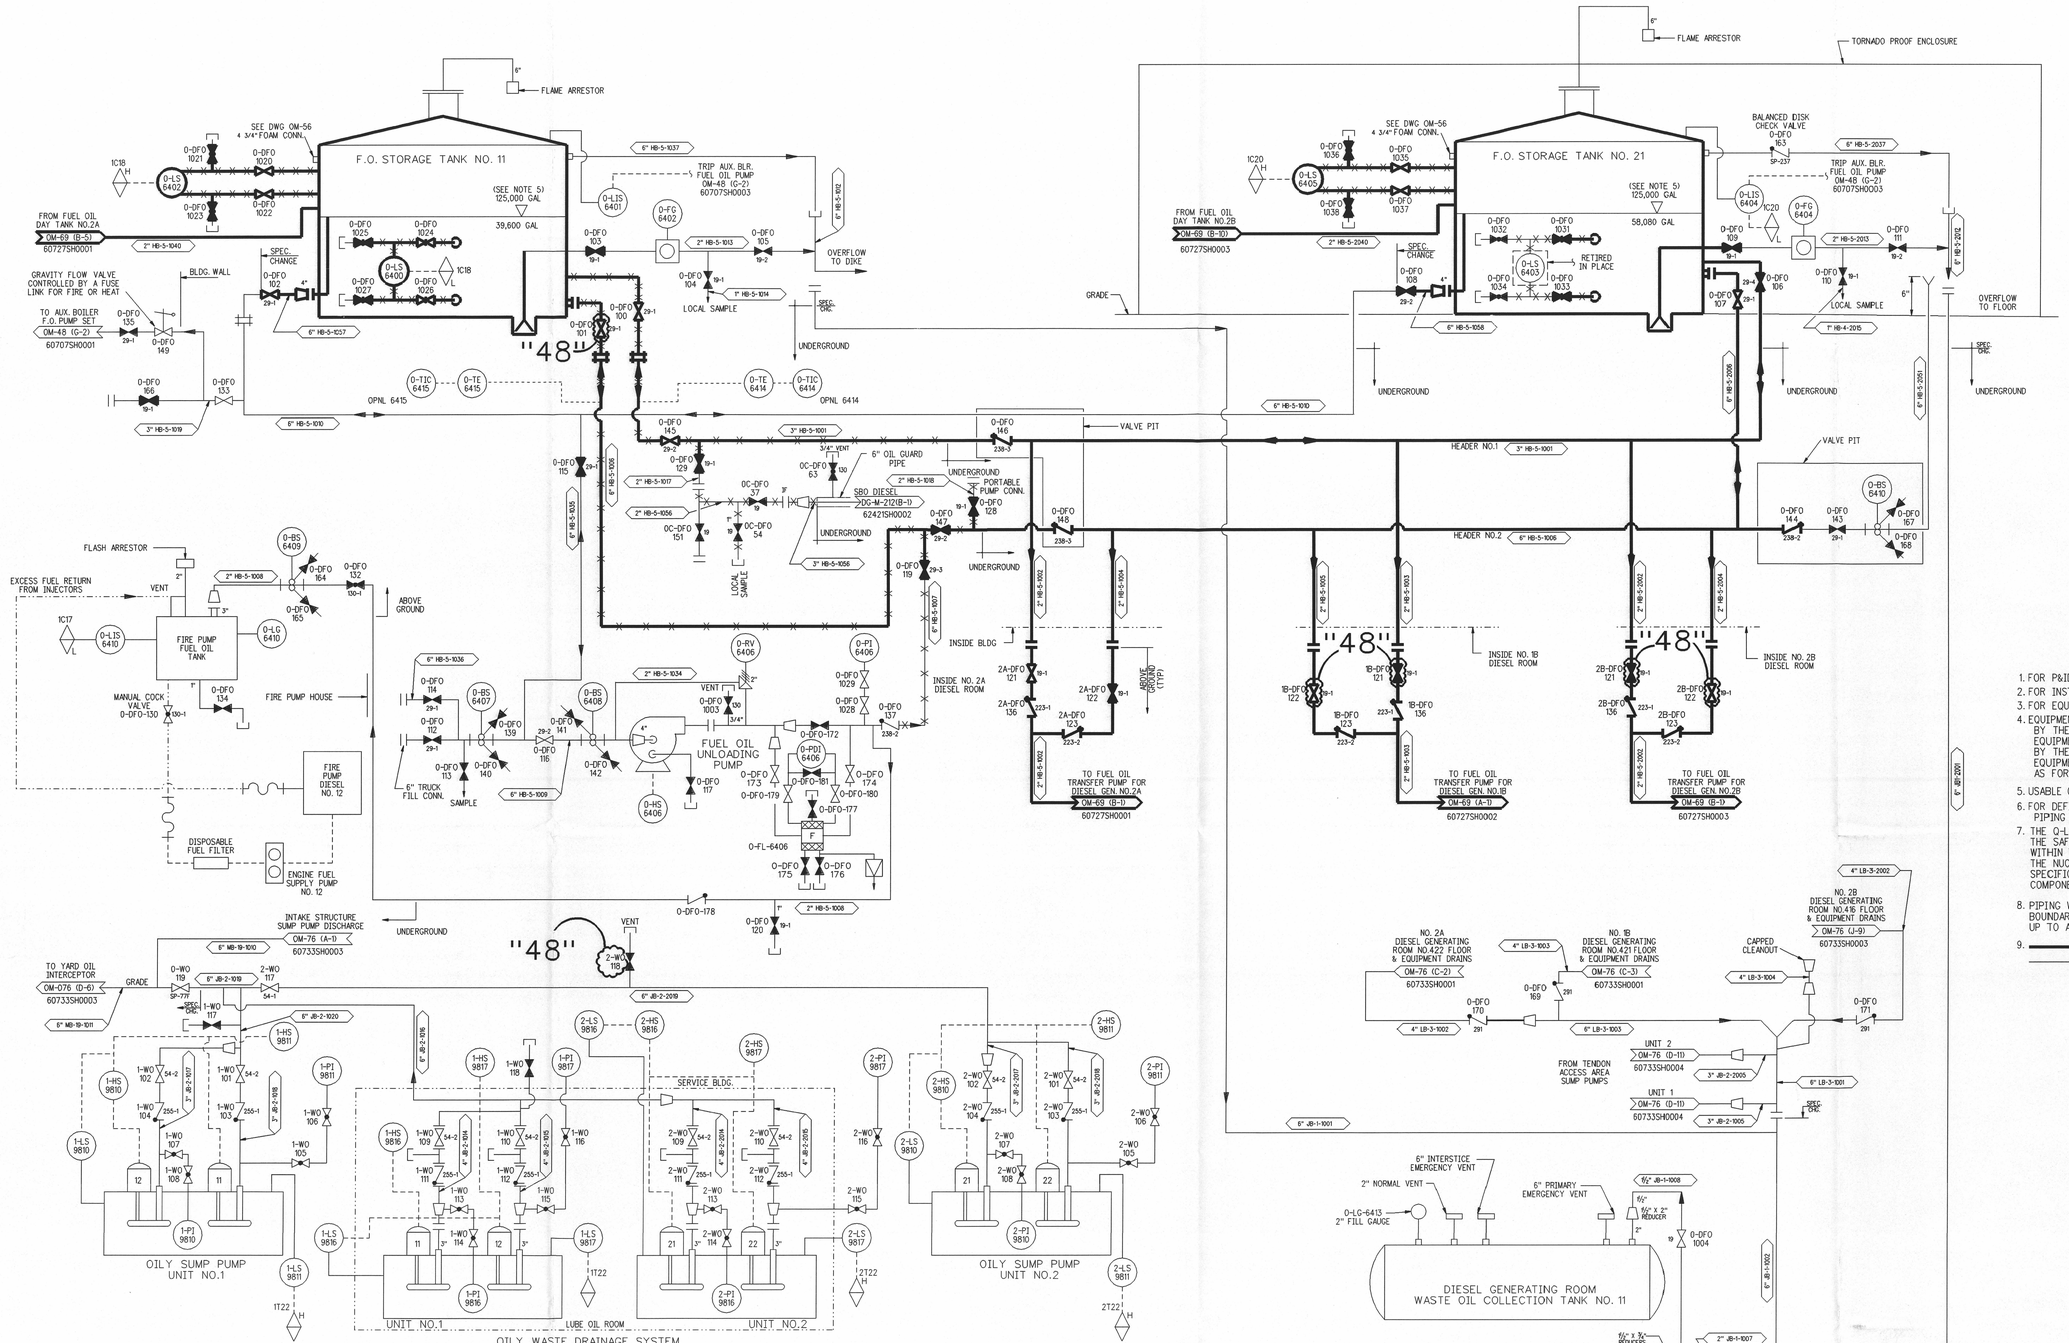

GENERAL NOTES

1. FOR P&ID LEGEND SEE DRAWING 6750-M-80 (60263)
2. FOR INSTRUMENT DATA SHEETS SEE 6750-M-500 (92401 - 92422).
3. FOR EQUIPMENT LIST SEE 6750-M-603 (92772).
4. EQUIPMENT NUMBERS FOR UNIT NO.1 ARE PREFIXED BY THE NUMBER 1 (EX. 11,12,13 ETC.). EQUIPMENT NUMBERS FOR UNIT NO.2 ARE PREFIXED BY THE NUMBER 2 (EX. 21,22,23 ETC.). EQUIPMENT COMMON TO BOTH UNITS IS NUMBERED AS FOR UNIT NO. 1.
5. USABLE CAPACITY 109,500 GALS.
6. FOR DEFINITION OF LINE DESIGNATIONS PIPING CLASS AND SUMMARY SHEETS 6750-M-600 & 601.
7. THE Q-LIST INFORMATION PROVIDED ON THIS DRAWING IDENTIFIES THE SAFETY RELATED PRESSURE BOUNDARIES (SR-PB). EQUIPMENT WITHIN THE BOUNDARIES IS ALSO CLASSIFIED SR-PB, AS A MINIMUM. THE NUCLEIS MASTER EQUIPMENT LIST MUST BE USED FOR IDENTIFYING SPECIFIC OR ADDITIONAL SAFETY CLASSIFICATION INFORMATION, INCLUDING COMPONENT CLASSIFICATIONS AND ASSOCIATED REQUIREMENTS.
8. PIPING WHICH CONTINUES BEYOND THE SAFETY RELATED (SR-PB) BOUNDARY INDICATED ON THIS DRAWING, IS CLASSIFIED SR-PB UP TO AND INCLUDING THE FIRST SEISMIC ANCHOR.
9. ▬▬ DENOTES SAFETY RELATED PRESSURE BOUNDARIES.
   ▬▬ DENOTES NON-SAFETY RELATED PRESSURE BOUNDARIES.

THIS DRAWING CREATED FROM OPERATIONS DRAWING 60736 (OM-79), REV. 26, DATED 12-14-1993 & P&ID 60262 (M-79), REV. 27, DATED 12-14-1993.

REV	DATE	DESCRIPTION	DWN	DSGN	DE	IR	APPROVED
45	3/14/99	AS BUILT INFO ONLY ESP ES199900132-000	S.F. WHR	—	—	—	JM
46	4/24/02	AS BUILT INFO ONLY ES200200014-000	JCH RKL	—	—	—	RKL
47	6/9/04	ADMIN CHANGE ONLY	WHR RKL	—	—	—	RKL
48	8/17/04	AS BUILT DCN 60736SH0001-2004SH0001 & 2005SH0001 ES199701471-000 & ES200200817-000	WHR RKL	—	—	—	RKL

FUEL OIL STORAGE SYSTEM

CALVERT CLIFFS NUCLEAR POWER PLANT
ENGINEERING SERVICES DEPARTMENT
CALVERT CLIFFS UNIT 1&2

SIZE E | CAT. C

SCALE: NONE | VENDOR DWG. NO. OM-079SH0001 | REV. 48

DWG. NO. 60736SH0001