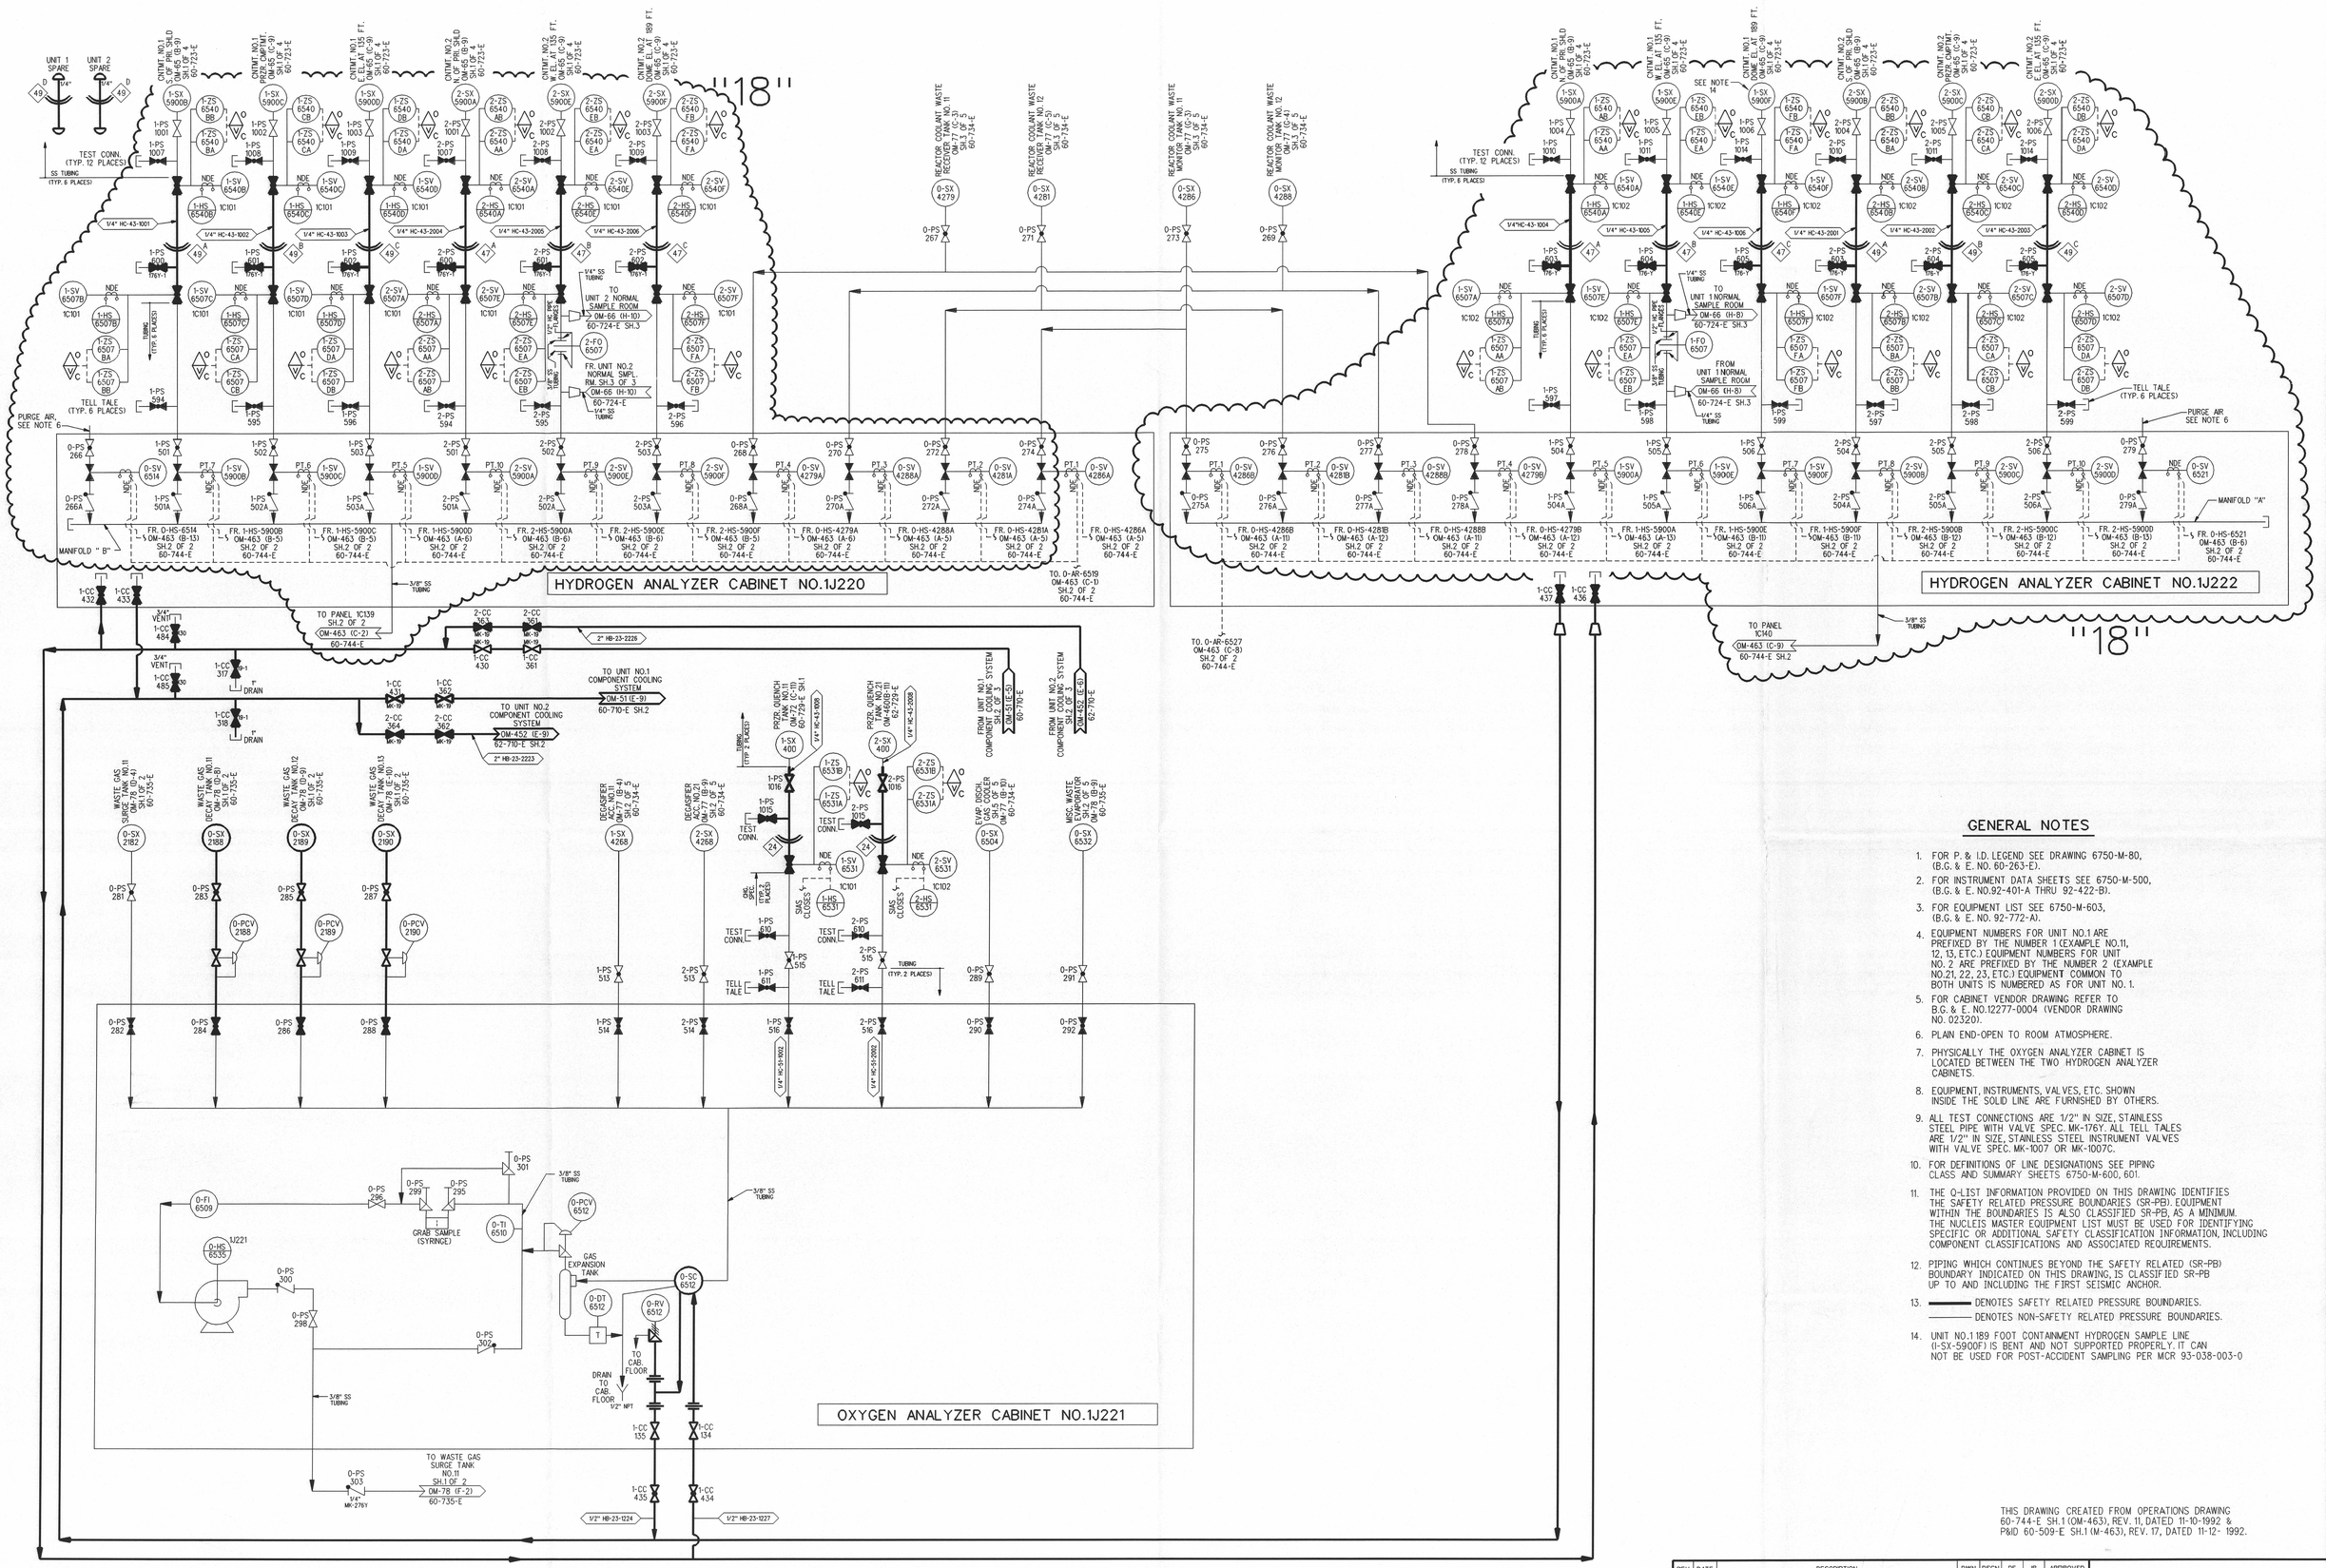


## GENERAL NOTES

1. FOR P. & I.D. LEGEND SEE DRAWING 6750-M-80, (B.G. & E. NO. 60-263-E).
2. FOR INSTRUMENT DATA SHEETS SEE 6750-M-500, (B.G. & E. NO.92-401-A THRU 92-422-B).
3. FOR EQUIPMENT LIST SEE 6750-M-603, (B.G. & E. NO. 92-772-A).
4. EQUIPMENT NUMBERS FOR UNIT NO.1 ARE PREFIXED BY THE NUMBER 1 (EXAMPLE NO.11, 12, 13, ETC.) EQUIPMENT NUMBERS FOR UNIT NO. 2 ARE PREFIXED BY THE NUMBER 2 (EXAMPLE NO.21, 22, 23, ETC.) EQUIPMENT COMMON TO BOTH UNITS IS NUMBERED AS FOR UNIT NO. 1.
5. FOR CABINET VENDOR DRAWING REFER TO B.G. & E. NO.12277-0004 (VENDOR DRAWING NO. 02320).
6. PLAIN END-OPEN TO ROOM ATMOSPHERE.
7. PHYSICALLY THE OXYGEN ANALYZER CABINET IS LOCATED BETWEEN THE TWO HYDROGEN ANALYZER CABINETS.
8. EQUIPMENT, INSTRUMENTS, VALVES, ETC. SHOWN INSIDE THE SOLID LINE ARE FURNISHED BY OTHERS.
9. ALL TEST CONNECTIONS ARE 1/2" IN SIZE, STAINLESS STEEL PIPE WITH VALVE SPEC. MK-176Y. ALL TELL TALES ARE 1/2" IN SIZE, STAINLESS STEEL INSTRUMENT VALVES WITH VALVE SPEC. MK-1007 OR MK-1007C.
10. FOR DEFINITIONS OF LINE DESIGNATIONS SEE PIPING CLASS AND SUMMARY SHEETS 6750-M-600, 601.
11. THE Q-LIST INFORMATION PROVIDED ON THIS DRAWING IDENTIFIES THE SAFETY RELATED PRESSURE BOUNDARIES (SR-PB). EQUIPMENT WITHIN THE BOUNDARIES IS ALSO CLASSIFIED SR-PB, AS A MINIMUM. THE NUCLEIS MASTER EQUIPMENT LIST MUST BE USED FOR IDENTIFYING SPECIFIC OR ADDITIONAL SAFETY CLASSIFICATION INFORMATION, INCLUDING COMPONENT CLASSIFICATIONS AND ASSOCIATED REQUIREMENTS.
12. PIPING WHICH CONTINUES BEYOND THE SAFETY RELATED (SR-PB) BOUNDARY INDICATED ON THIS DRAWING, IS CLASSIFIED SR-PB UP TO AND INCLUDING THE FIRST SEISMIC ANCHOR.
13. ——— DENOTES SAFETY RELATED PRESSURE BOUNDARIES.
    ——— DENOTES NON-SAFETY RELATED PRESSURE BOUNDARIES.
14. UNIT NO.1 189 FOOT CONTAINMENT HYDROGEN SAMPLE LINE (I-SX-5900F) IS BENT AND NOT SUPPORTED PROPERLY. IT CAN NOT BE USED FOR POST-ACCIDENT SAMPLING PER MCR 93-038-003-0

THIS DRAWING CREATED FROM OPERATIONS DRAWING 60-744-E SH.1 (OM-463), REV. 11, DATED 11-10-1992 & P&ID 60-509-E SH.1 (M-463), REV. 17, DATED 11-12- 1992.

| REV | DATE | DESCRIPTION | DWN | DSGN | DE | IR | APPROVED |
|---|---|---|---|---|---|---|---|
| 13 | | AS BUILT INFO ONLY ESP ES199500013 | | | | | |
| 14 | | AS BUILT INFO ONLY ESP ES199601588 | | | | | |
| 15 | | AS BUILT DCN 60744SH0001-0001SH0001 MCR 93-038-003-0 | | | | | |
| 16 | | AS BUILT INFO ONLY ESP ES199601152-000 | | | | | |
| 17 | 6/24/99 | AS BUILT INFO ONLY ESP ES199900632 | R | — | — | — | JPM |
| 18 | 9/29/06 | AS BUILT DCN 60744SH0001-2001SH0001 ES200400429-000 | JB 9/26/06 | — | — | — | RJH |

GAS ANALYZING SYSTEM

CALVERT CLIFFS NUCLEAR POWER PLANT
ENGINEERING SERVICES DEPARTMENT
CALVERT CLIFFS UNIT 1&2

SIZE E | CAT. C | REV. 18

SCALE: NONE | VENDOR DWG. NO. OM-463SH0001

DWG. NO. 60744SH0001

D-41