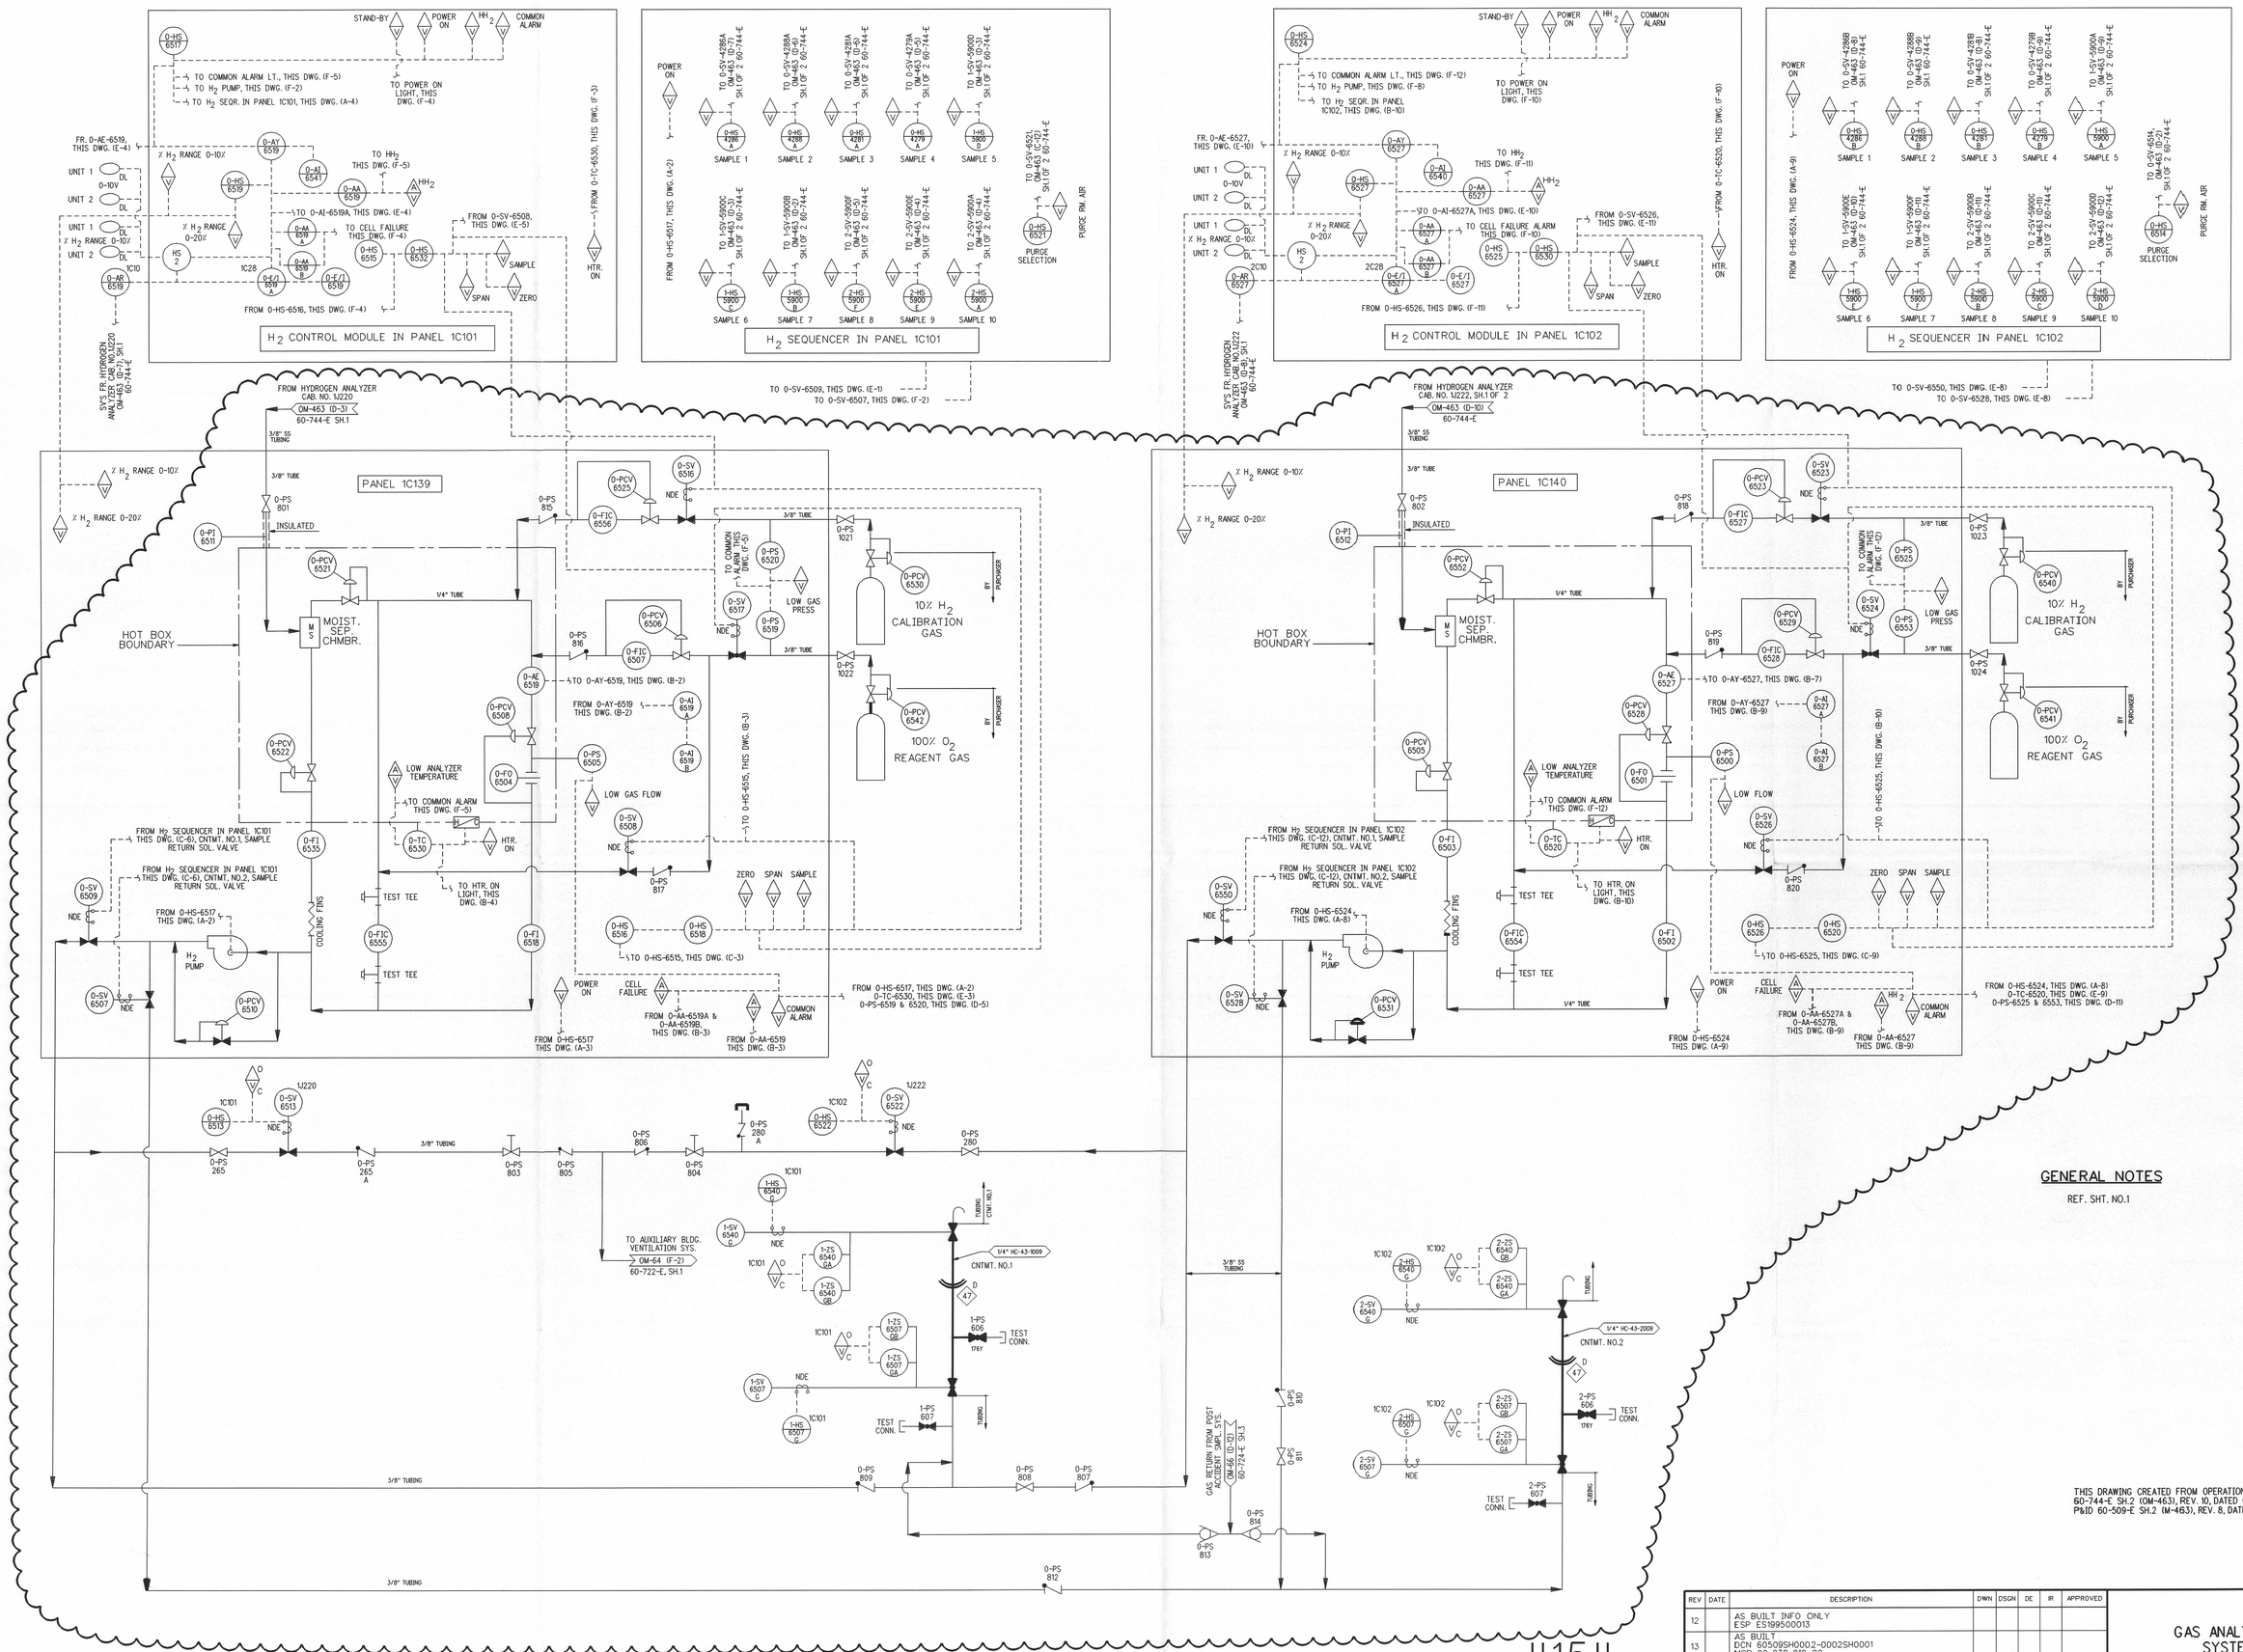

GENERAL NOTES

REF. SHT. NO.1

THIS DRAWING CREATED FROM OPERATIONS DRAWING 60-744-E SH.2 (OM-463), REV. 10, DATED 01-11-1993 & P&ID 60-509-E SH.2 (M-463), REV. 8, DATED 02-03-1993.

REV	DATE	DESCRIPTION	DWN	DSGN	DE	IR	APPROVED
12		AS BUILT INFO ONLY ESP ES199500013					
13		AS BUILT DCN 60509SH0002-0002SH0001 MCR 92-038-010-02					
14	10/14/98	AS BUILT DCN 60744SH0002-2001SH0001 ES199501310-004	MVR SF	—	—	—	JPM
15	9/28/04	AS BUILT DCN 60744SH0002-2002SH0001 REV. A ES200400429-000	[illegible]	—	—	—	[illegible]

GAS ANALYZING SYSTEM

CALVERT CLIFFS NUCLEAR POWER PLANT
ENGINEERING SERVICES DEPARTMENT
CALVERT CLIFFS UNIT 1&2 | SIZE E | CAT. C
SCALE: NONE | VENDOR DWG. NO. OM-463SH0002 | REV. 15
DWG. NO. 60744SH0002

D-42